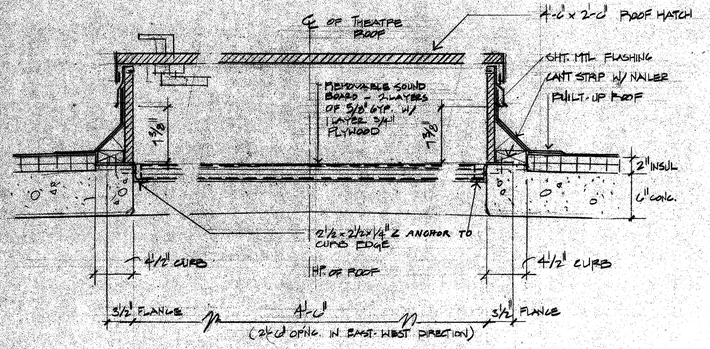

7 **DETAIL** 1 1/2"=1'-0"

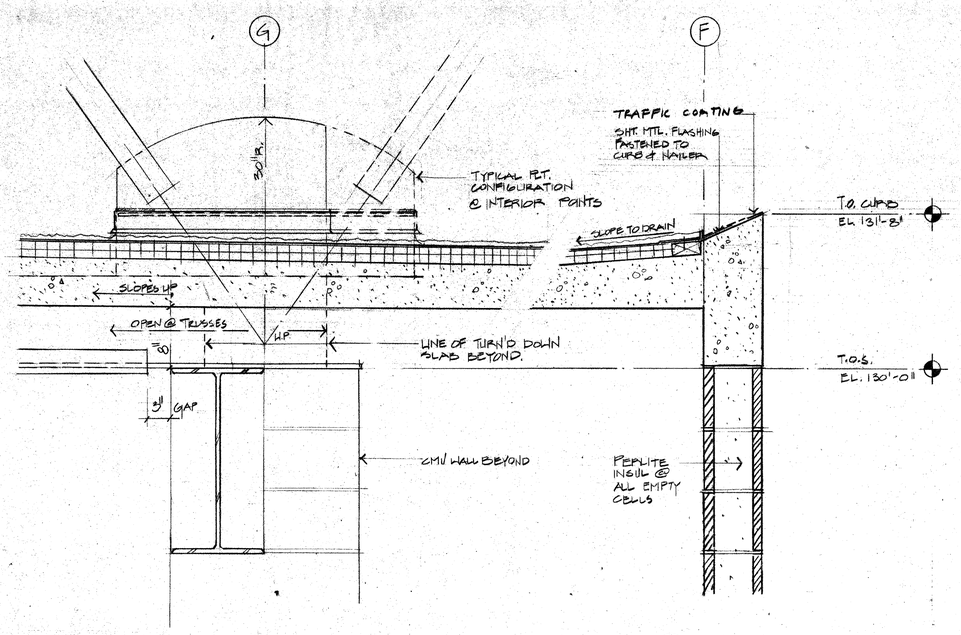

6 **DETAIL** 1 1/2"=1'-0"

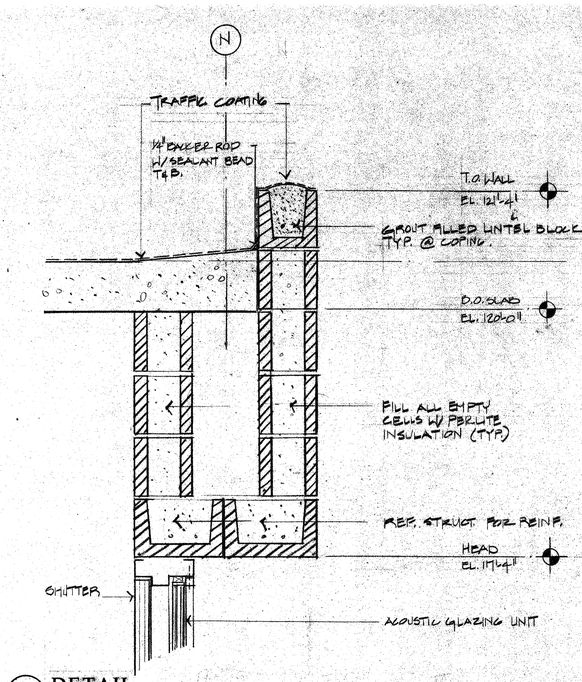

5 **DETAIL** 1 1/2"=1'-0"

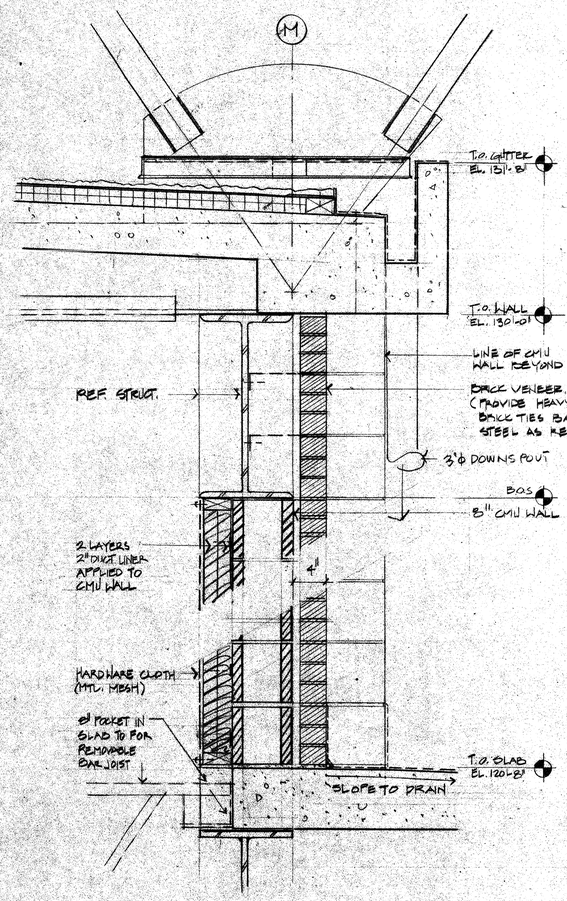

4 **DETAIL** 1/2" = 1'-0"

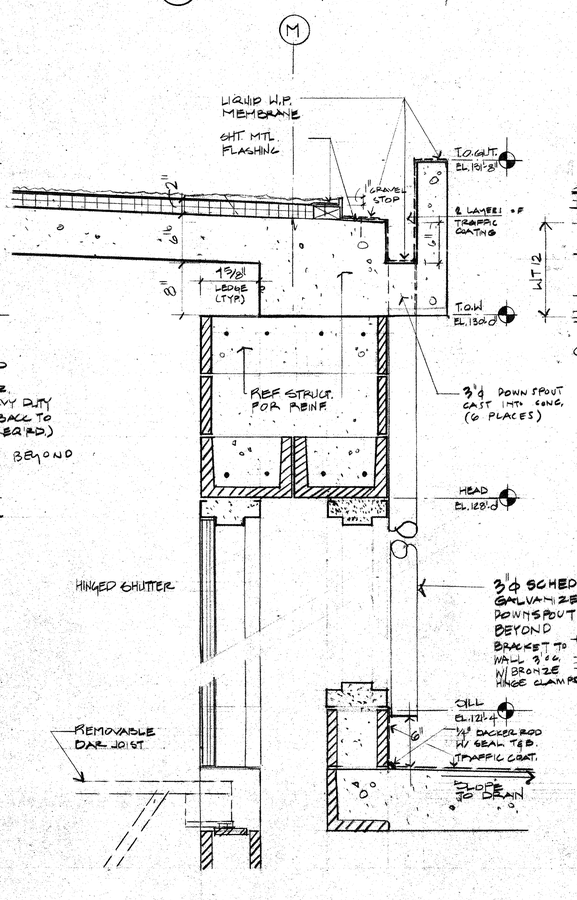

3 **DETAIL** 1 1/2"=1'-0"

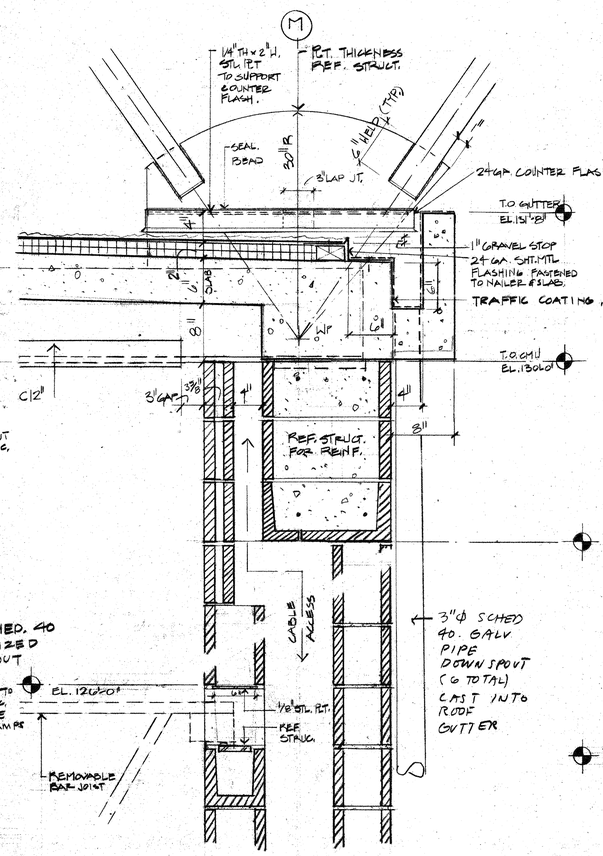

2 **DETAIL** 1 1/2"=1'-0"

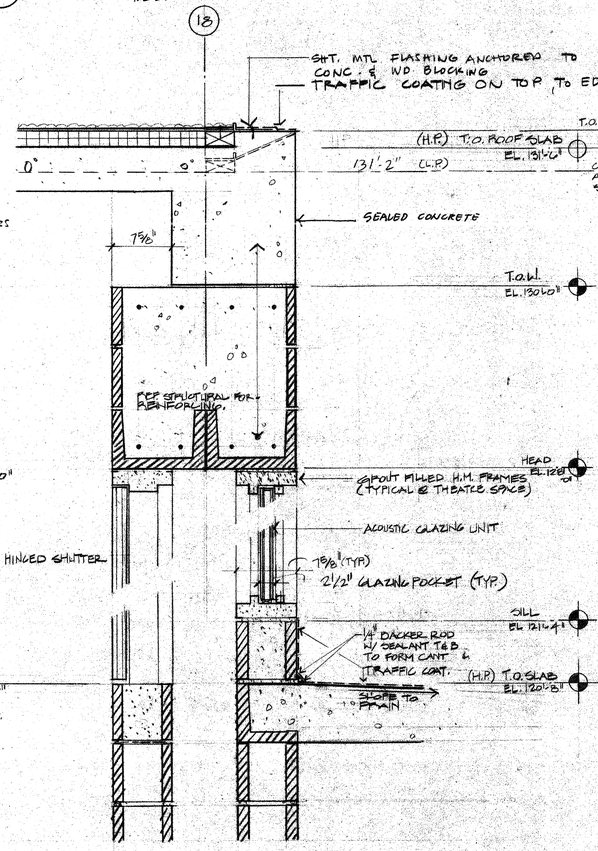

1 **DETAIL** 1 1/2"=1'-0"

REGISTERED ARCHITECT STATE OF TEXAS NO. 08219

ACC · ACT

ADDISON

OWNER **Town of Addison**	LANDSCAPE The Kellams Group 317-776-1417	STRUCTURAL Ellisor Tanner 214-367-8383	HISTORIAN Alan Maxon 214-891-7182
ARCHITECT **Cunningham Architects** 2700 Fairmount Dallas, Texas 75201 214-855-5272	THEATRE CONSULTANT Theater Projects 203-431-3949	M.E.P. MEP Systems 214-754-4741	LIGHTING Pamela Hull Wilson 214-823-6542
	INTERIORS CRSS 713-552-2000	CIVIL Kurtz & Associates 214-680-3322	GRAPHICS Nottestad Design 214-954-1978

Issue	Category	Subcategory	Sheet
ISSUE FOR BID 8-17-90	4	9	13