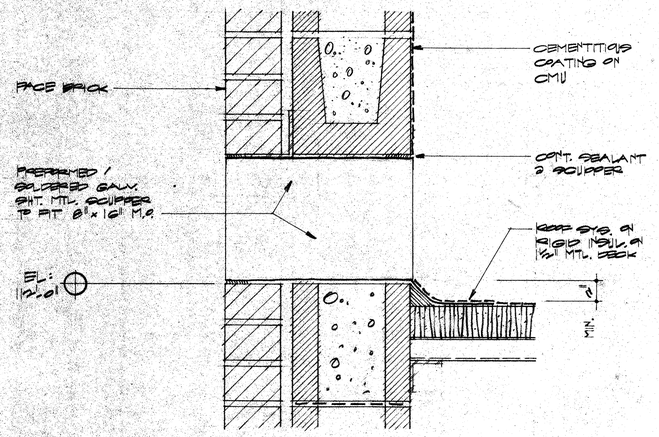

7 DETAIL
3/4" = 1'-0"

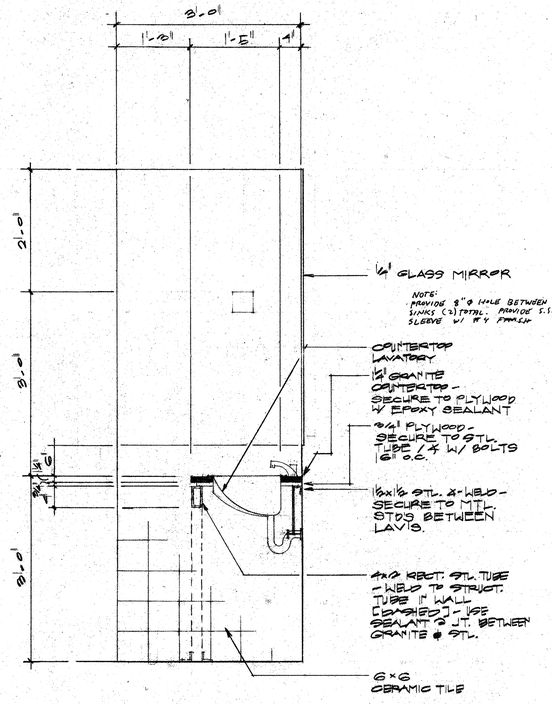

6 DETAIL
1" = 1'-0"

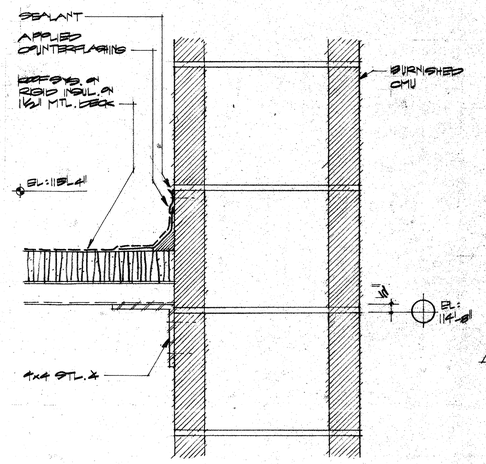

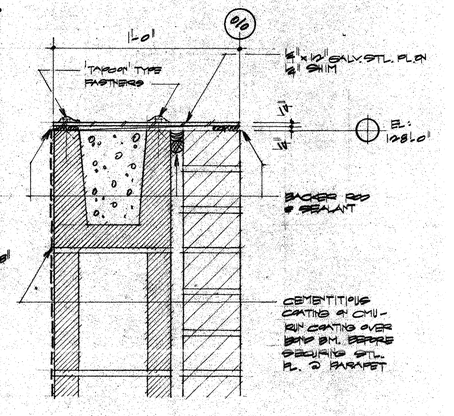

5 DETAIL
3/4" = 1'-0"

4 DETAIL
3/4" = 1'-0"

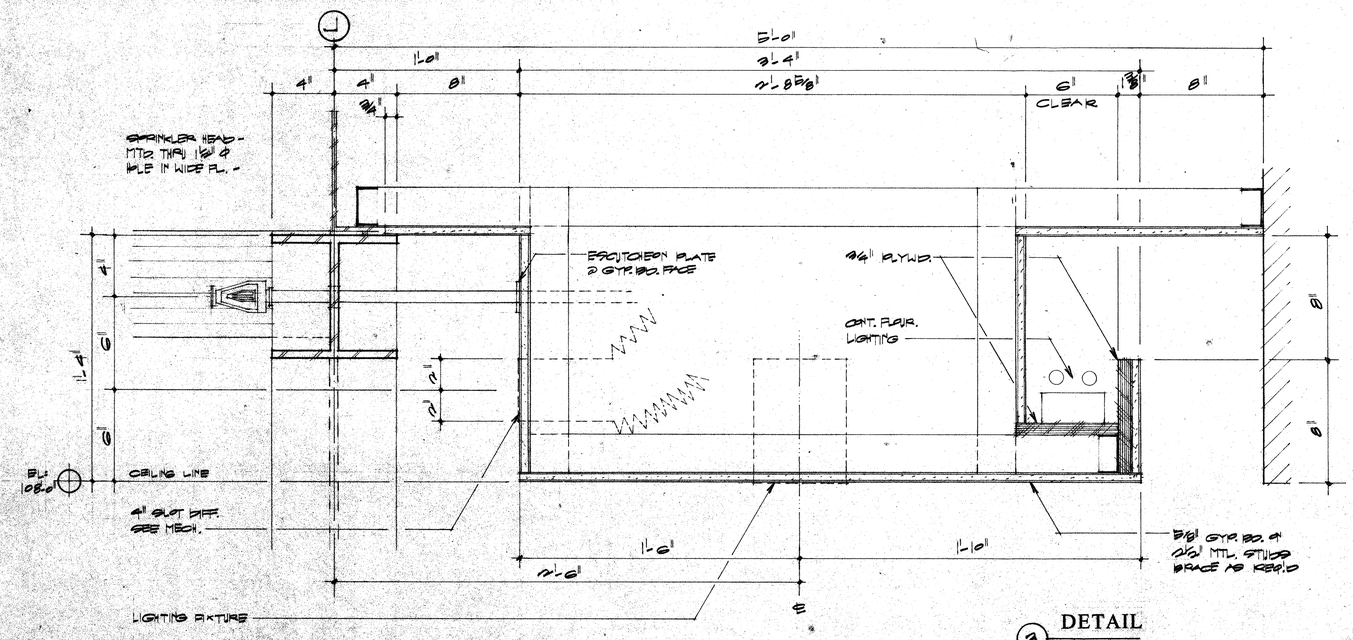

3 DETAIL
3/4" = 1'-0"

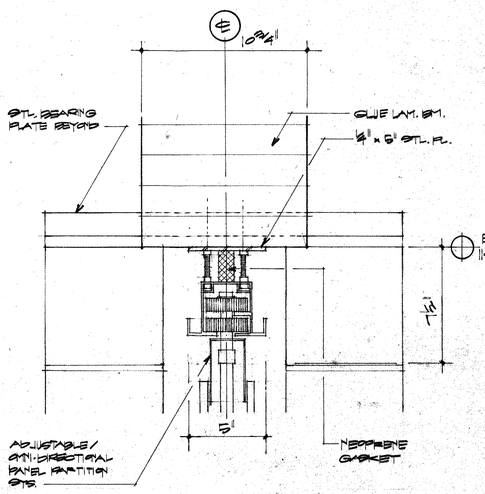

2 DETAIL
3/4" = 1'-0"

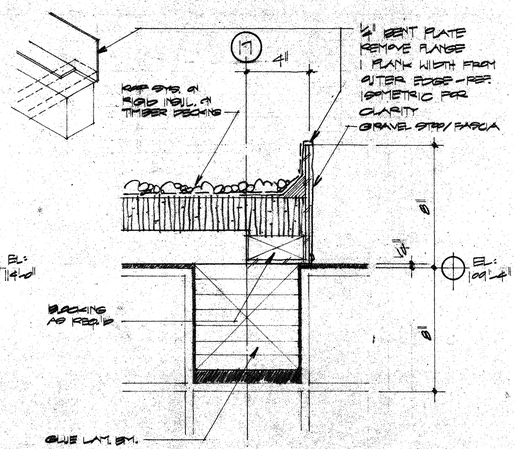

1 DETAIL
3/4" = 1'-0"

REGISTERED ARCHITECT STATE OF TEXAS NO. 08219

ACC · ACT

ADDISON

OWNER **Town of Addison**	LANDSCAPE The Kellams Group 317-776-1417	STRUCTURAL Elliser Tesner 214-361-8383	HISTORIAN Allen Maxson 214-699-7782
ARCHITECT **Cunningham Architects** 2700 Fairmount Dallas, Texas 75201 214-855-5272	THEATRE CONSULTANT Theatre Projects 203-431-3949	M.E.P. MEP Systems 214-754-4741	LIGHTING Pamela Hull Wilson 214-823-8542
	INTERIORS CRSS 713-552-2500	CIVIL Kartz & Associates 214-680-3322	GRAPHICS Nortelstad Design 214-954-1978

Issue	Category	Subcategory	Sheet
ISSUE FOR BID 8-17-90	4	9	4

C