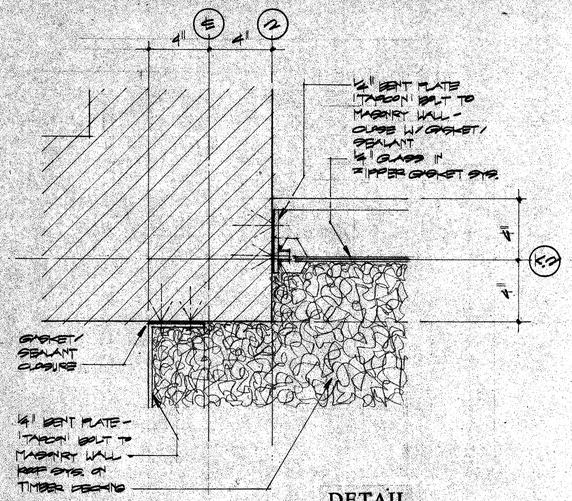

12 DETAIL 3"=1'-0"

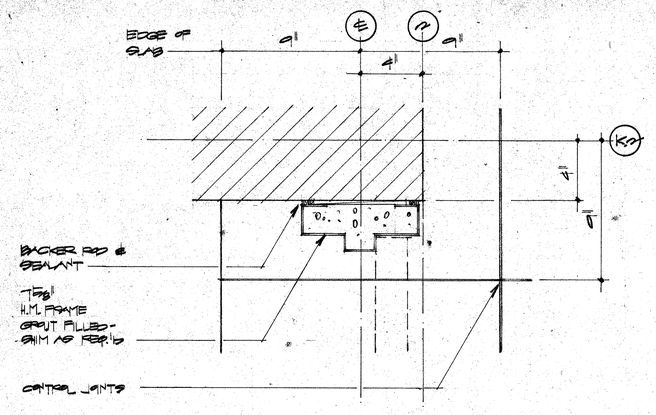

11 DETAIL 3"=1'-0"

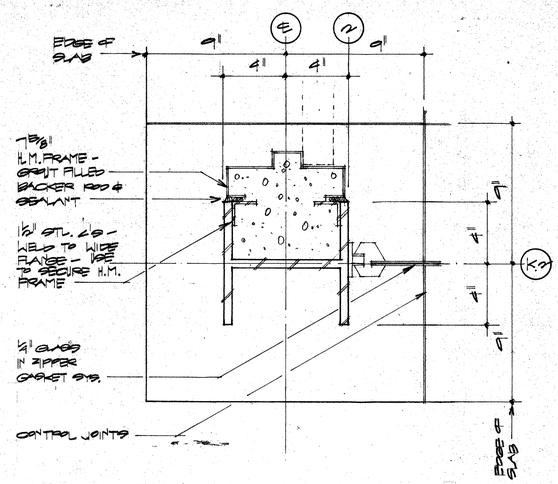

10 DETAIL 3"=1'-0"

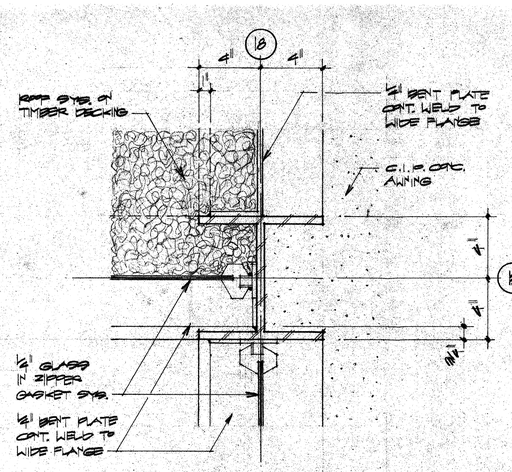

9 DETAIL 3"=1'-0"

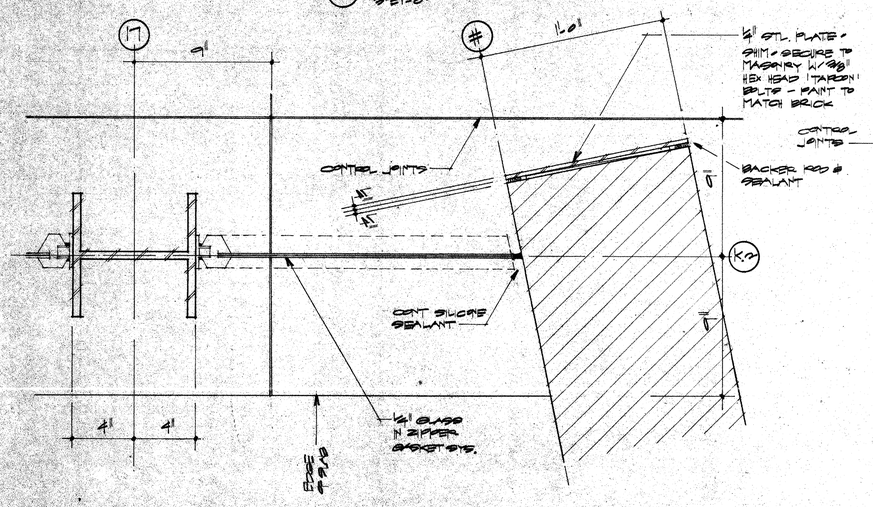

8 DETAIL 3"=1'-0"

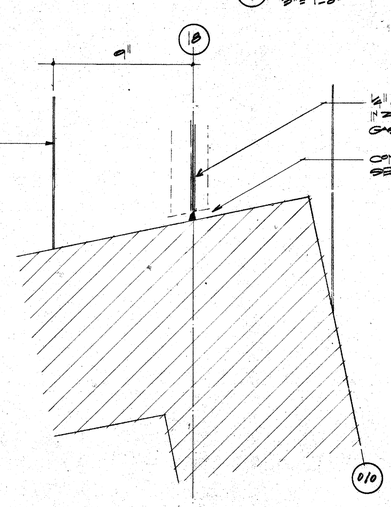

7 DETAIL 3"=1'-0"

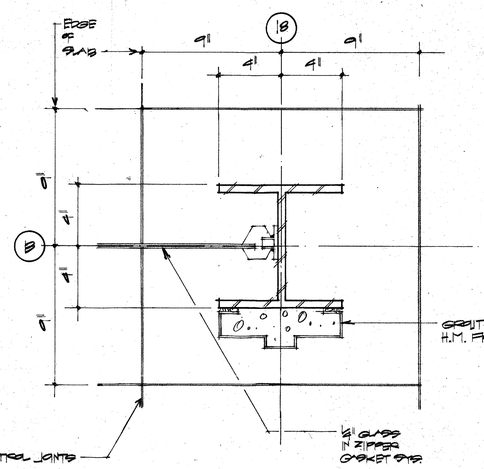

6 DETAIL 3"=1'-0"

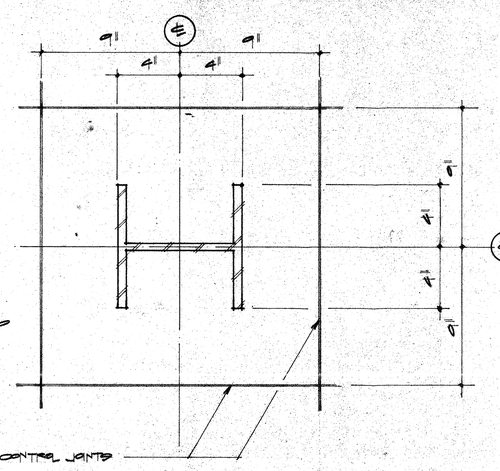

5 DETAIL 3"=1'-0"

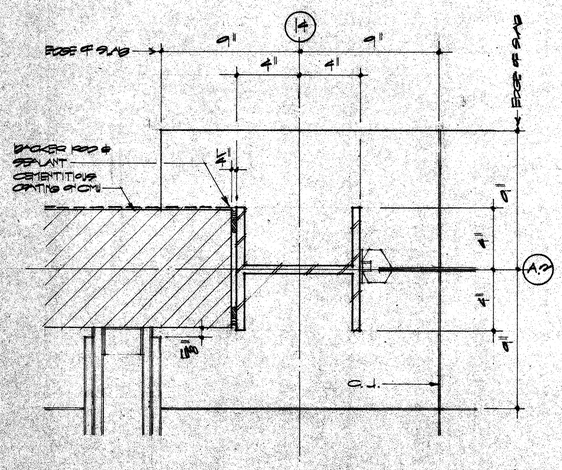

4 DETAIL 3"=1'-0"

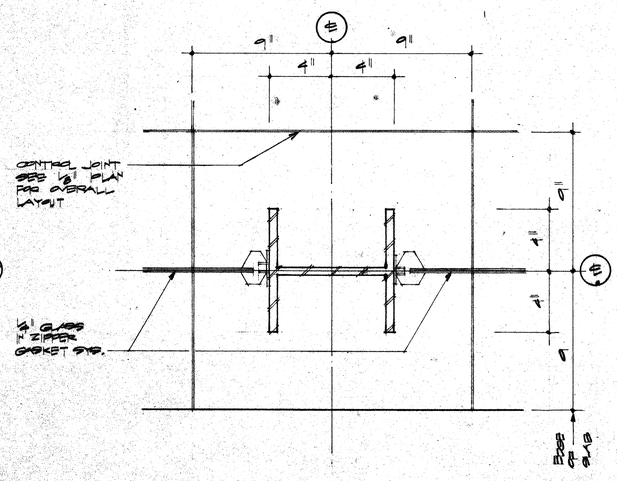

3 DETAIL 3"=1'-0"

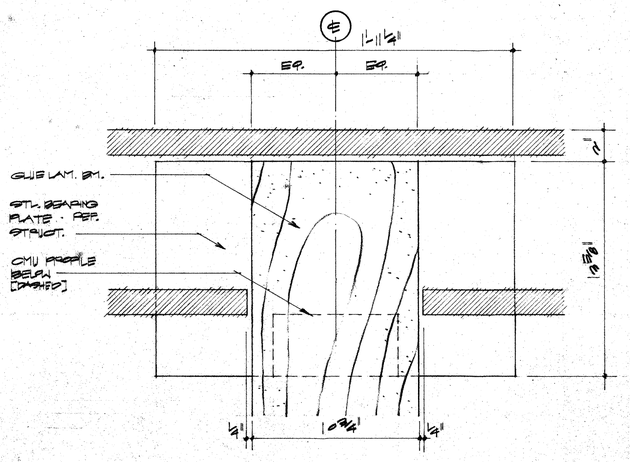

2 DETAIL 3"=1'-0"

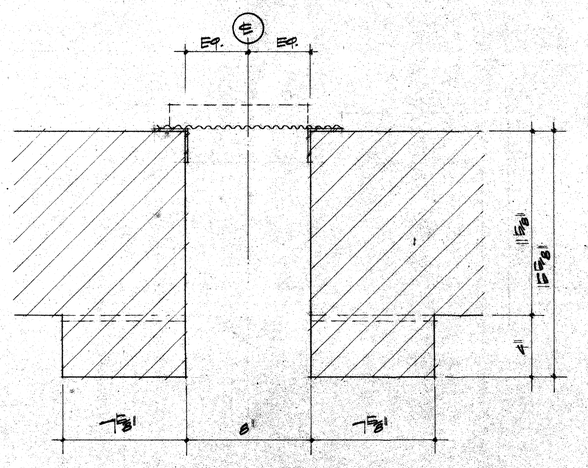

1 DETAIL 3"=1'-0"

OWNER
Town of Addison

ARCHITECT
Cunningham Architects
2700 Fairmount
Dallas, Texas 75201
214-855-5272

LANDSCAPE
The Kellomi Group
317-776-1417

THEATRE CONSULTANT
Theatre Projects
203-431-3969

INTERIORS
CRSS
713-552-2000

STRUCTURAL
Ellison Tanner
214-387-8393

M.E.P.
MEP Systems
214-754-4741

CIVIL
Kurtz & Associates
214-690-3322

HISTORIAN
Allen Maxson
214-691-7182

LIGHTING
Pamela Hull Wilson
214-823-6542

GRAPHICS
Nottestad Design
214-954-1378

Issue	Category	Subcategory	Sheet
ISSUE FOR BID 8-17-90	4	9	3

REGISTERED ARCHITECT STATE OF TEXAS NO. 08219

ACC ACT

ADDISON

c