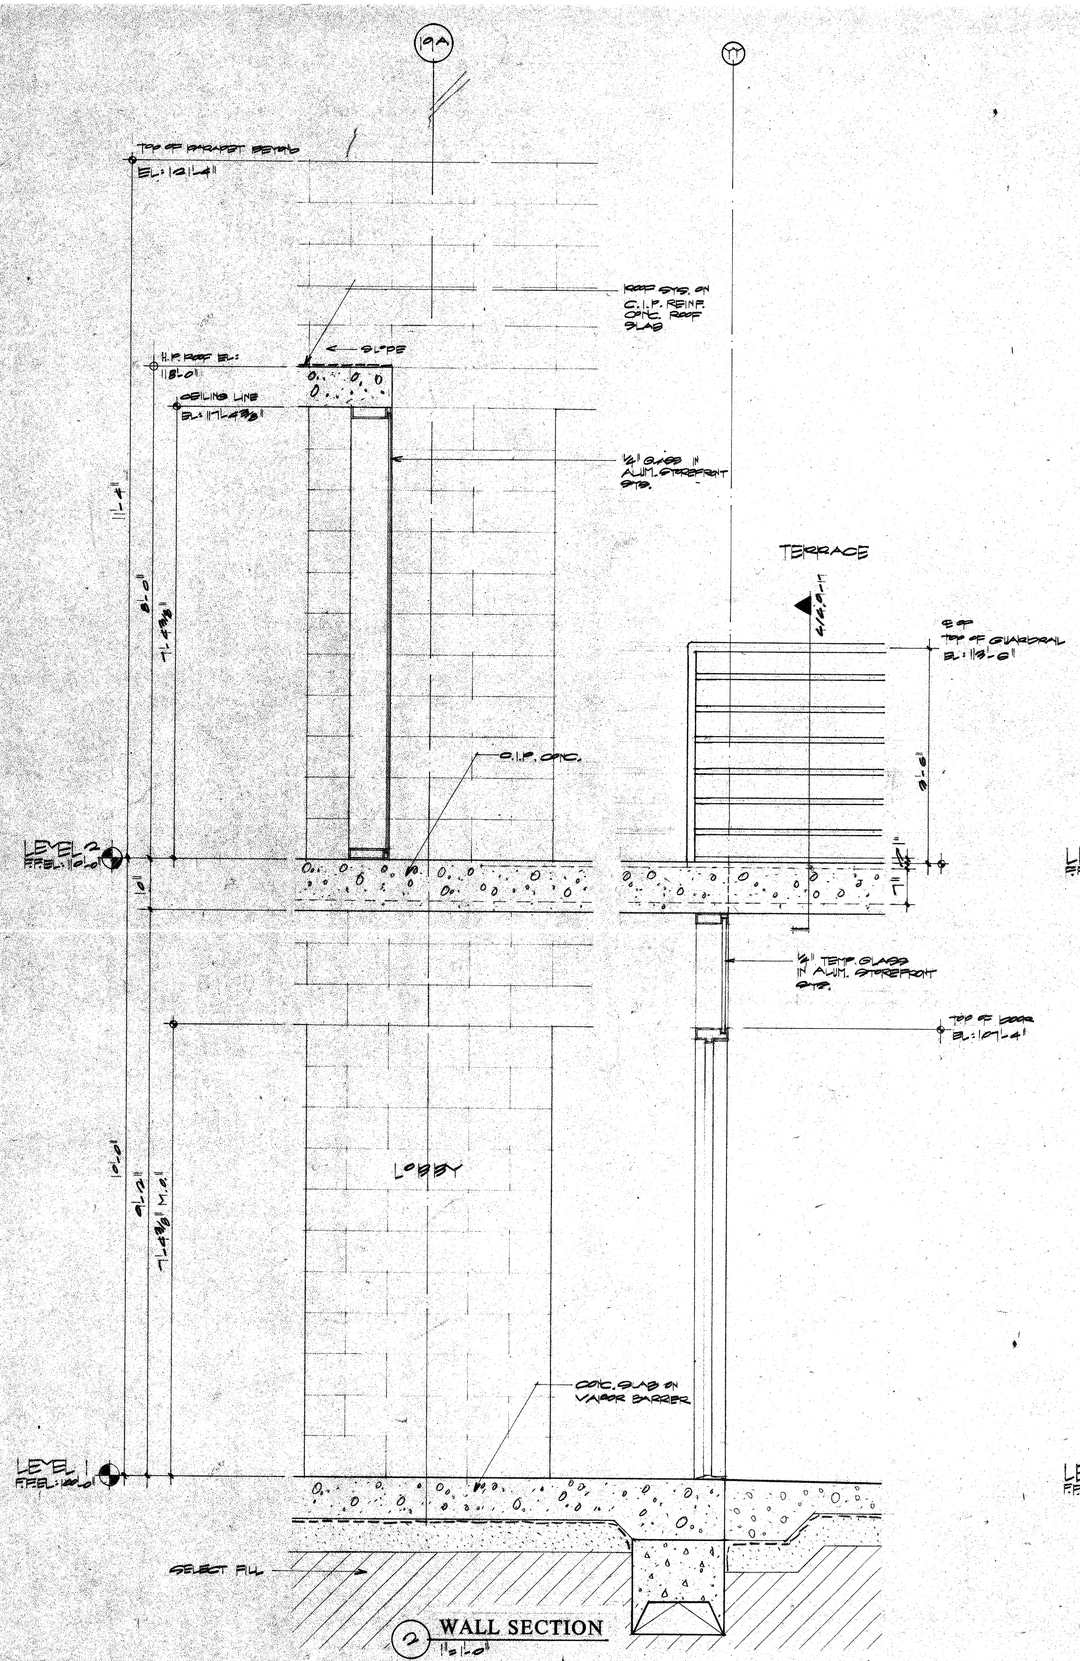

2 WALL SECTION
1"=1'-0"

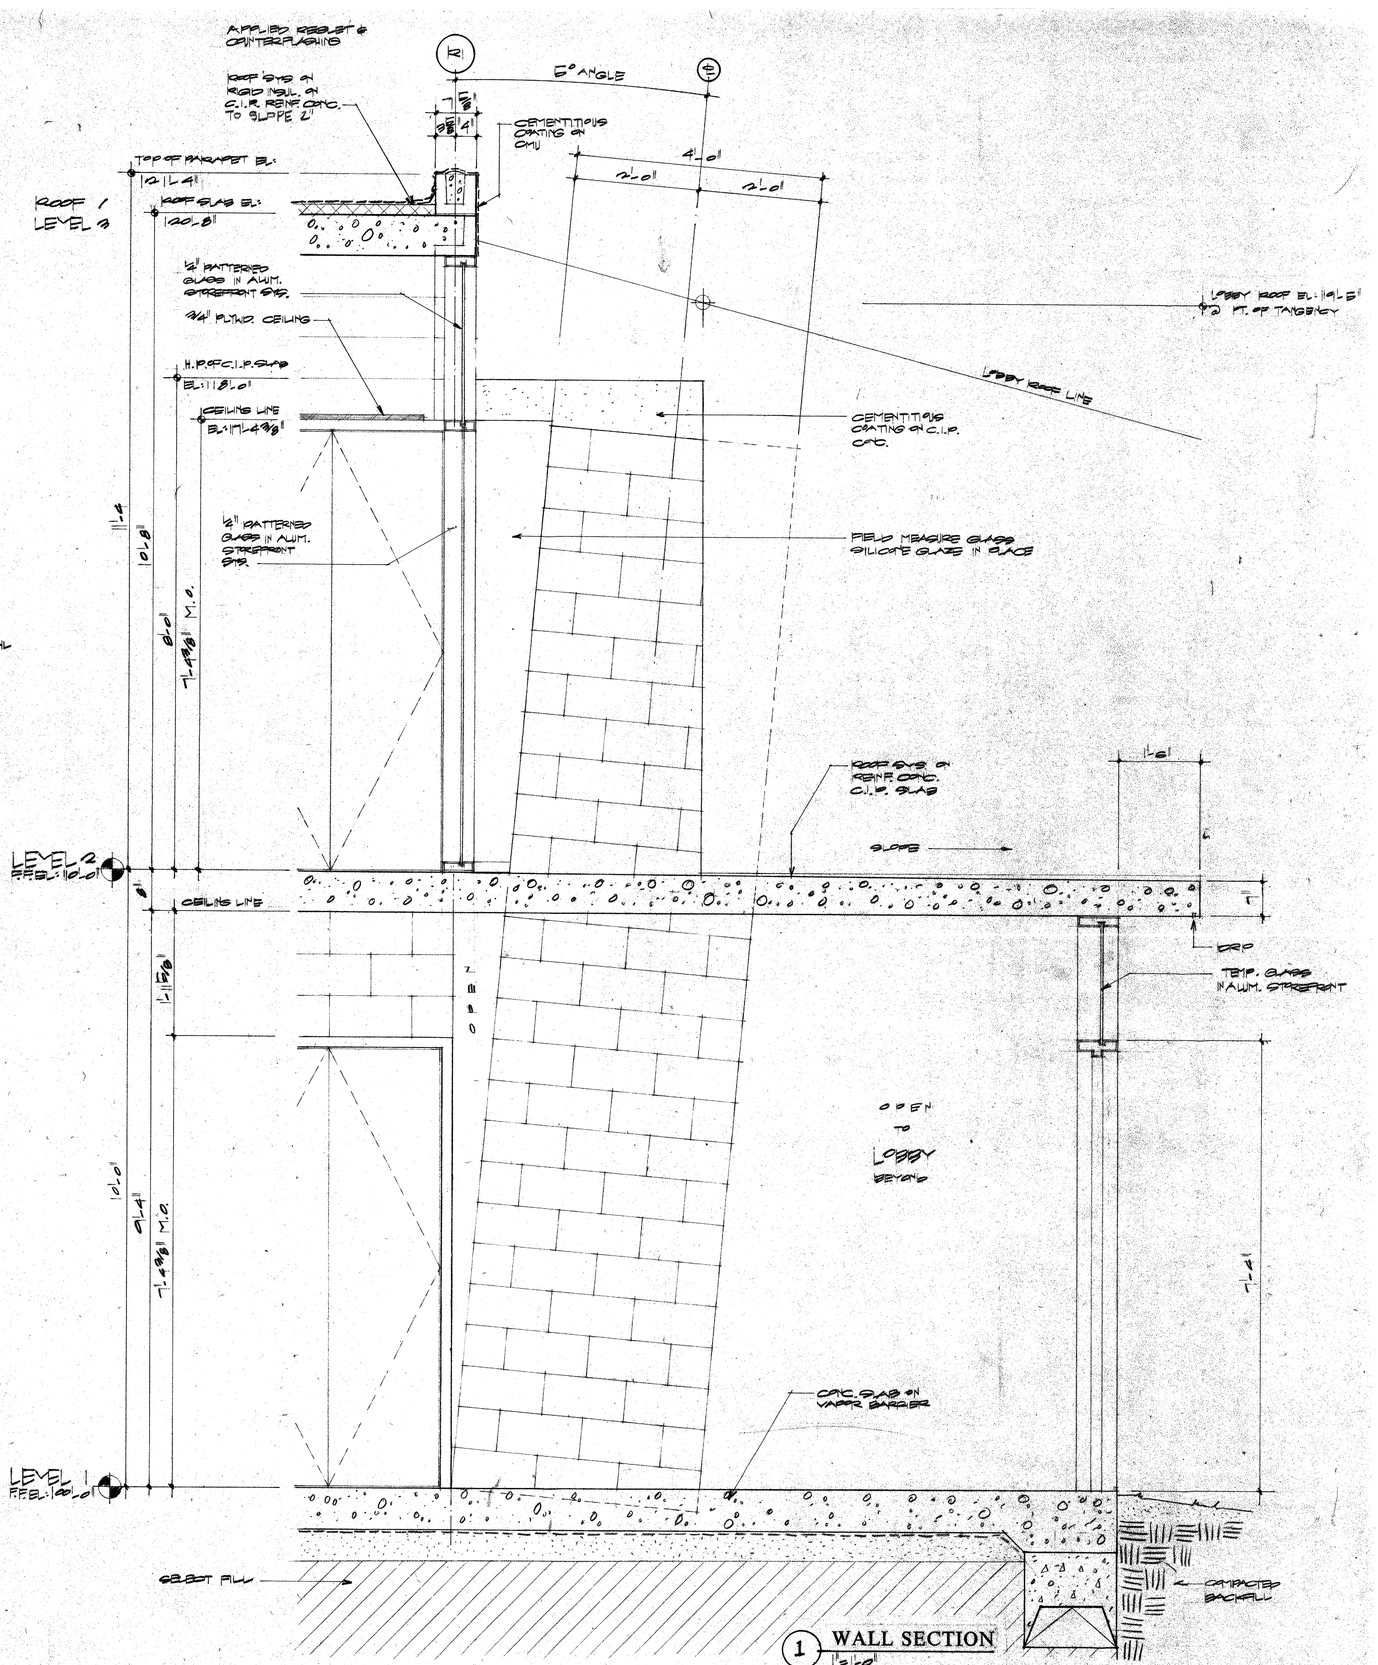

1 WALL SECTION
1"=1'-0"

REGISTERED ARCHITECT STATE OF TEXAS NO. 08219

ACC ACT

ADDISON

OWNER **Town of Addison**	LANDSCAPE The Kellams Group 317-776-1417	STRUCTURAL Ellison Tanner 214-387-8393	HISTORIAN Alan Mason 214-691-7182
ARCHITECT **Cunningham Architects** 2700 Fairmount Dallas, Texas 75201 214-855-5272	THEATRE CONSULTANT Theatre Projects 203-431-3949	M.E.P. MEP Systems 214-754-4741	LIGHTING Pamela Hull Wilson 214-823-6542
	INTERIORS CRSS 713-552-2000	CIVIL Kurtz & Associates 214-690-3322	GRAPHICS Nottessed Design 214-954-1978

Issue	Category	Subcategory	Sheet
ISSUE FOR BID 8-17-90	4	8	18

T