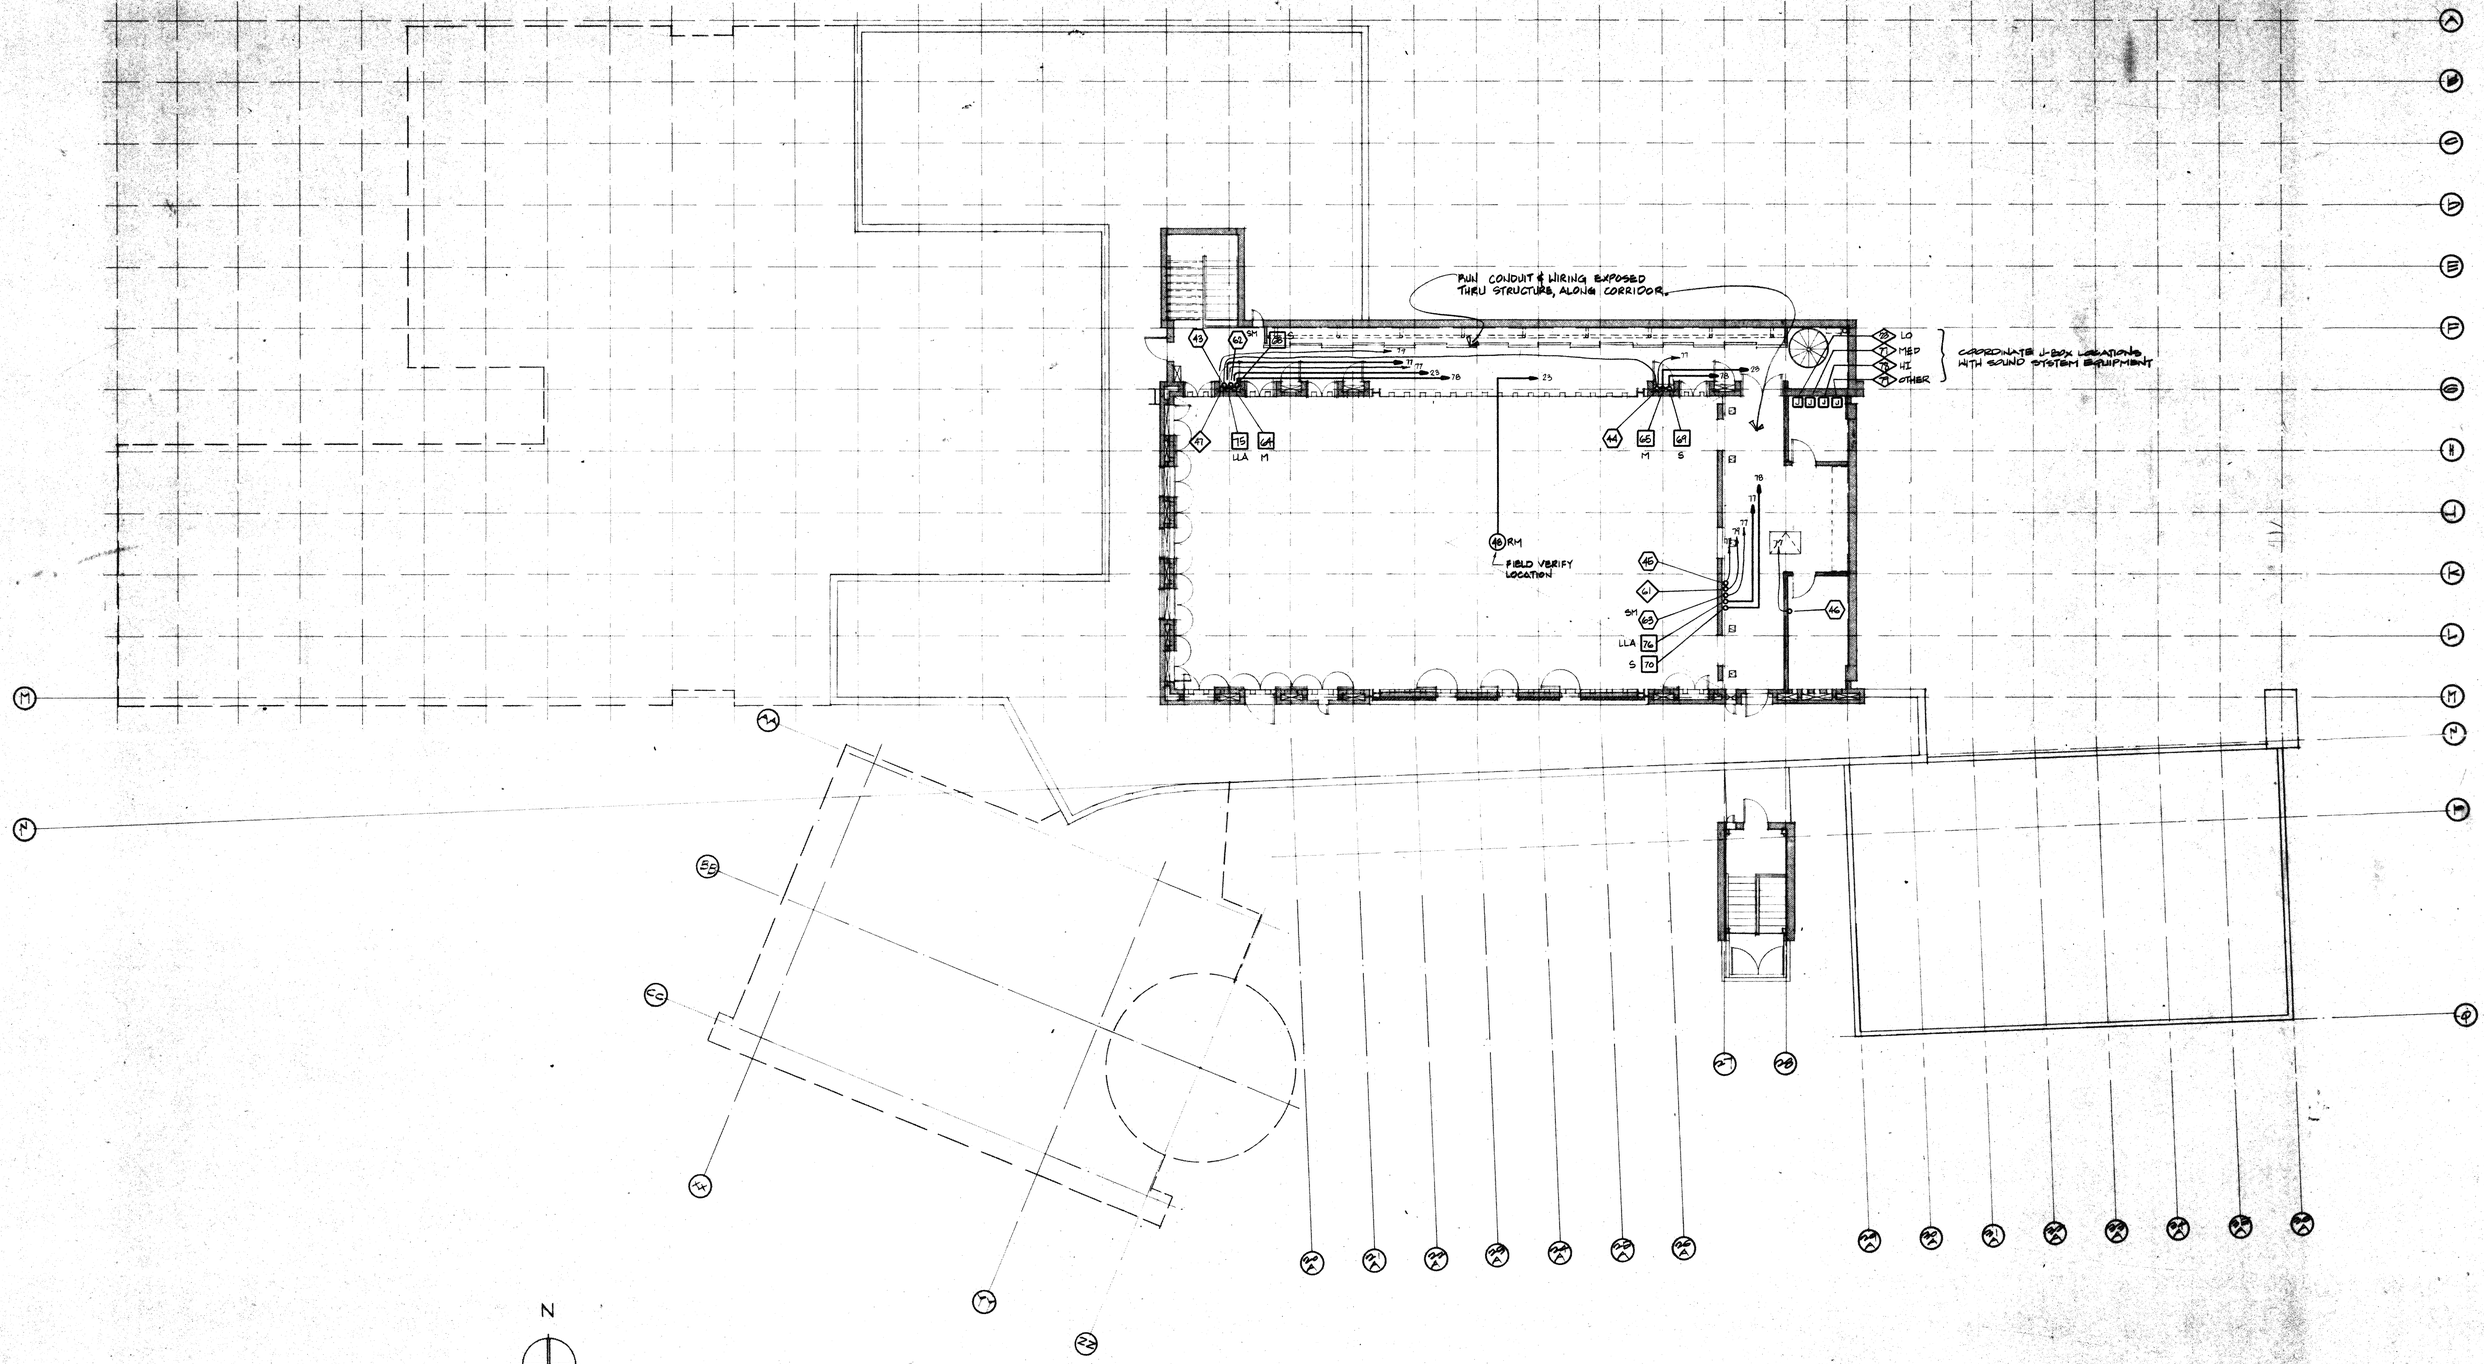

ACC ADDISON ACT

OWNER	LANDSCAPE	STRUCTURAL	HISTORIAN	Issue	Category	Subcategory	Sheet
Town of Addison	The Kellams Group 317-776-1417	Ellisor Tanner 214-387-8383	**Alan Mason** **214-691-7182**	ISSUE FOR BID 8-17-90	10	2	3
ARCHITECT **Cunningham Architects** 2700 Fairmount Dallas, Texas 75201 214-855-5272	THEATRE CONSULTANT Theatre Projects 203-431-3949	M.E.P. MEP Systems 214-754-4769	LIGHTING **Pamela Hall Wilson** **214-823-8842**				
	INTERIORS CRSS 713-552-2000	CIVIL Kurtz & Associates 214-880-3322	GRAPHICS **Networked Design** **214-954-1978**				

STATE OF TEXAS
MARK BRIAN FORTH
REGISTERED
PROFESSIONAL ENGINEER

AV3
D