



DOOR SCHEDULE

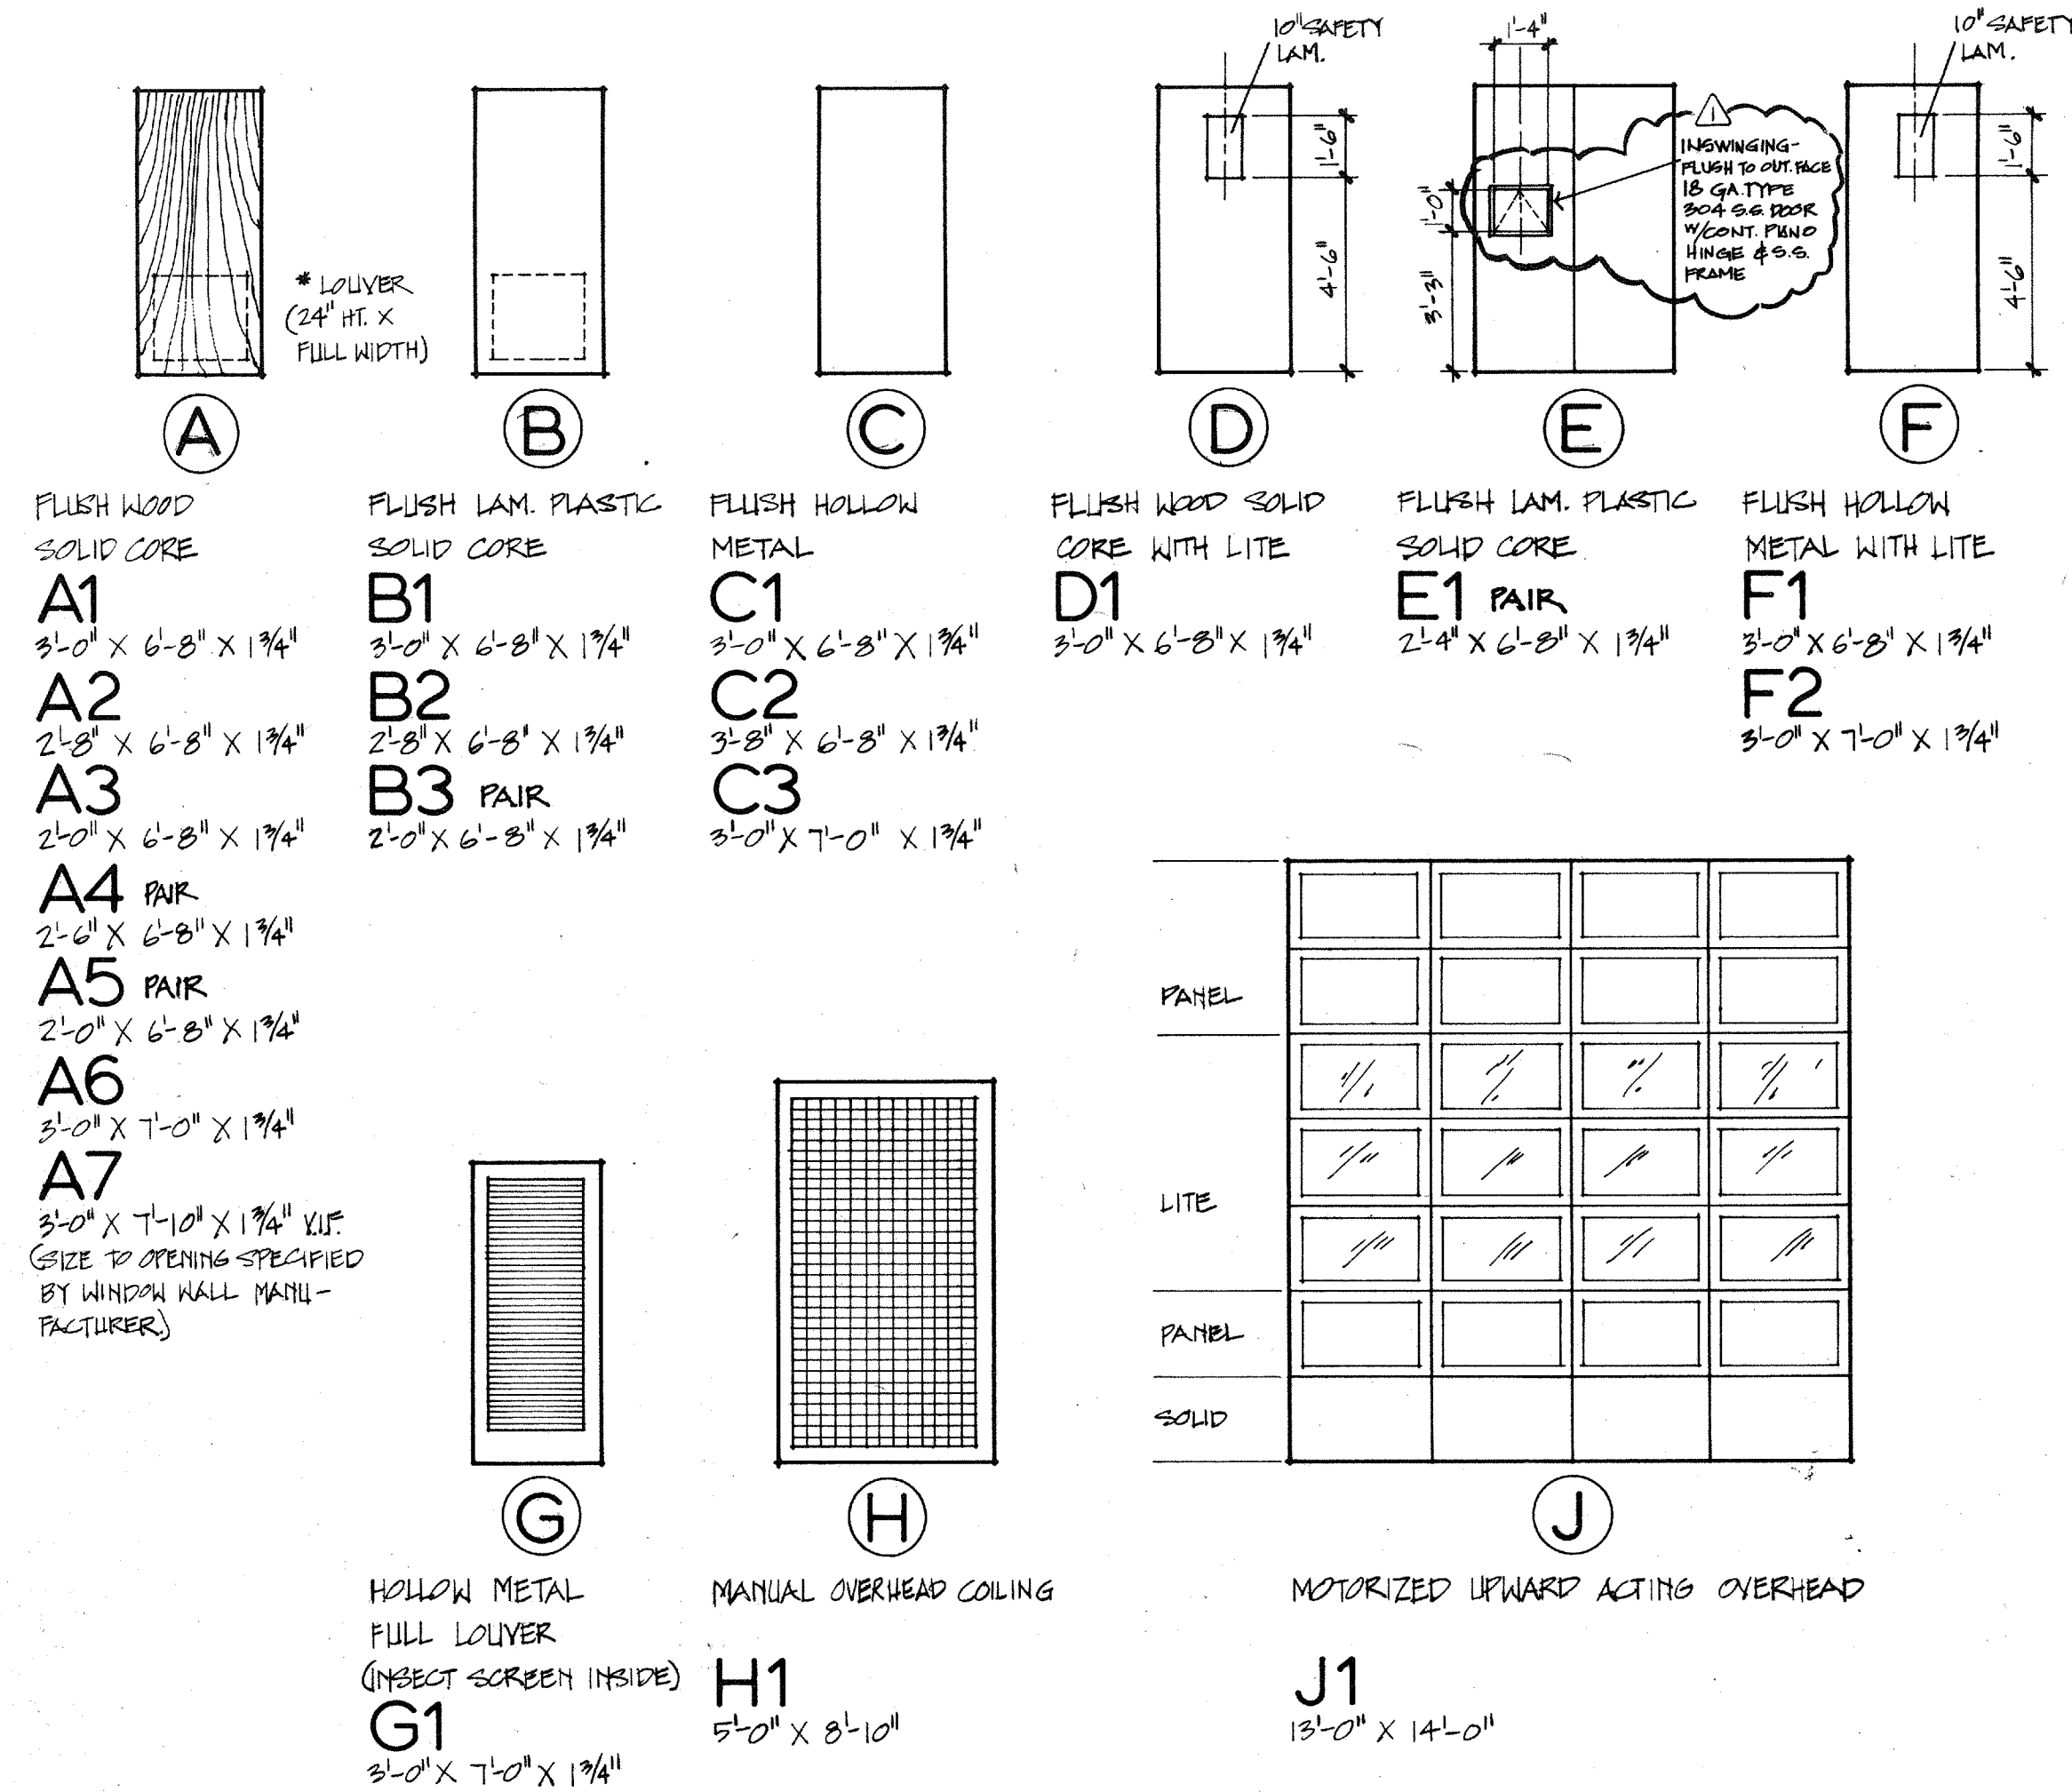

WINDOW SCHEDULE

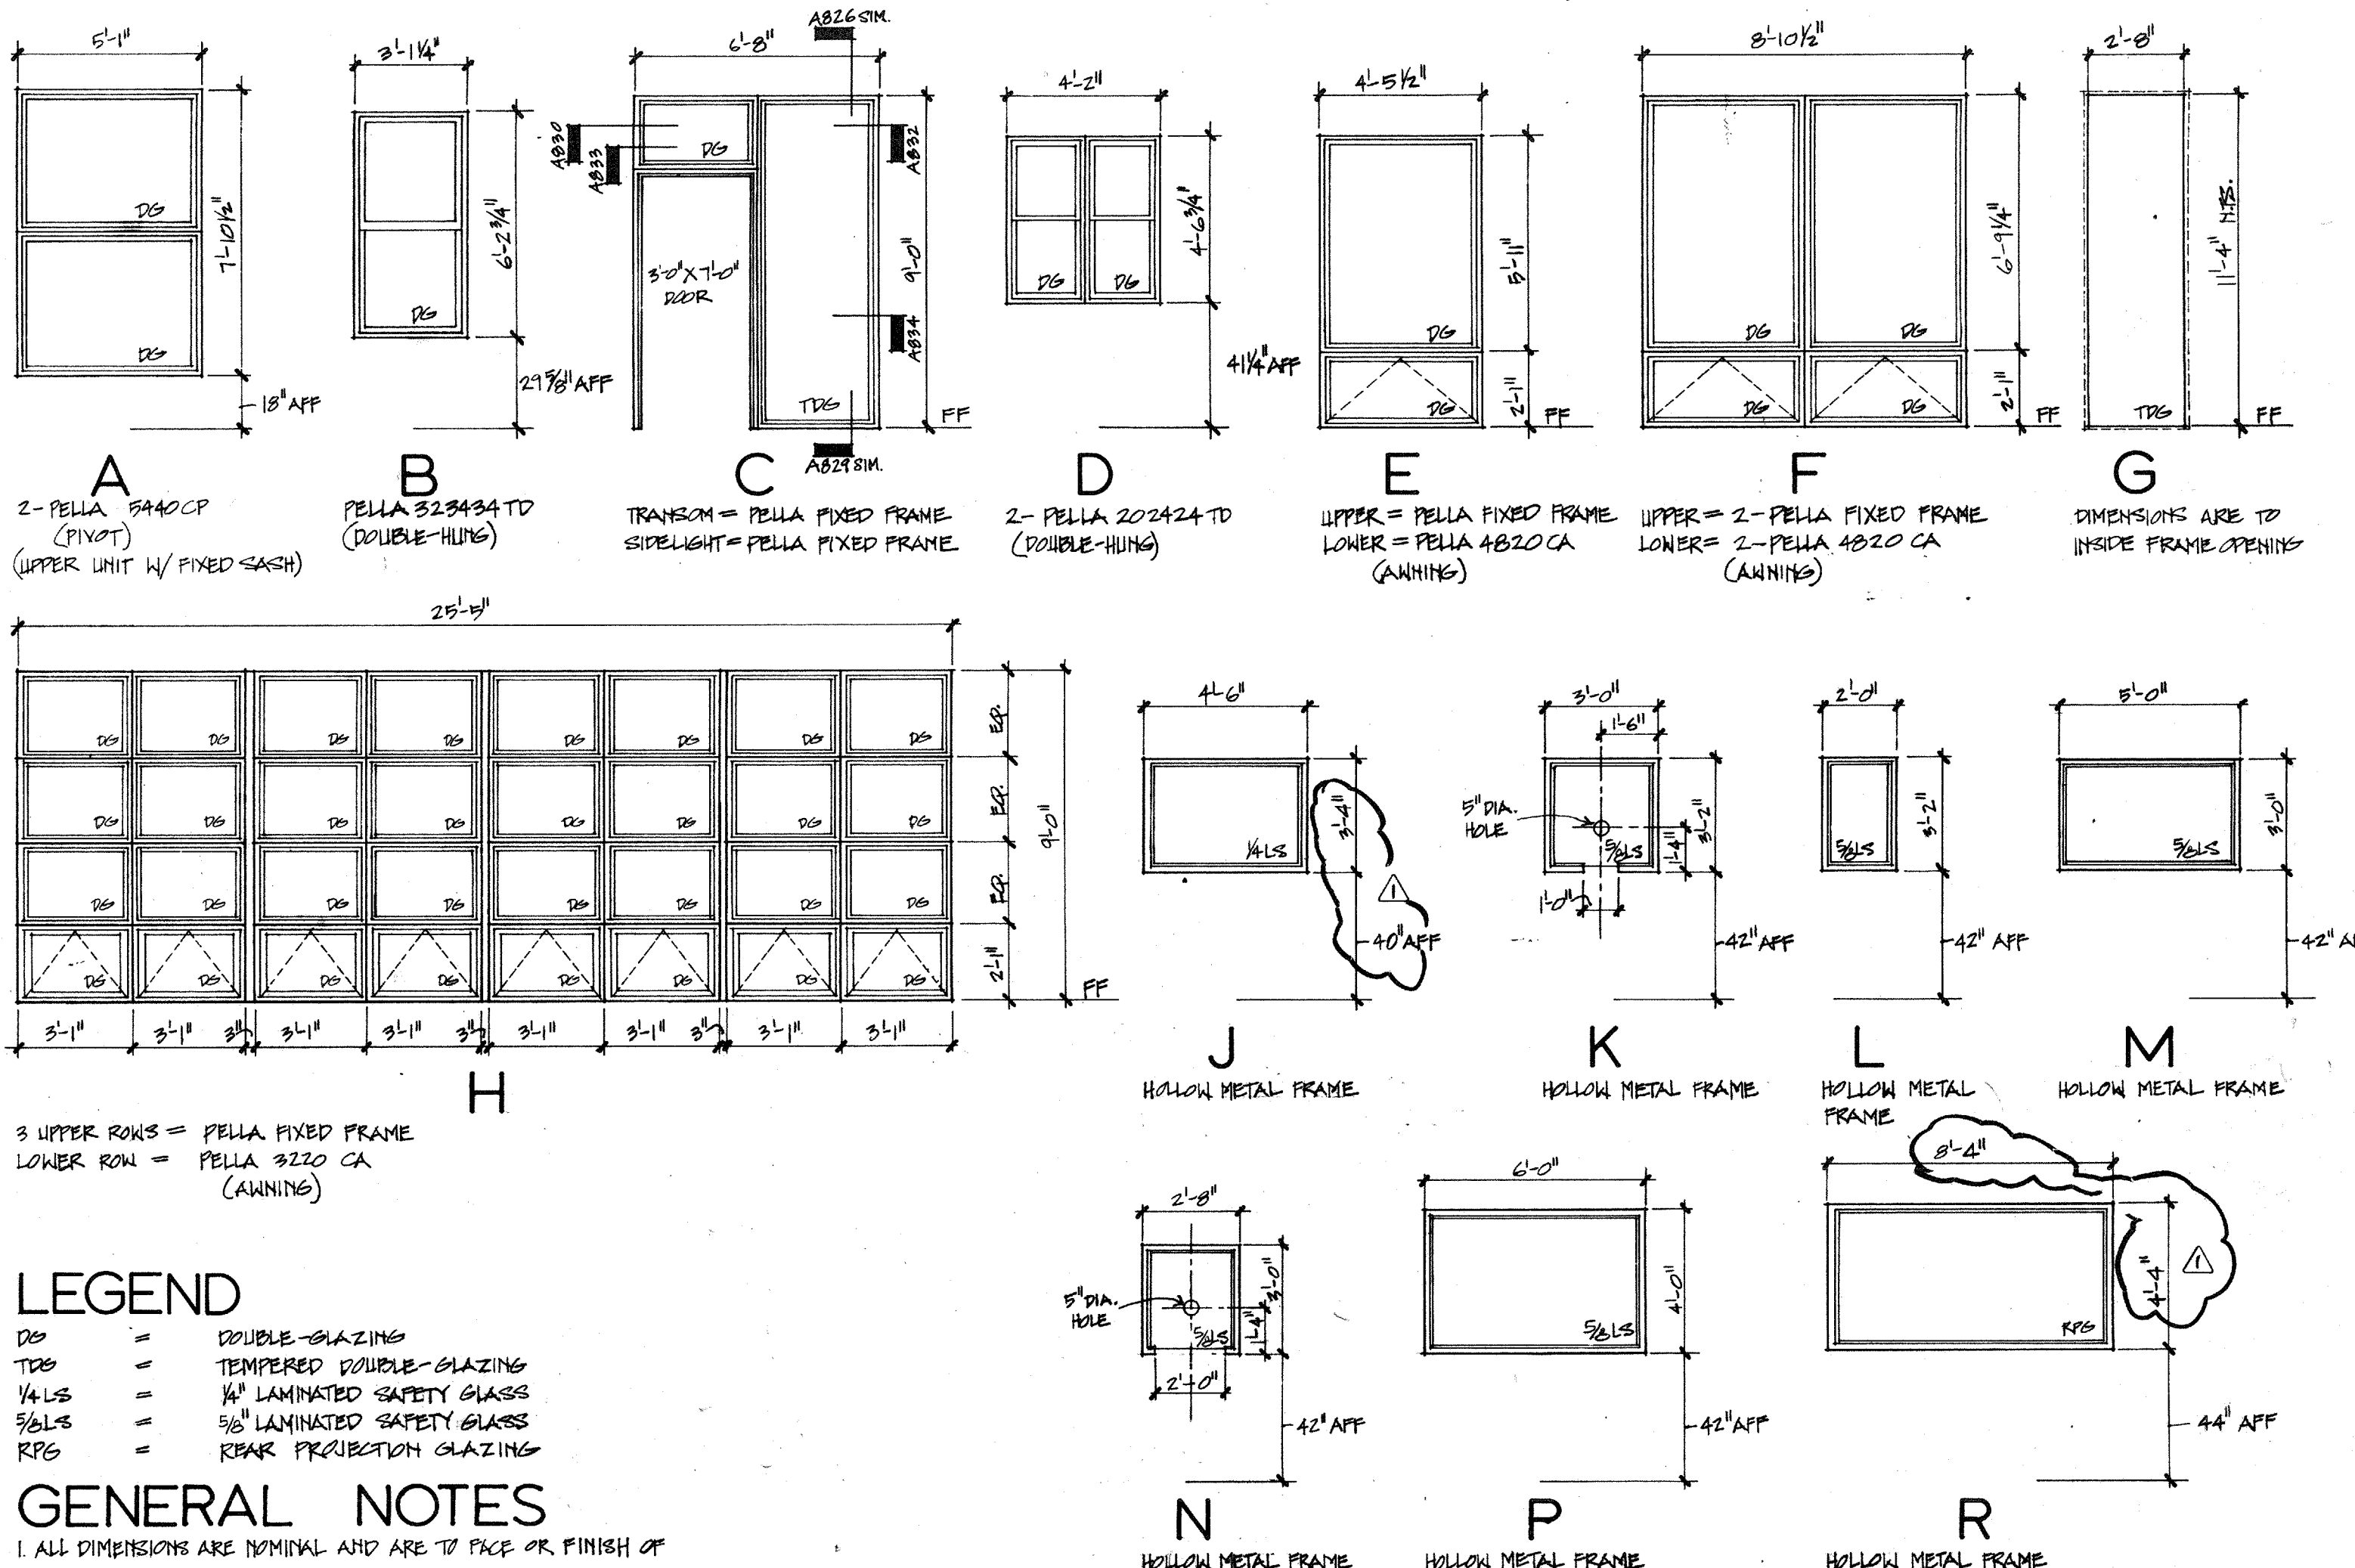

**LEGEND**  

**GENERAL NOTES**  
 1. ALL DIMENSIONS ARE NOMINAL AND ARE TO FACE OR FINISH OF SHIP BOY, FACE OF MASONRY, OR FACE OF CONCRETE.  
 2. ALL EXPOSED VERTICAL CMU CORNERS TO BE FULLNESS.  
 3. --- INDICATES SHIP BOY TO THE SIDE OF PARTITION TO BOTTOM OF ROOF DECK.  
 4. ALL PARTITIONS SHALL BE BRACED TO STRUCTURE @ MIN. OF 8'-0" O.C.  
 5. ( ) INDICATES PARTITION TYPE (REFER TO SHIT. A.9)

ROOM FINISH SCHEDULE

FLOR / BASE WALL

- CARPET / VINYL BASE
- QUARRY TILE / TILE BASE OR
- WOOD FLOORING / VINYL BASE
- VINYL COMPOSITION TILE / VINYL BASE
- CERAMIC TILE / TILE BASE
- EXPOSED CONCRETE / NO BASE LINING

NOTE: NO BASE @ BRICK, C.M.U., OR WINDOW WALLS.


SYMBOLS:  
 A PAINTED GYP BD  
 B VINYL WALL COVERING  
 C PAINTED MASONRY  
 D CERAMIC TILE  
 E UNPAINTED MASONRY

FIRE EXTINGUISHER SCHEDULE

NUMBER	TITLE
1	2A 20 BC
2	HALON 1216*
3	40 BC
4	DRY CHEMICAL @ RANGE HOOD
5	15" COL
6	2A 20 BC
7	2A 20 BC
8	2A 20 BC
9	40 BC (REFER TO SITE PLAN FOR LOCATION)


DOOR / WINDOW DETAIL GROUPS

GROUP / DETAILS	SYMBOL
1	A801
2	A801, A802
3	A801, A802, A804, A807
4	A803, A804
5	A803, A804
6	A801, A803
7	A803, A804
8	A805, A806, A811, A812
9	A805, A807, A812
10	A808
11	A813, A814
12	A815
13	A811, A816, A817, A818, A819
14	A817, A818, A819
15	A822, A821
16	A811, A816, A820
17	A808
18	A808
19	A813, A814
20	A811, A816, A817, A818, A819
21	A817, A818, A819
22	A822, A821
23	A822, A821
24	A801
25	A823
26	A823
27	A840, A841, A842
28	A824 SIM, A890, A892, A894
29	A824 SIM, A890, A892, A894
30	A801, A810, A816
31	A811, A816
32	A820, A816, A810, A820

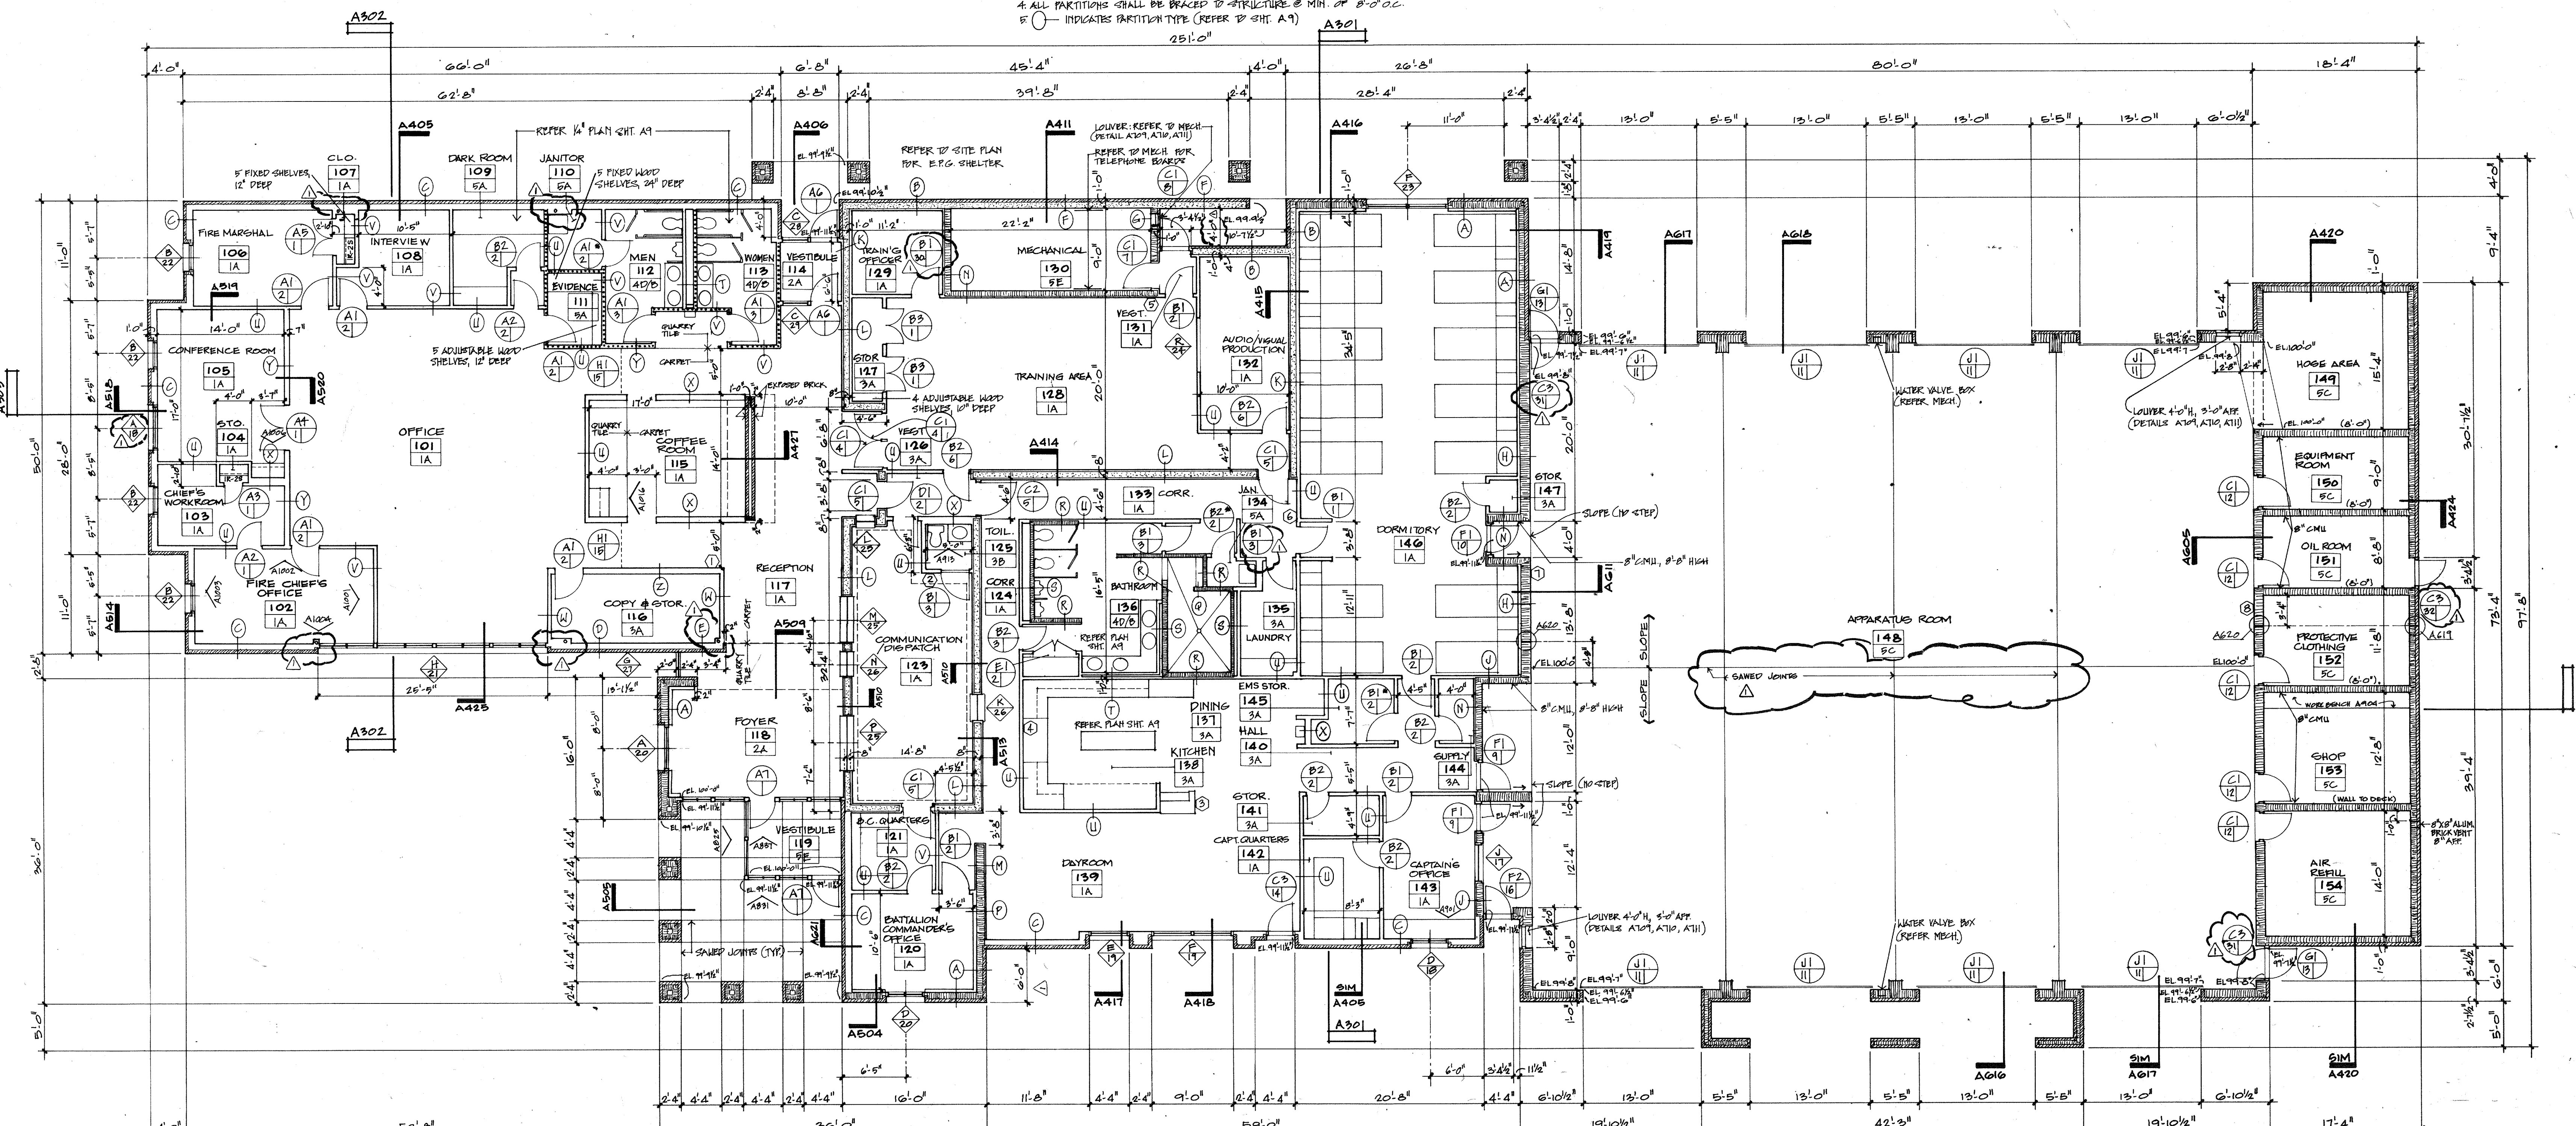

FINISH FLOOR DATUM EL 100'-0" - ACTUAL 644'-5"

FLOOR PLAN

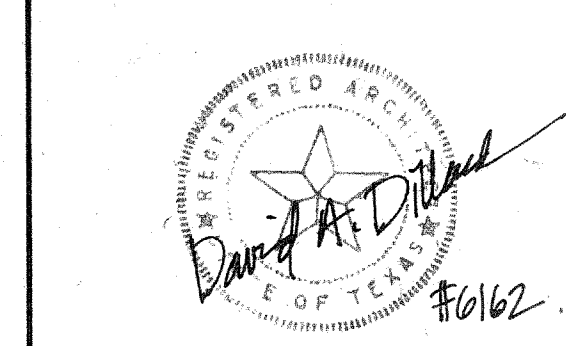

DAVID A. DILLARD, ARCHITECT  
 4310 Westside Drive - Suite F  
 Dallas, Texas 75209 - 214-528-2842

CITY OF ADDISON FIRE DEPARTMENT  
 CENTRAL OFFICES # FIRE STATION NO. 1  
 AIRPORT PARKWAY + ADDISON ROAD, ADDISON, TX.

FLOOR PLAN  
 DOOR SCHEDULE  
 WINDOW SCHEDULE  
 ROOM FINISH SCHEDULE