




A302 BUILDING SECTION

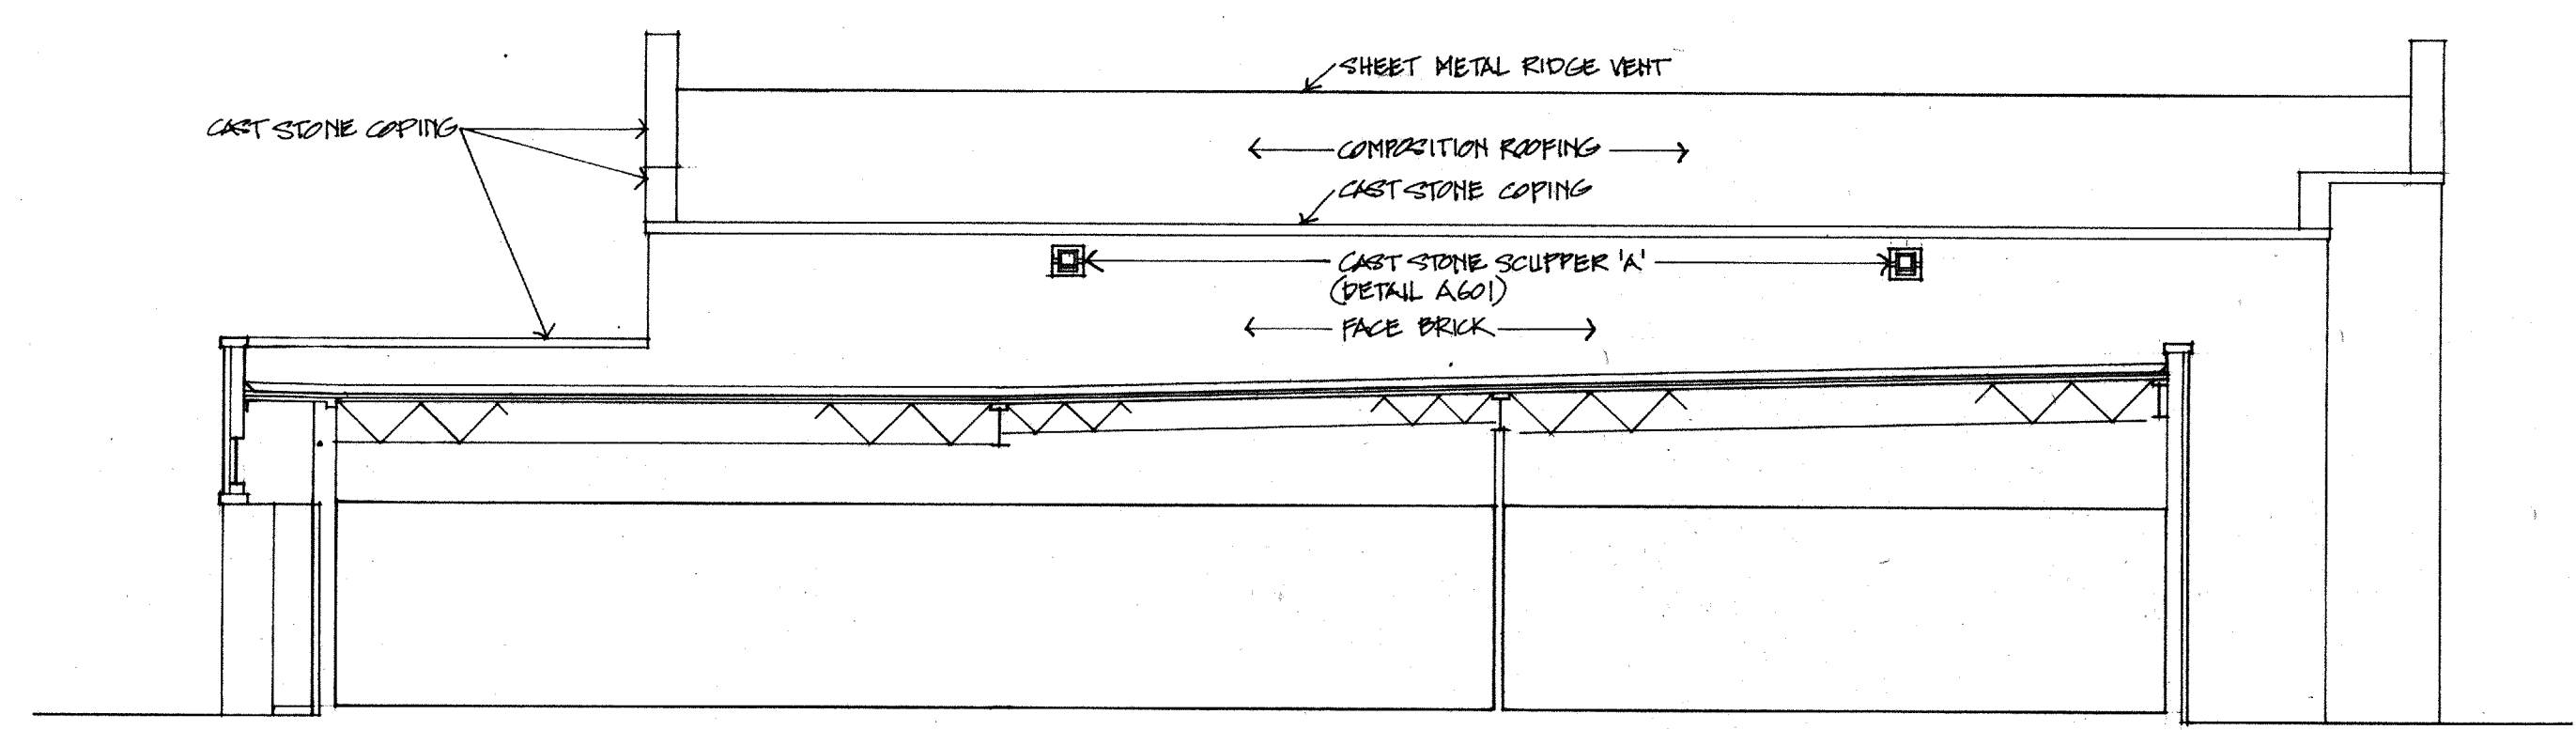


A301 BUILDING SECTION

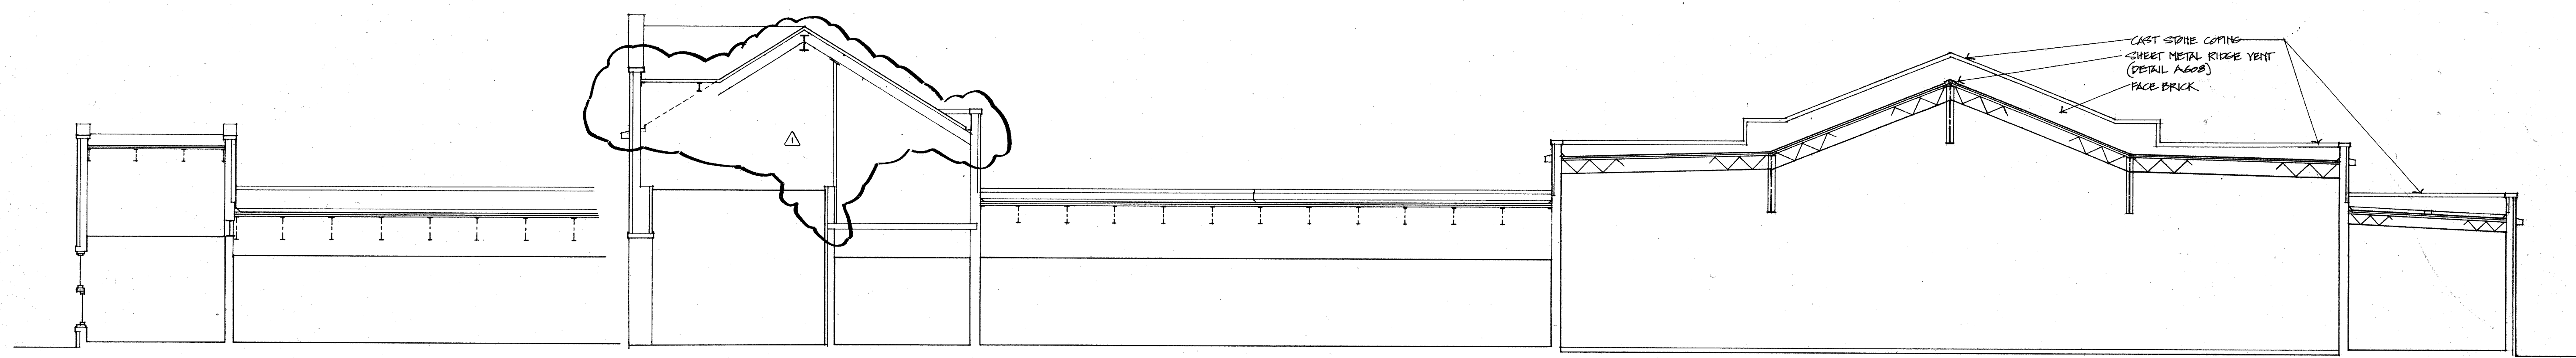


A303 BUILDING SECTION

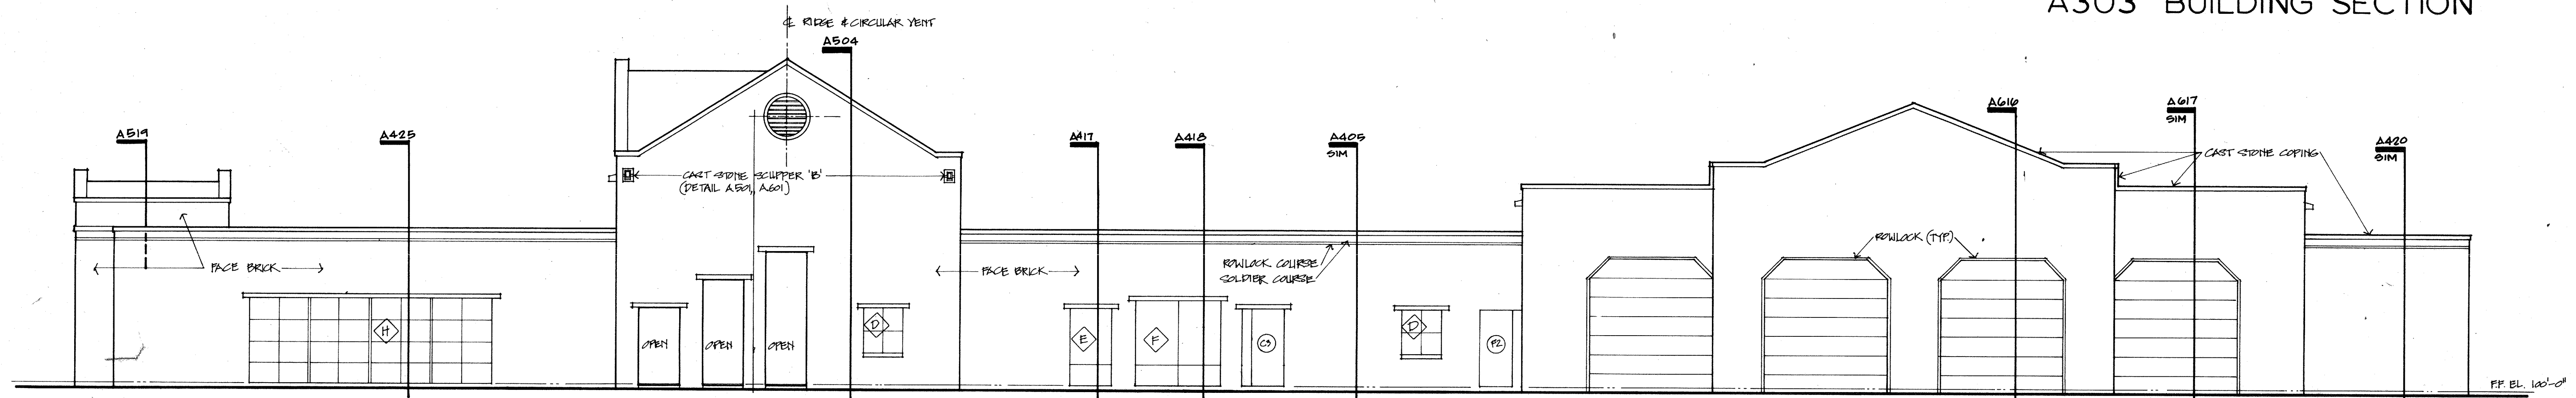


A304 NORTH ELEVATION

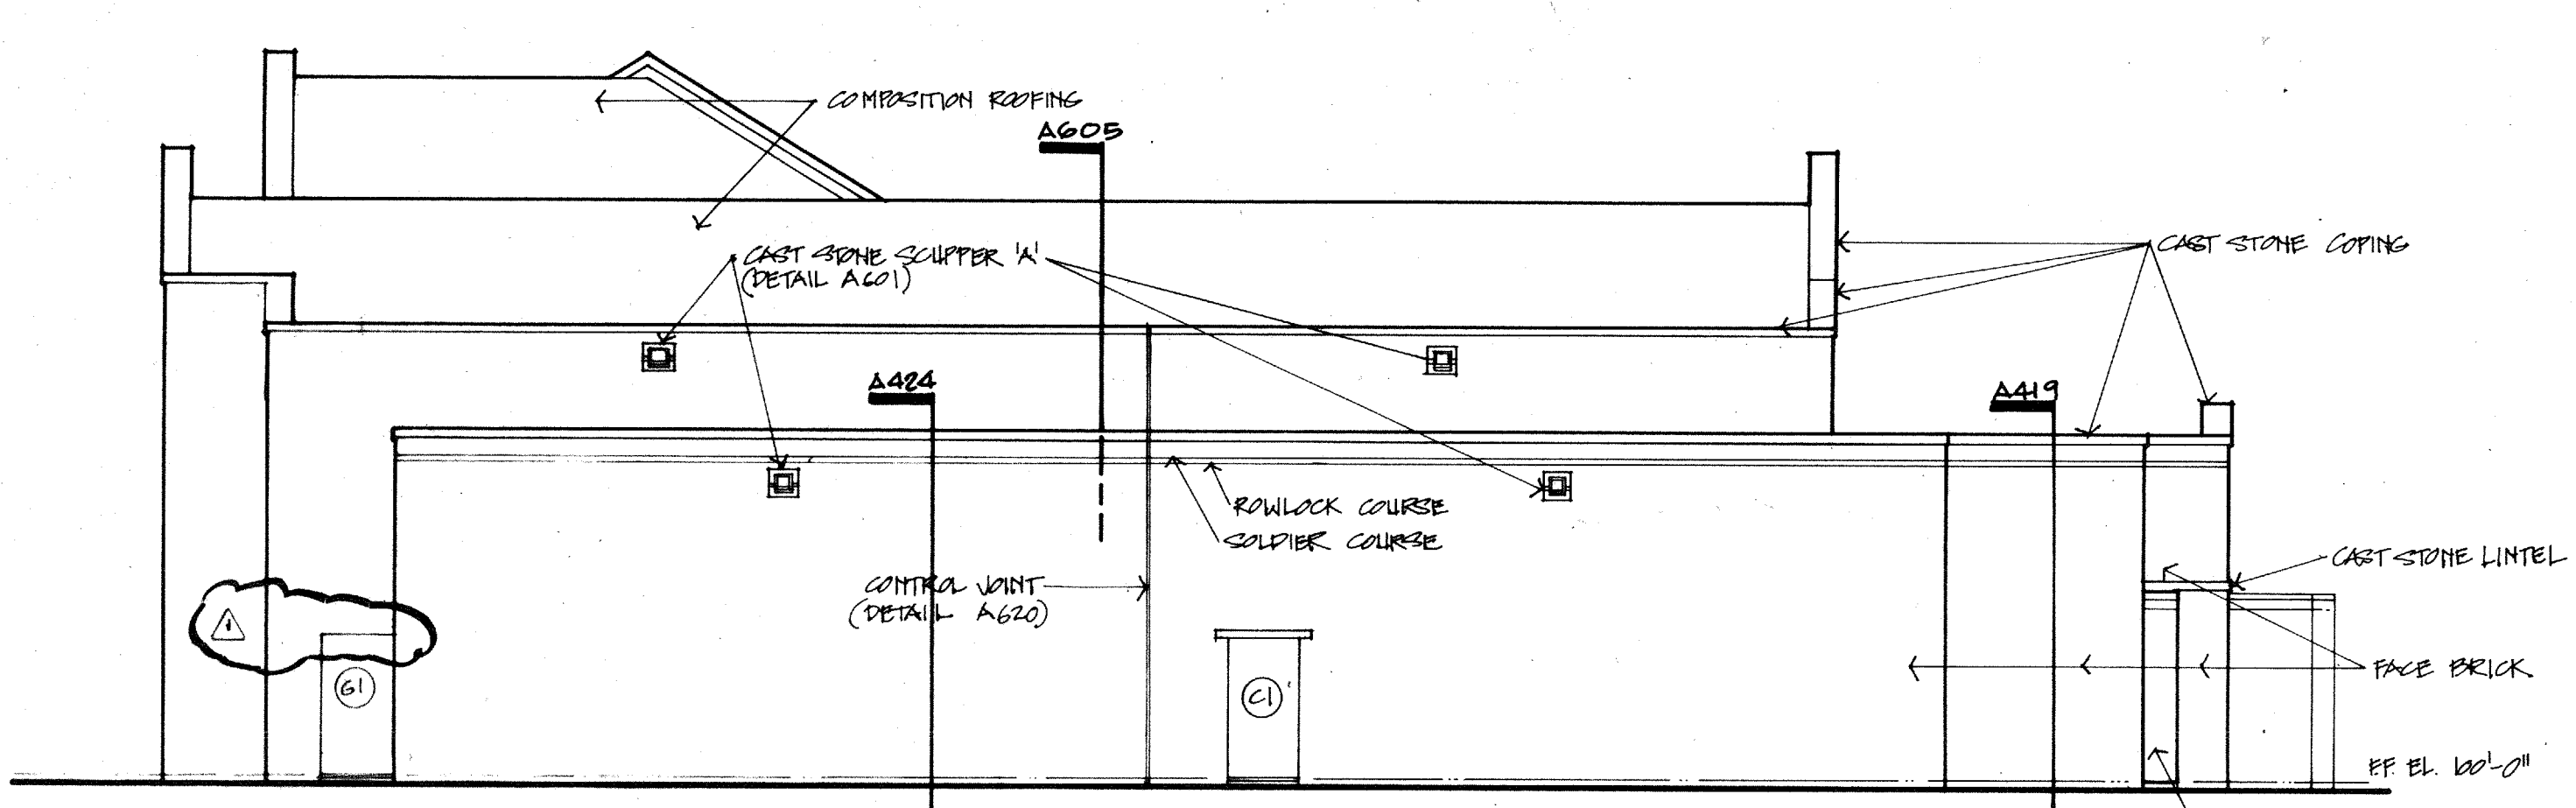



A306 WEST ELEVATION

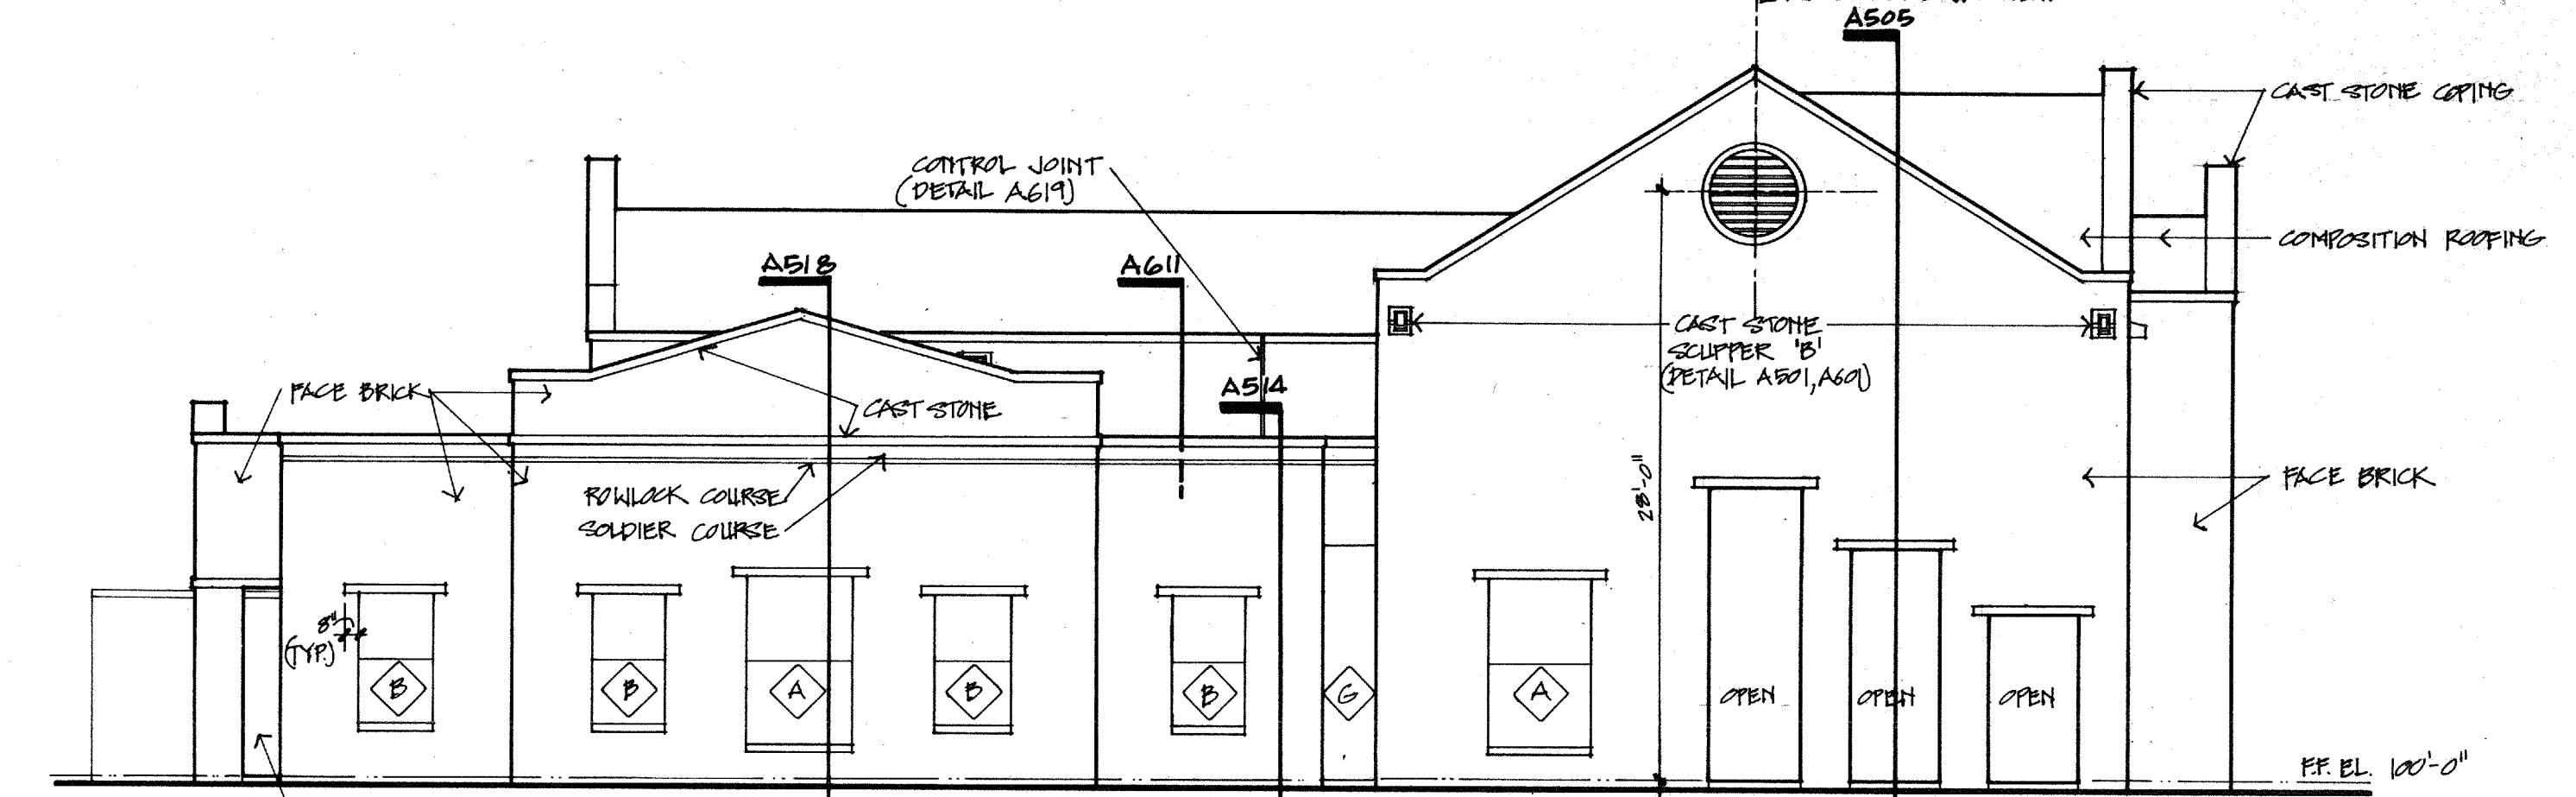

A305 EAST ELEVATION

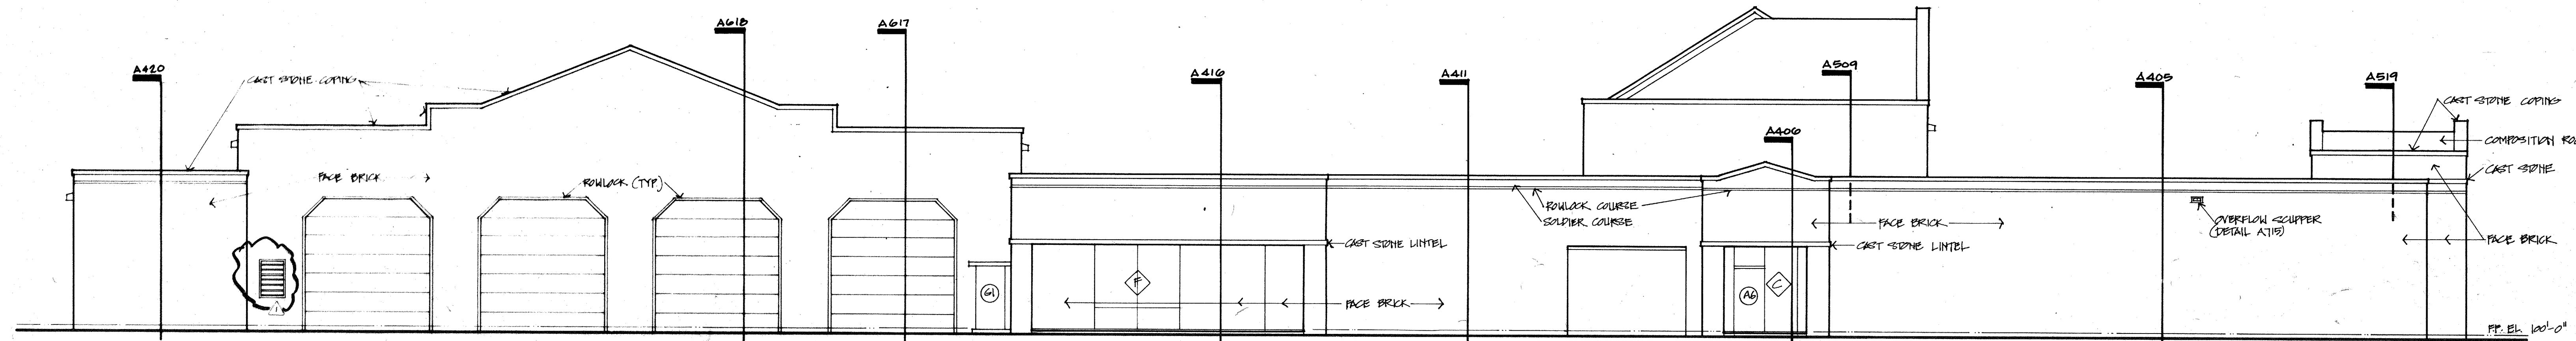

A307 SOUTH ELEVATION

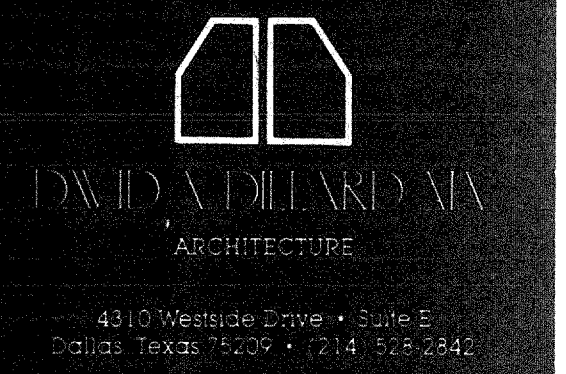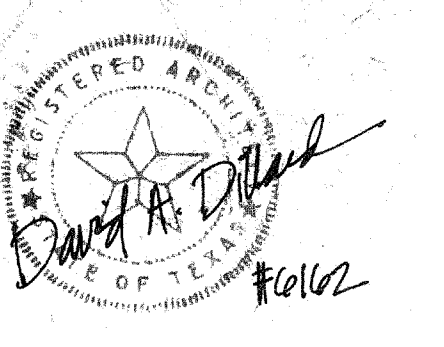

CITY OF ADDISON
FIRE DEPARTMENT
CENTRAL OFFICES &
FIRE STATION NO. 1
AIRPORT PARKWAY &
ADDISON ROAD, ADDISON, TX.

ELEVATIONS
BUILDING SECTIONS

PROJECT NO. SHEET NO.
82.00
DATE
6/25/82

A3