


**SHEPHERD + BOYD**  
 ARCHITECTS/PLANNERS & INTERIORS  
 8235 DOUGLAS AVE. SUITE 900  
 DALLAS, TEXAS 75220  
 TELEPHONE 214/591-9000

**ADDISON HALL**  
 ADDISON TEXAS

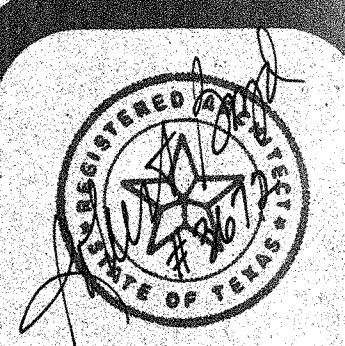


REVISIONS

NO.	DATE	DESCRIPTION

SHEET  
 A - 11


**ATTIC FLOOR FRAMING REVISIONS**

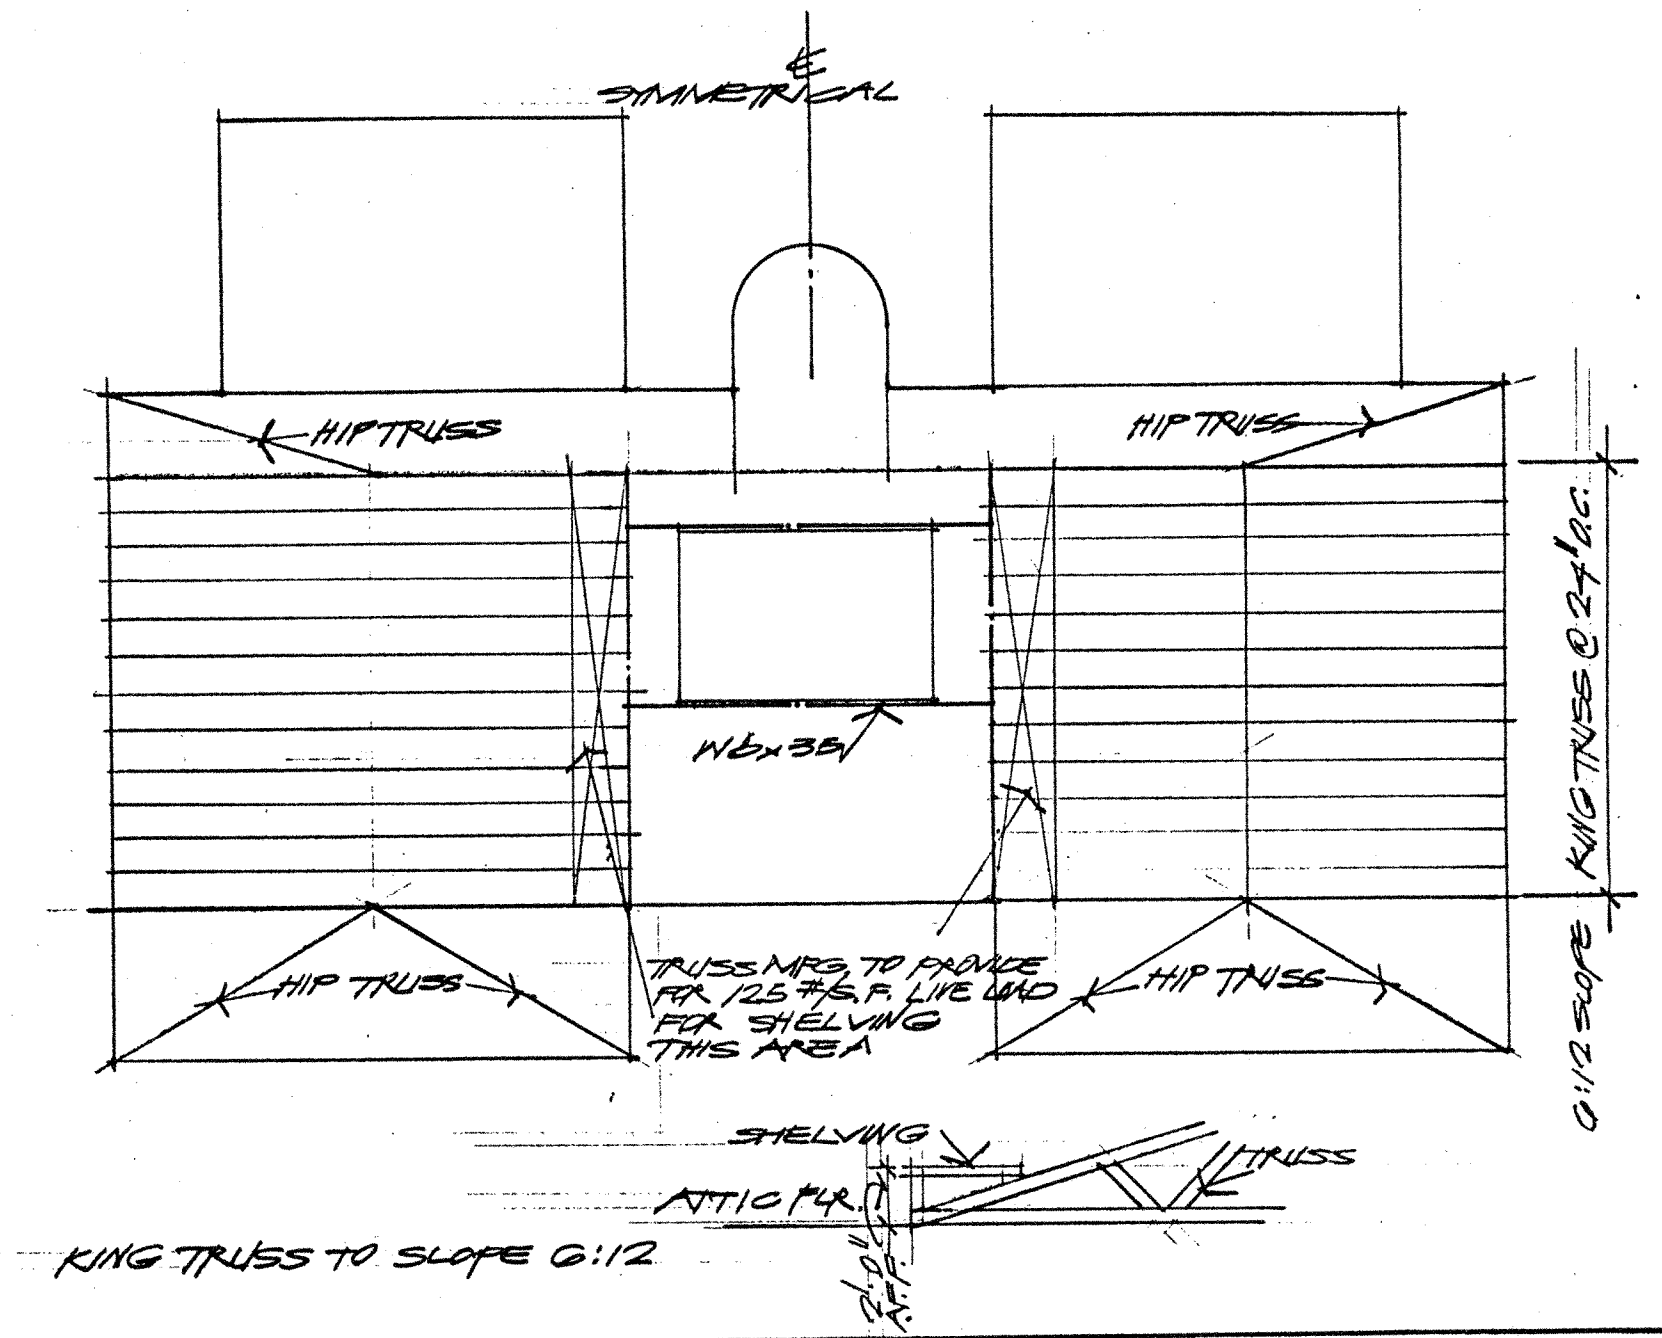

**SHEPHERD + BOYD, INC.**  
 ARCHITECTS-PLANNERS-INTERIORS  
 8235 DOUGLAS AVE. SUITE 900  
 DALLAS, TEXAS 75220

PROJECT: TOWN HALL ANNEX  
 DATE: JAN 82  
 SCALE: 1/4" = 1'-0"  
 BY: HSB

NO. 310  
 SHEET  
 ADD200

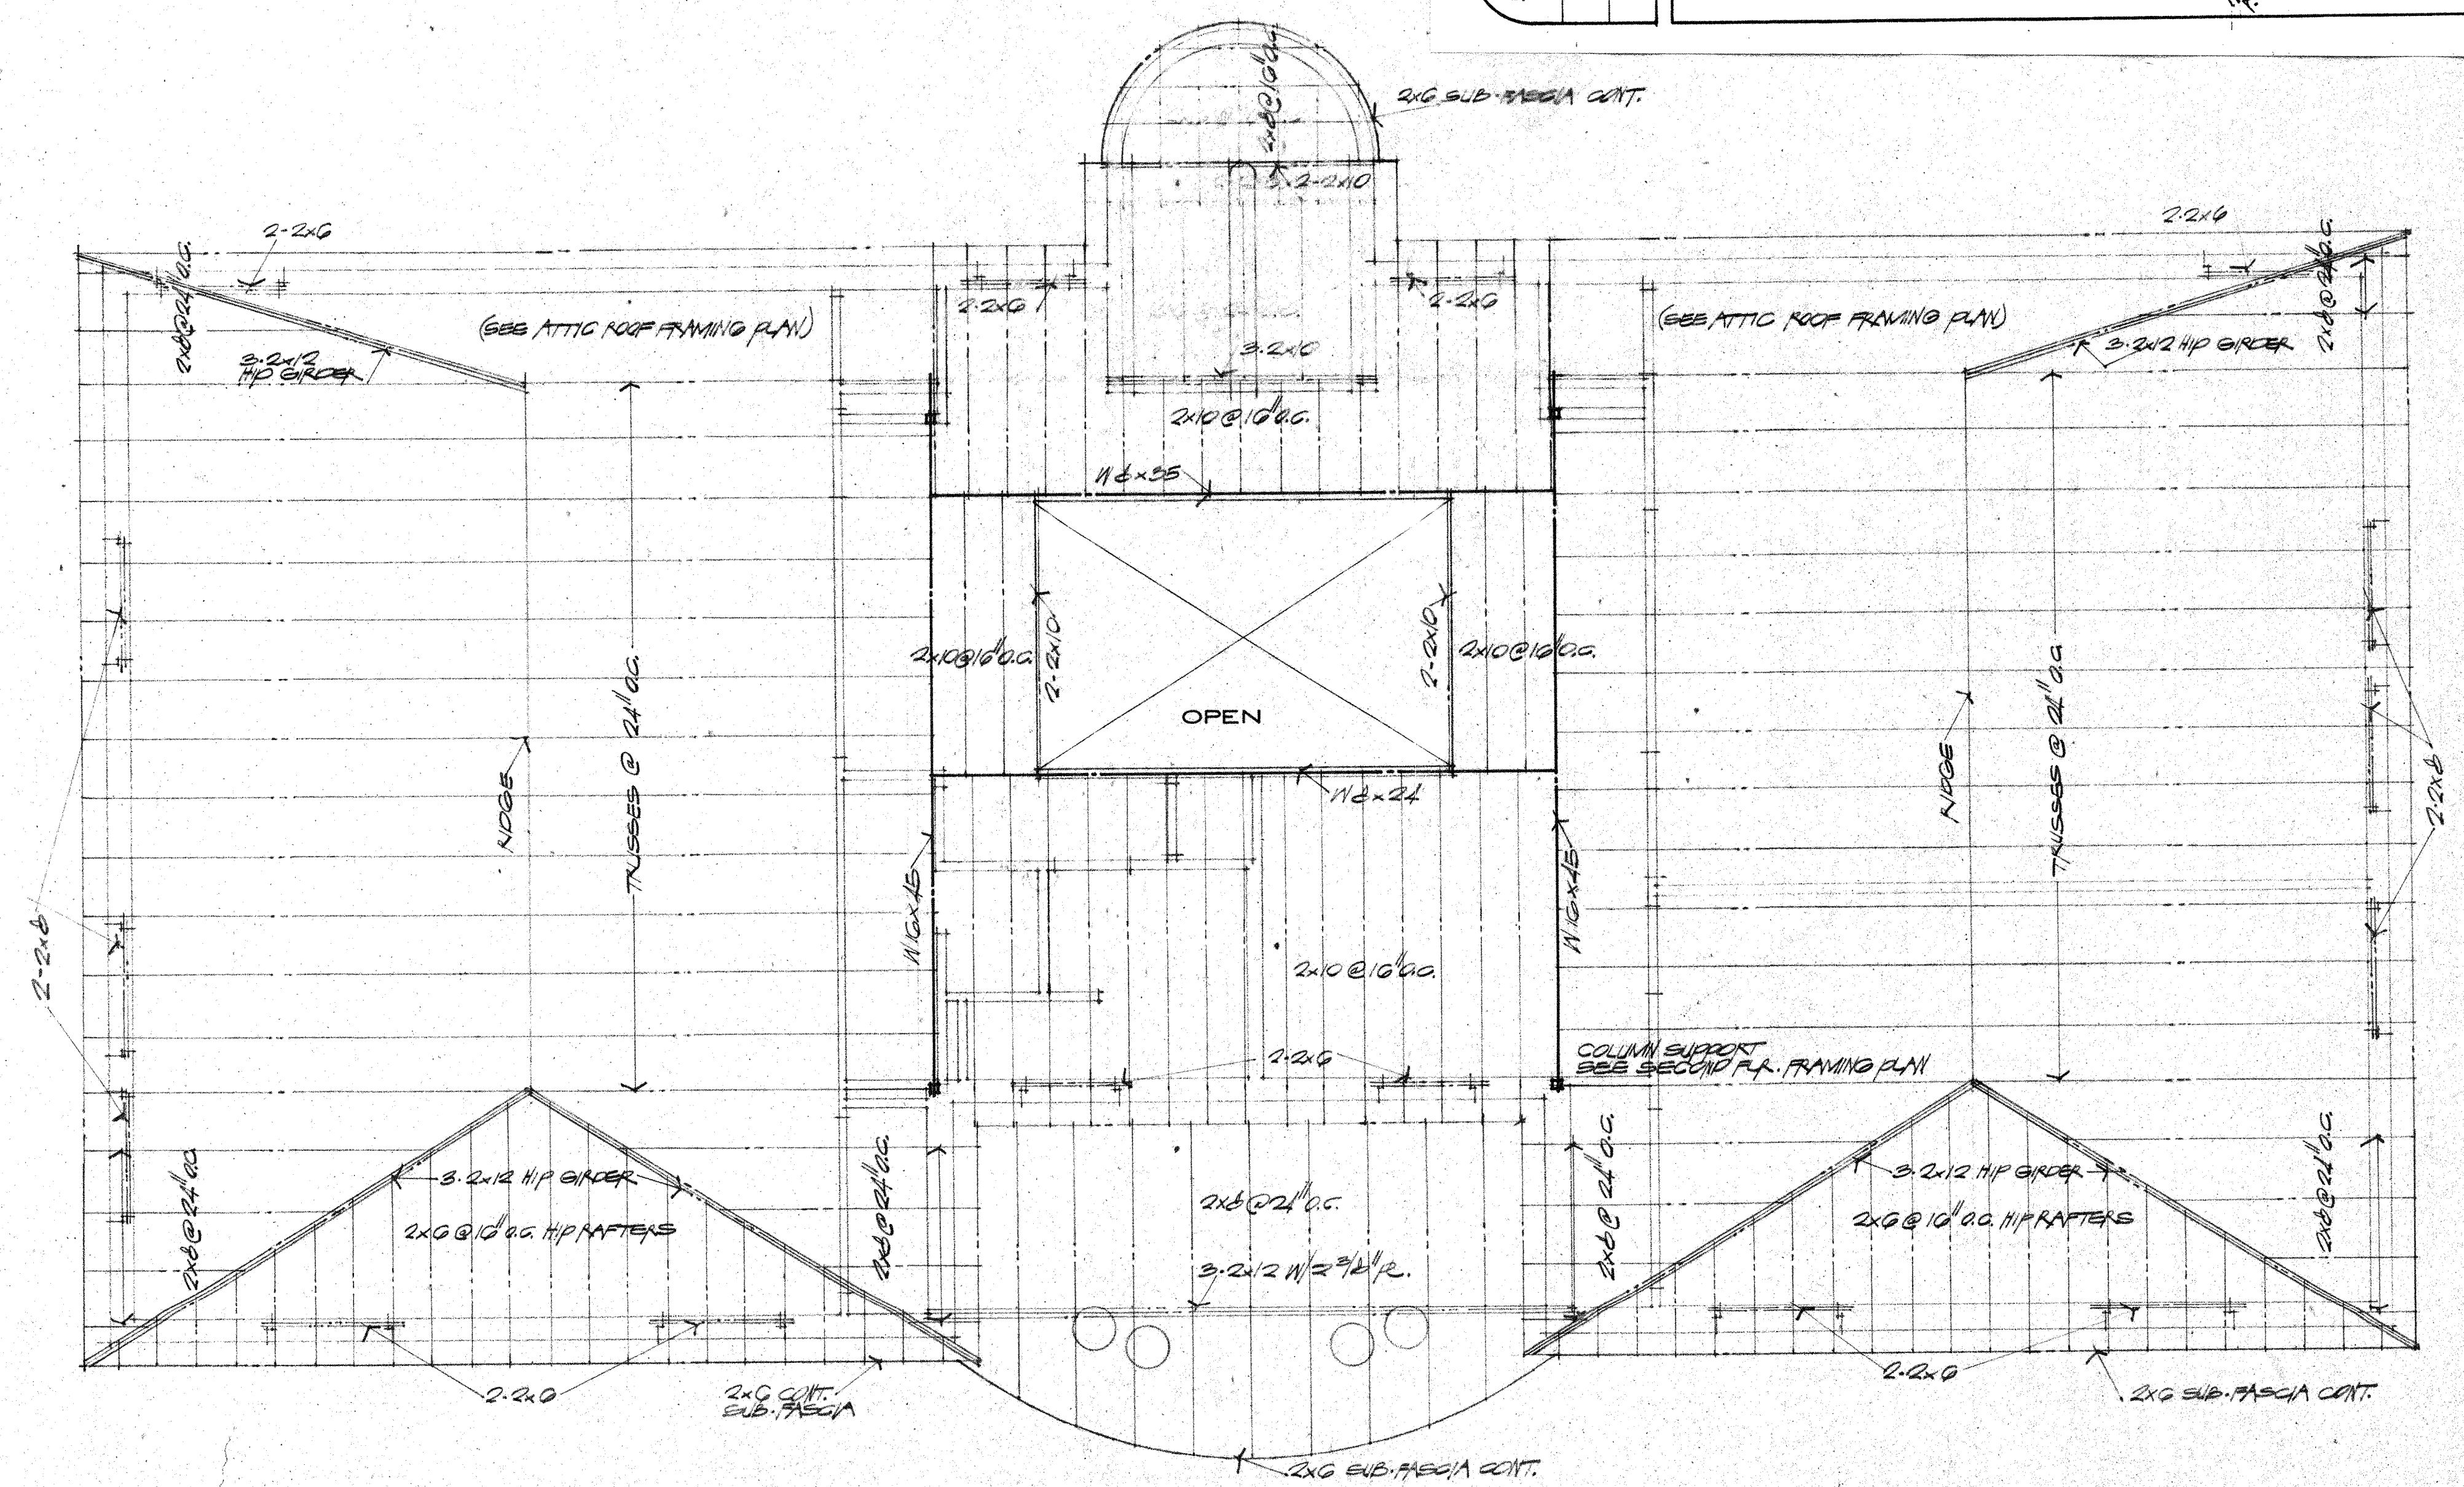

ATTIC FLOOR FRAMING PLAN 1/4" = 1' - 0"