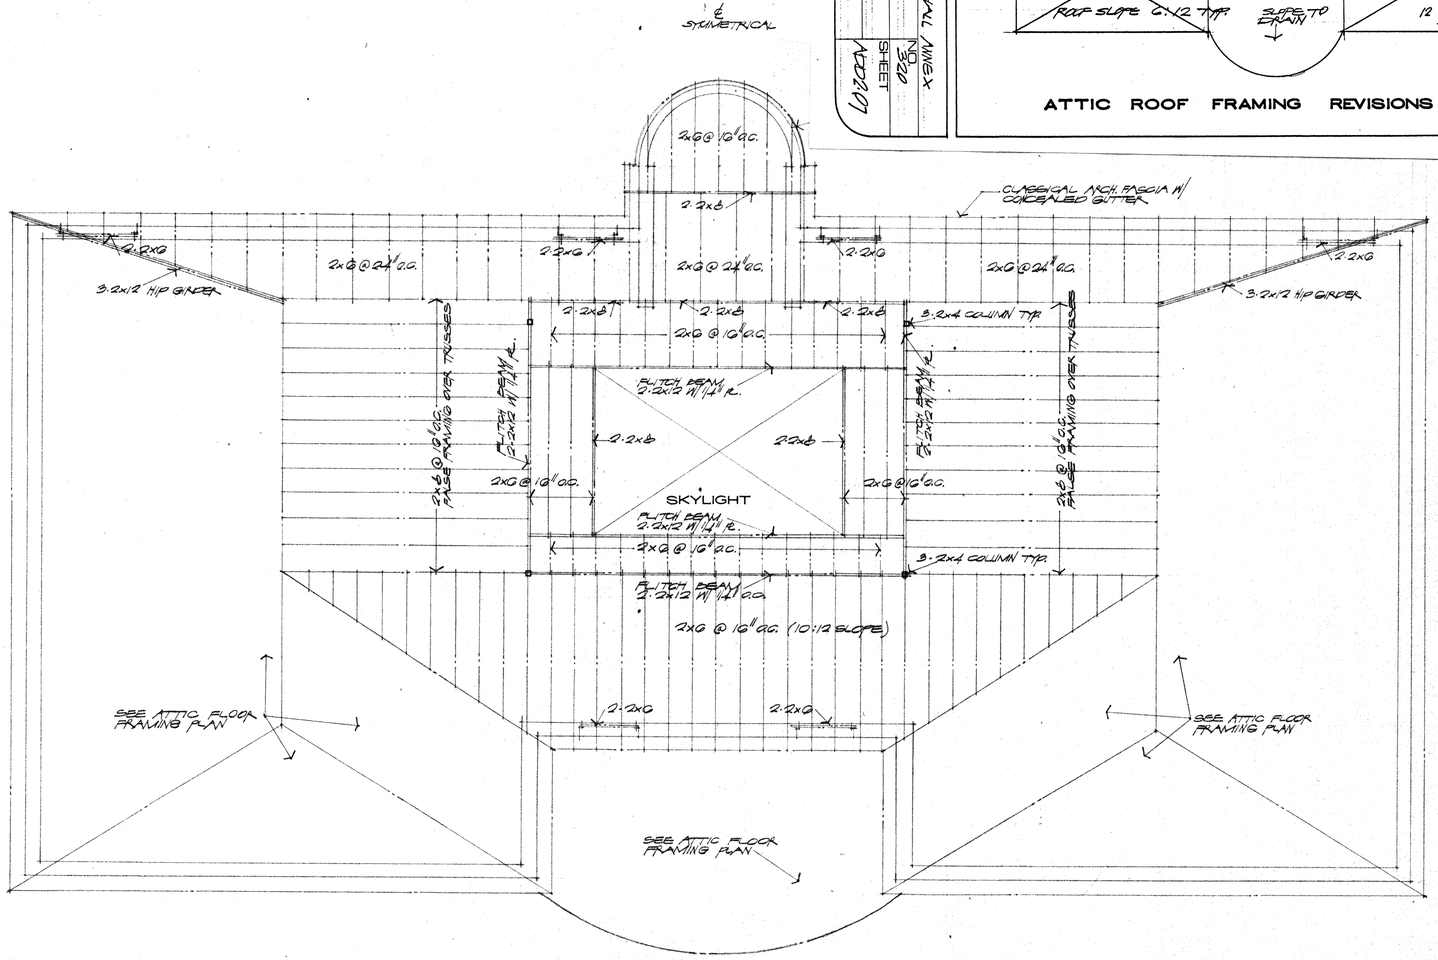

01 ATTIC ROOF FRAMING PLAN 1/4" = 1' - 0"

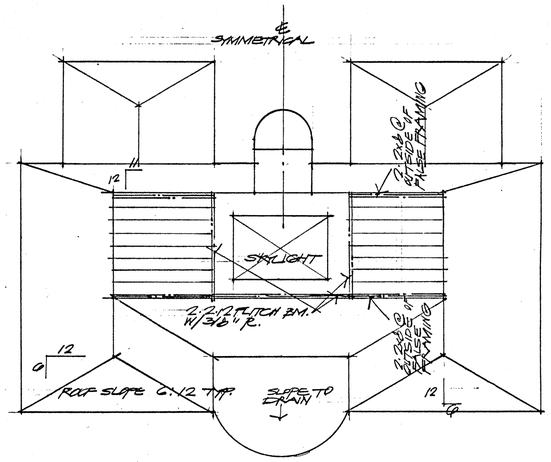

ATTIC ROOF FRAMING REVISIONS

SHEPHERD + BOYD, INC.
ARCHITECTS • PLANNERS • INTERIORS
8235 DOUGLAS AVE. SUITE 900
DALLAS, TEXAS 75225

PROJECT	ADDISON TOWN HALL ANNEX
DATE	15 JAN. 82
SCALE	3/32" = 1'-0"
BY	WSC
NO.	320
SHEET	ADD2.07

SHEPHERD + BOYD
ARCHITECTS/PLANNERS & INTERIORS
8235 DOUGLAS AVENUE
DOUGLAS BUILDING SUITE 900
DALLAS TEXAS 75225
TELEPHONE 214/691-9000

ADDISON TOWN HALL
ADDISON TEXAS

REVISIONS

DATE
JAN. 4, 1982

SHEET
A - 12