


SERIES	TYPE	ESP	HP	SEN	TOTAL	FEAT. IN	FUEL	VOCS/HR.	MPG.	MODEL
AC. 4	COMP. RM. 119	800	0.5	1/5	23,000	22,000	20,000 GAS	120		TRANE FFHE 029
AC. 6	COMP. RM. 121	800	0.5	1/5	23,000	22,000	20,000 GAS	120		TRANE FFHE 029

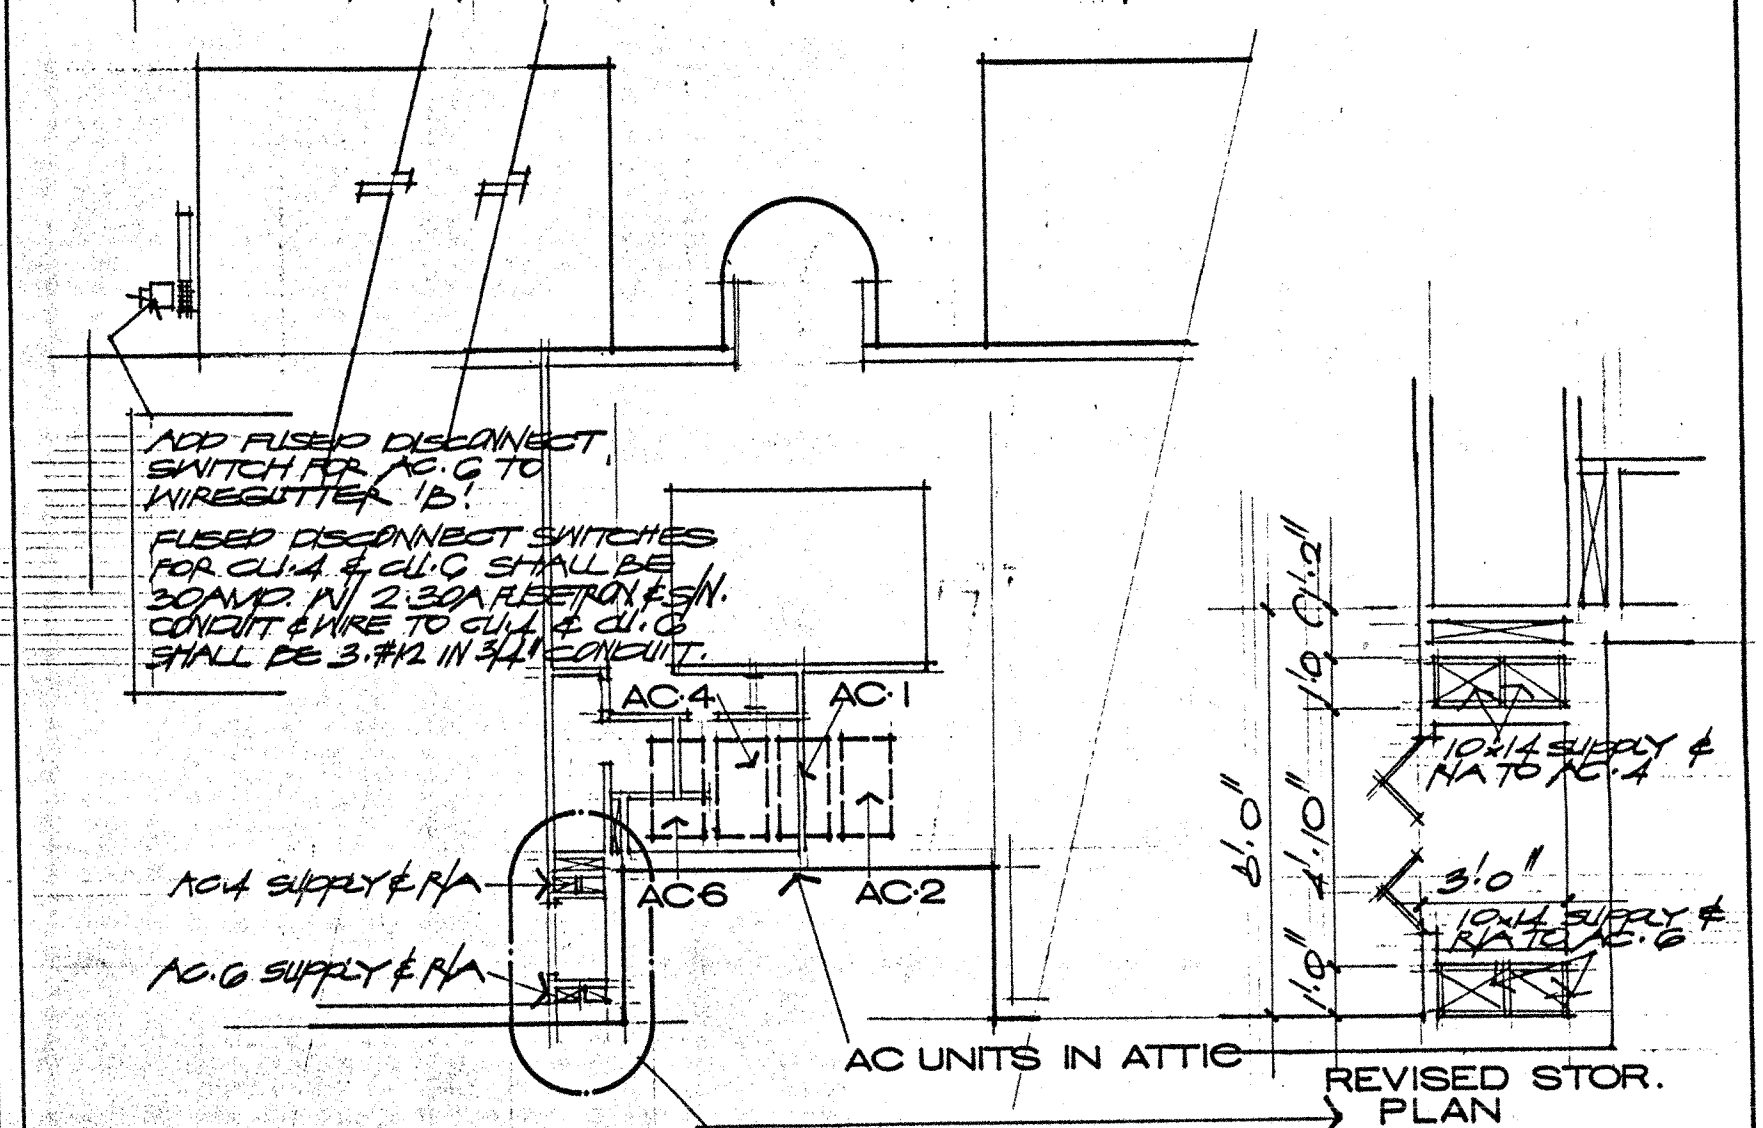


REVISED ATTIC MECH. PLAN

SHEPHERD + BOYD, INC.
ARCHITECTS • PLANNERS • INTERIORS
8235 DOUGLAS AVE. SUITE 800
DALLAS, TEXAS 75225

PROJECT: TOWN HALL ANNEX
NO. 320
DATE: JAN 82
SCALE: 1/4" = 1'-0"
SHEET: [Blank]
BY: [Signature]