


CONTINUE FABRICATED  
CLOSEURE PLATE TO CORNER

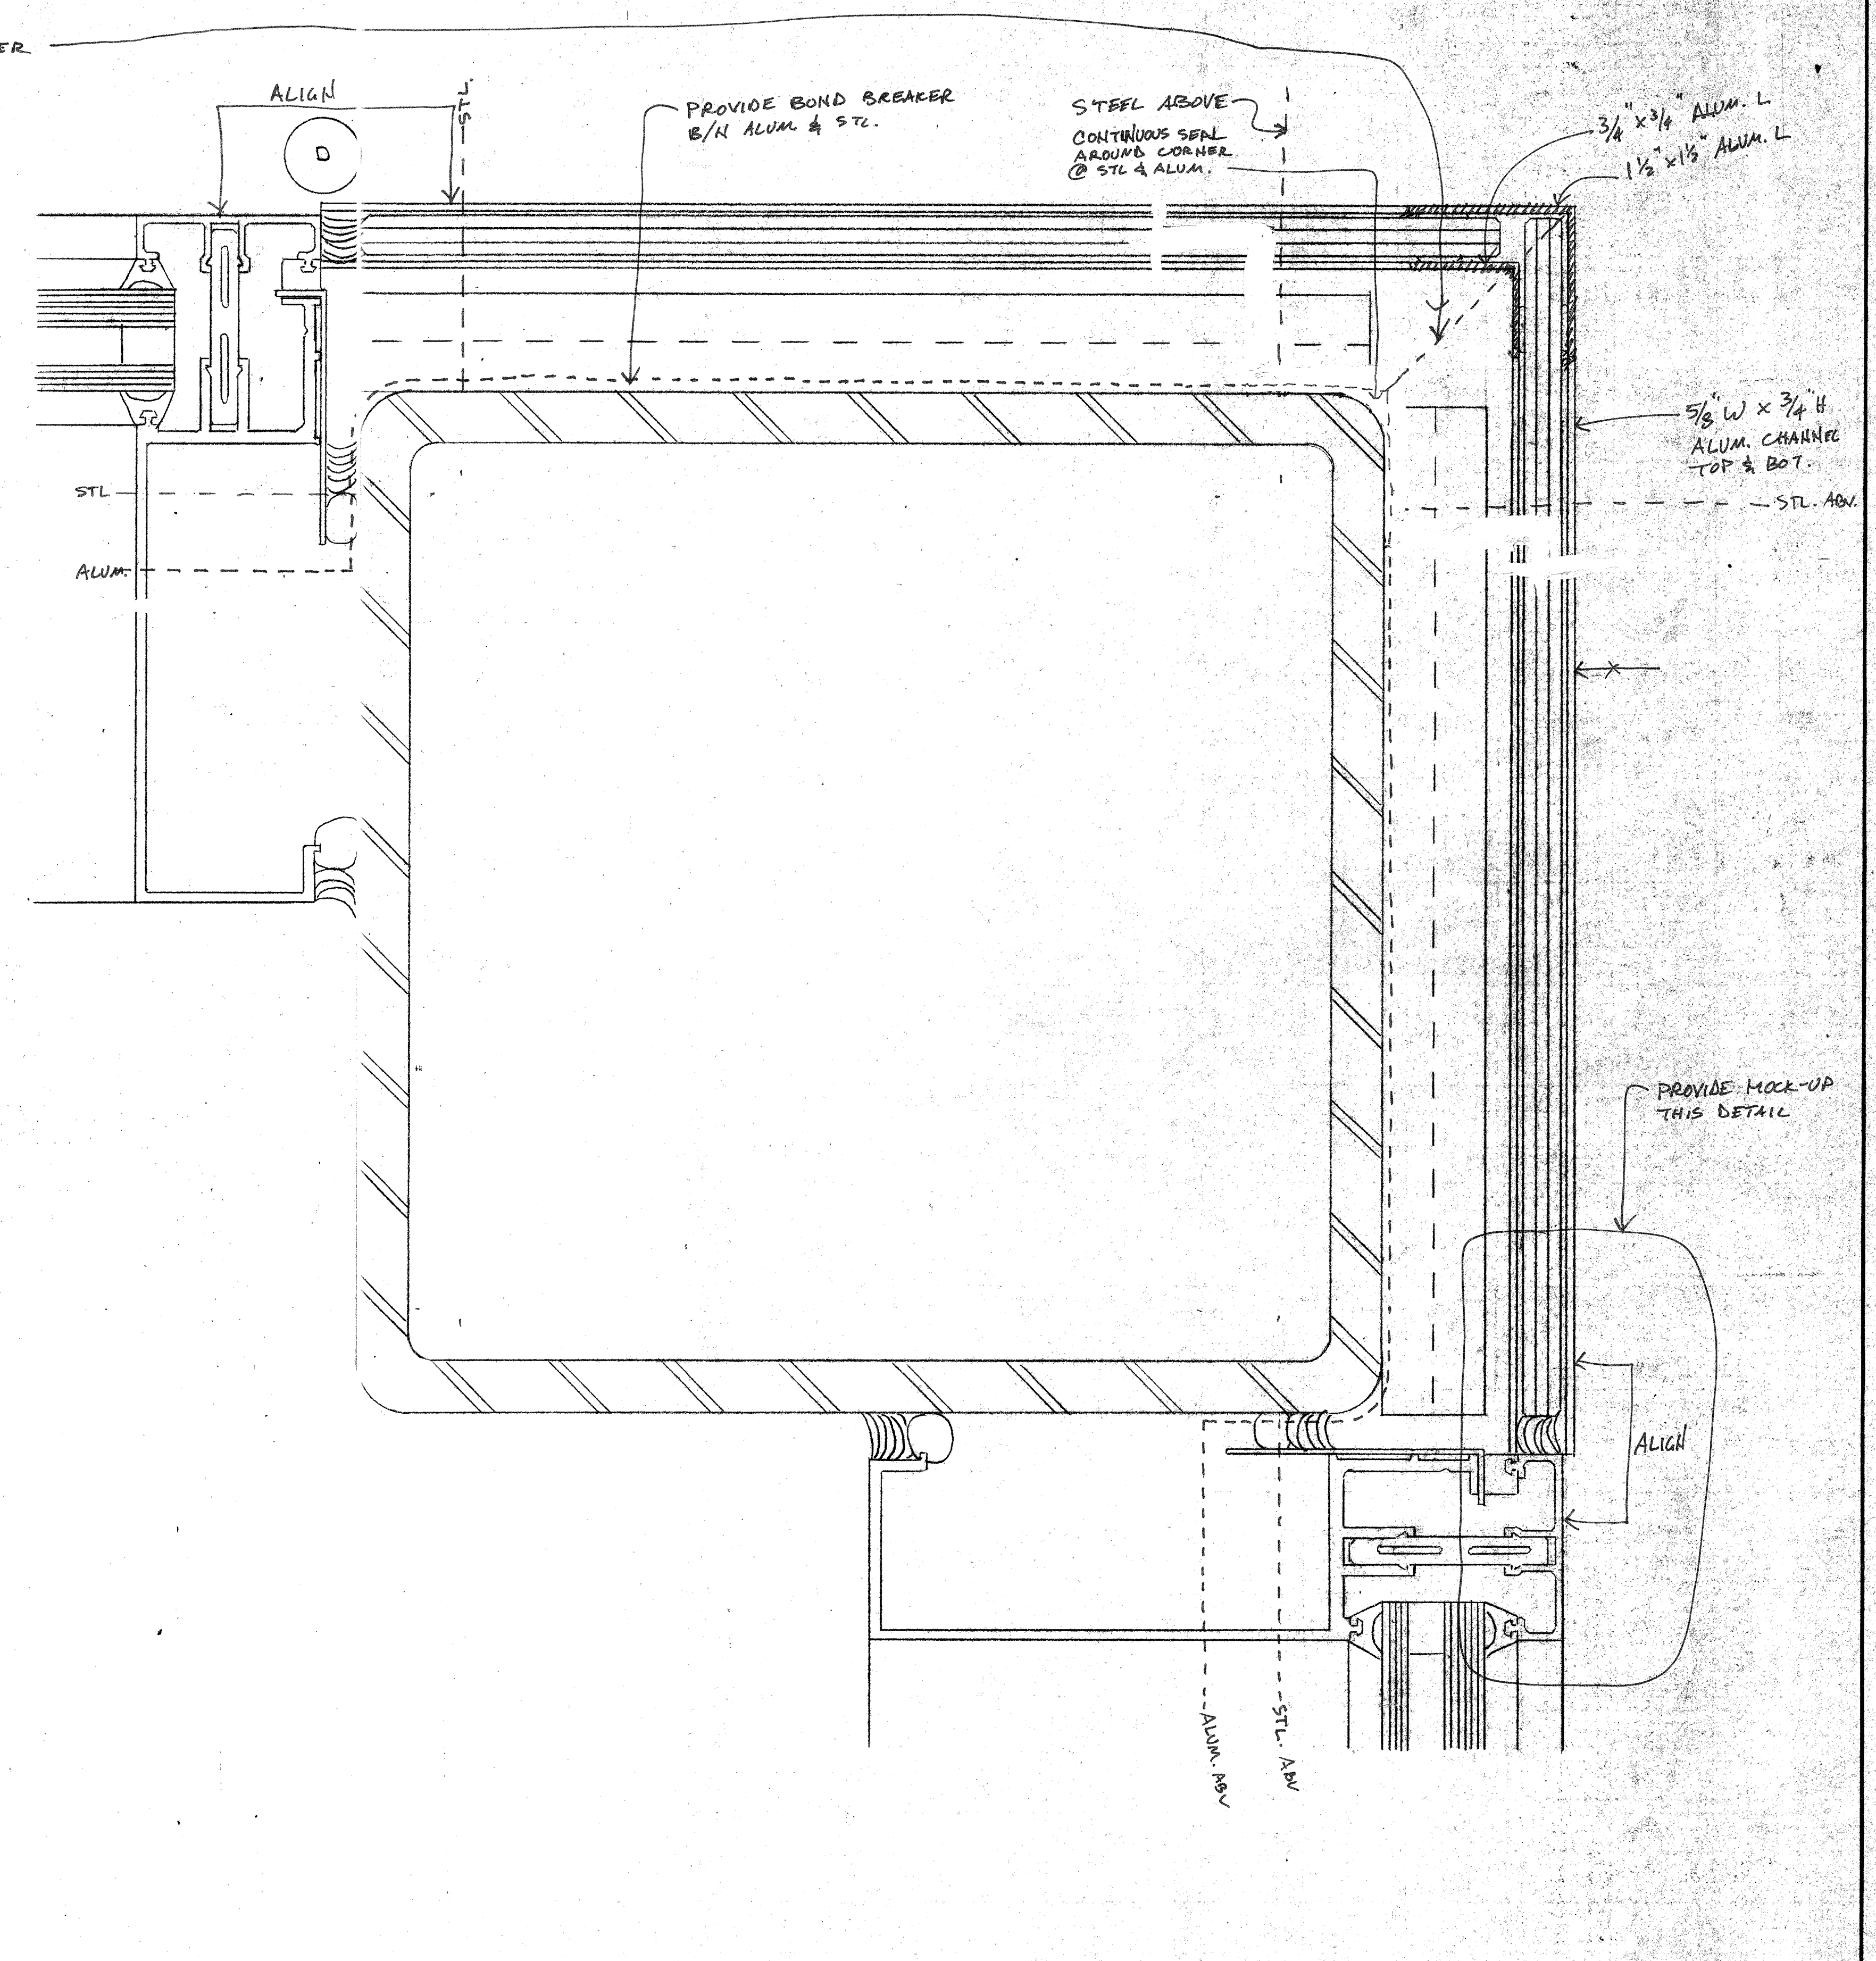

ADDISON ART AND EVENT PAVILION  
ADDISON, TEXAS

CUNNINGHAM ARCHITECT  
DALLAS, TEXAS

SCALE: FULL	APPROVED BY	DRAWN BY
DATE: 4-23-03		P. POTAMUS
BIG SKY CONSTRUCTION COMPANY, INC. SUNNYVALE, TEXAS		
INDUSTRIAL GLASS, INC. FORT WORTH, TEXAS		DRAWING NUMBER 4.047