
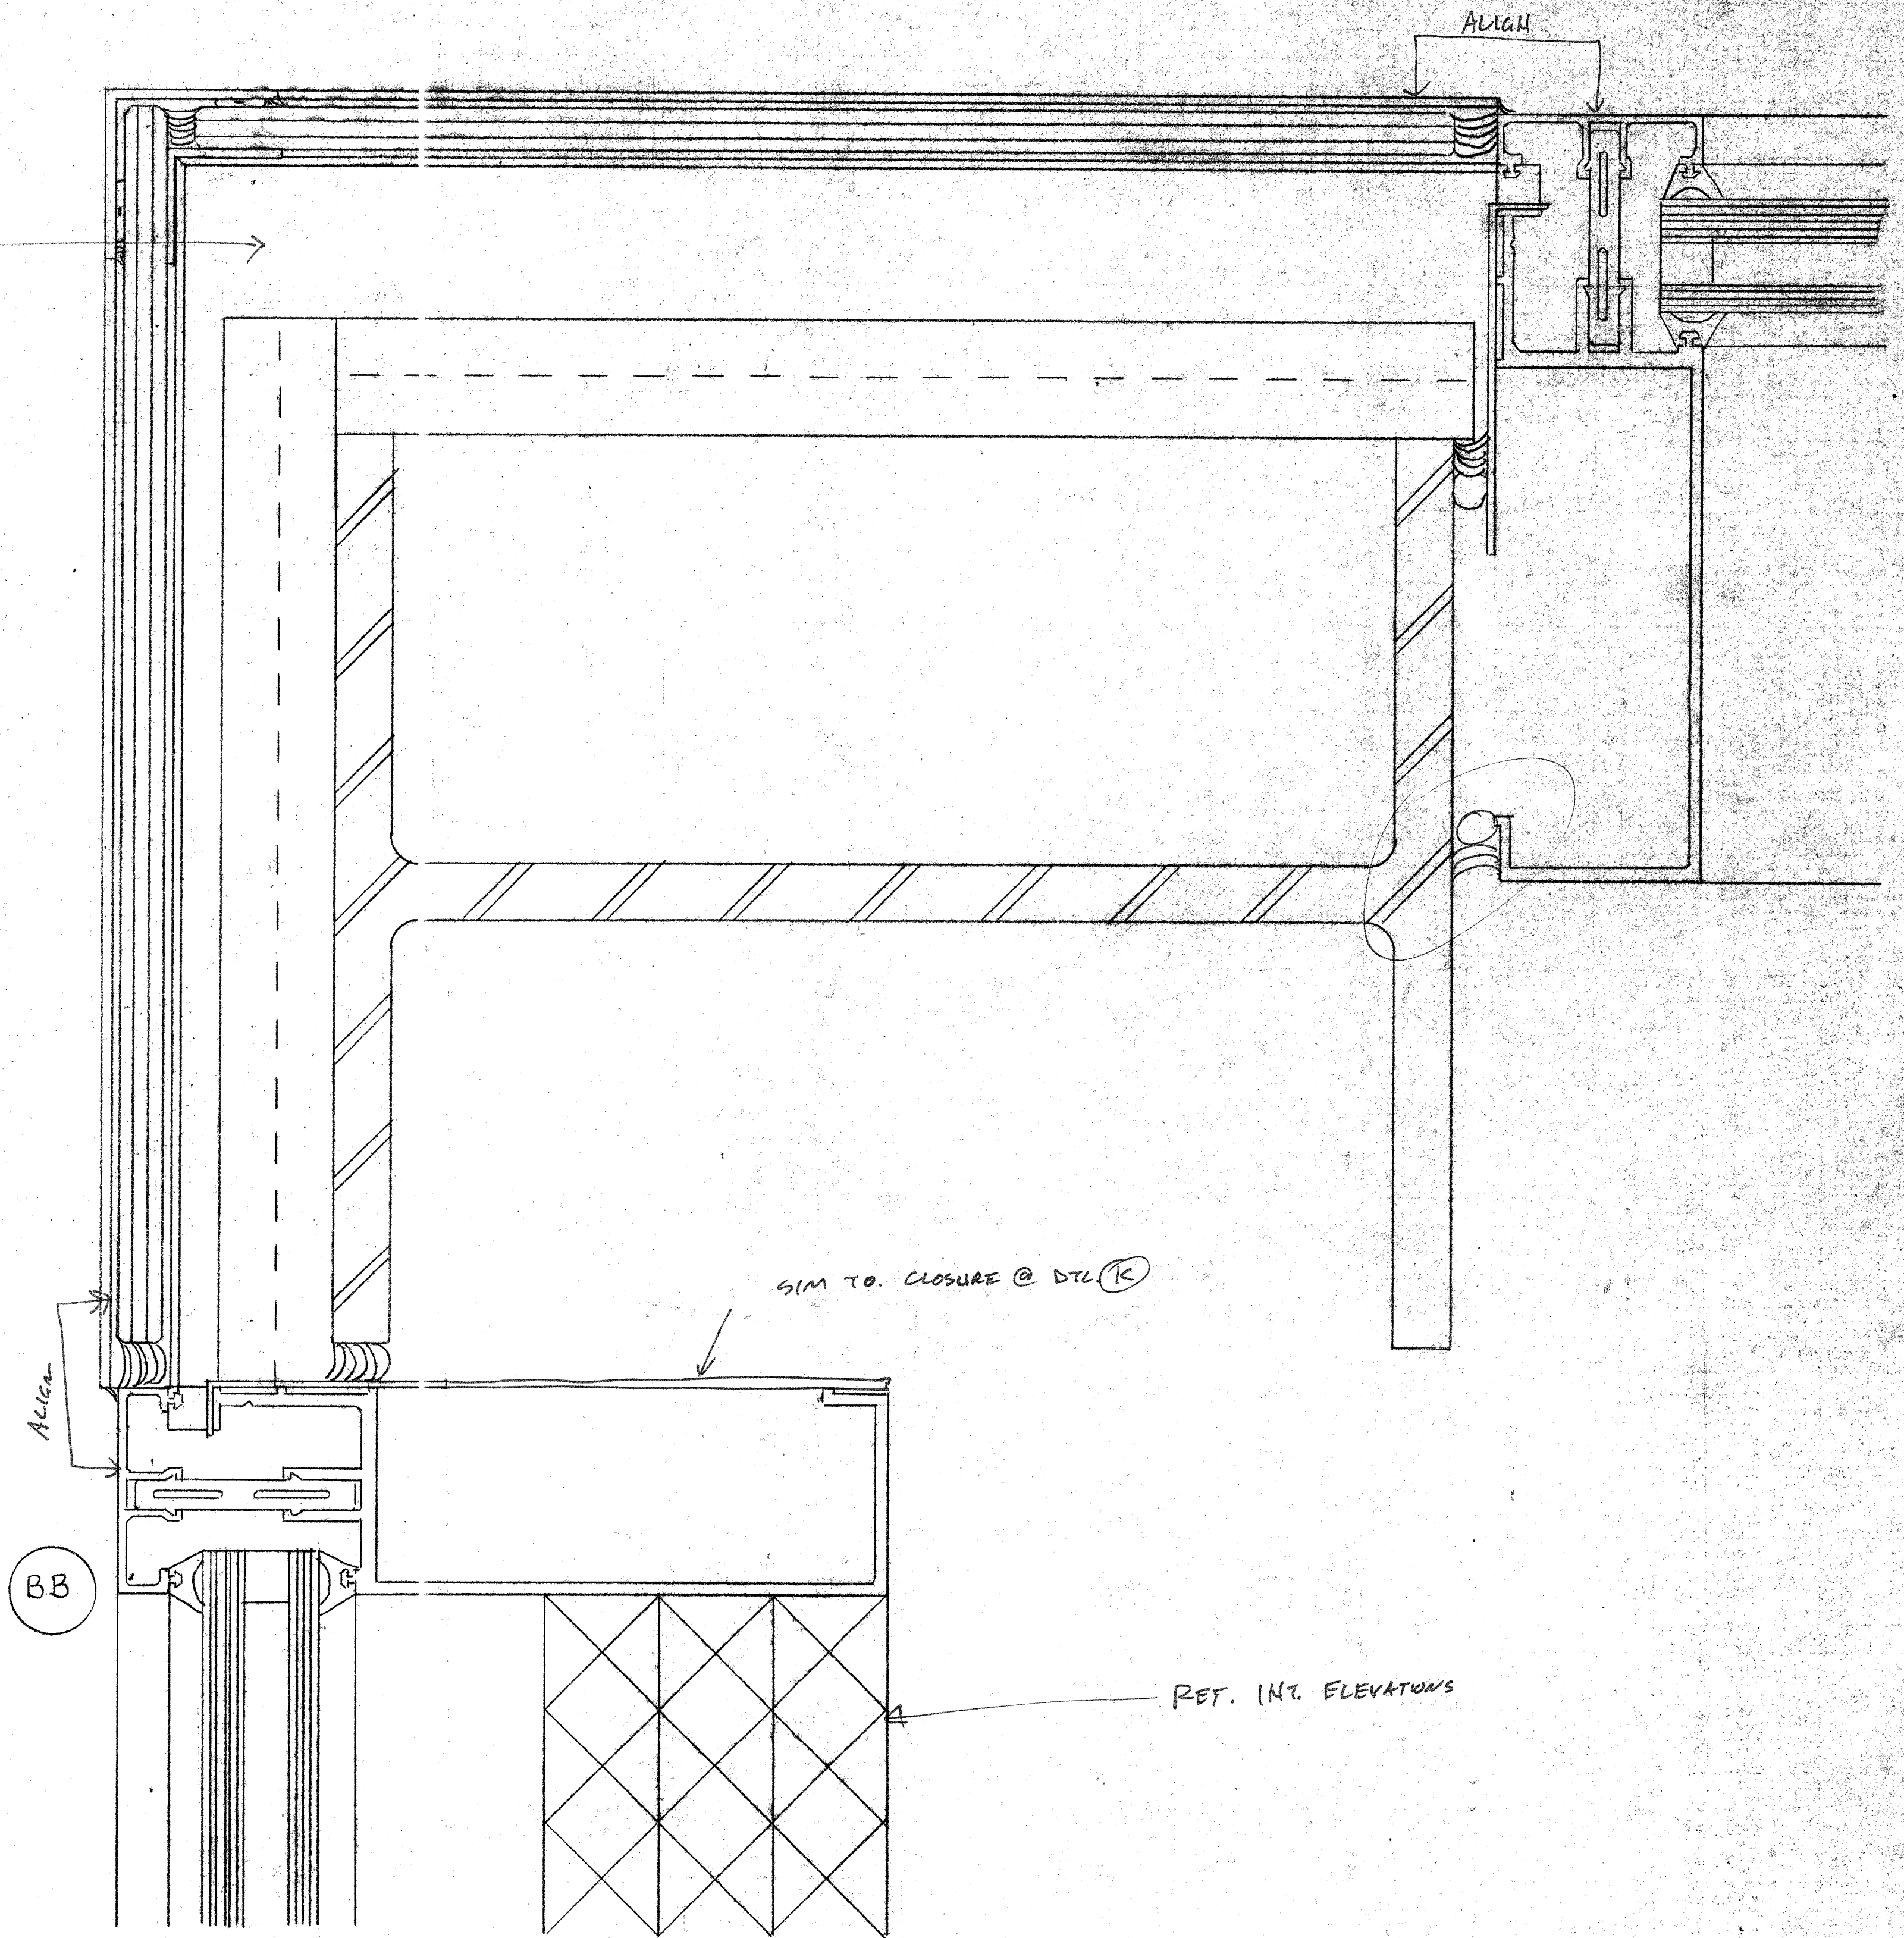
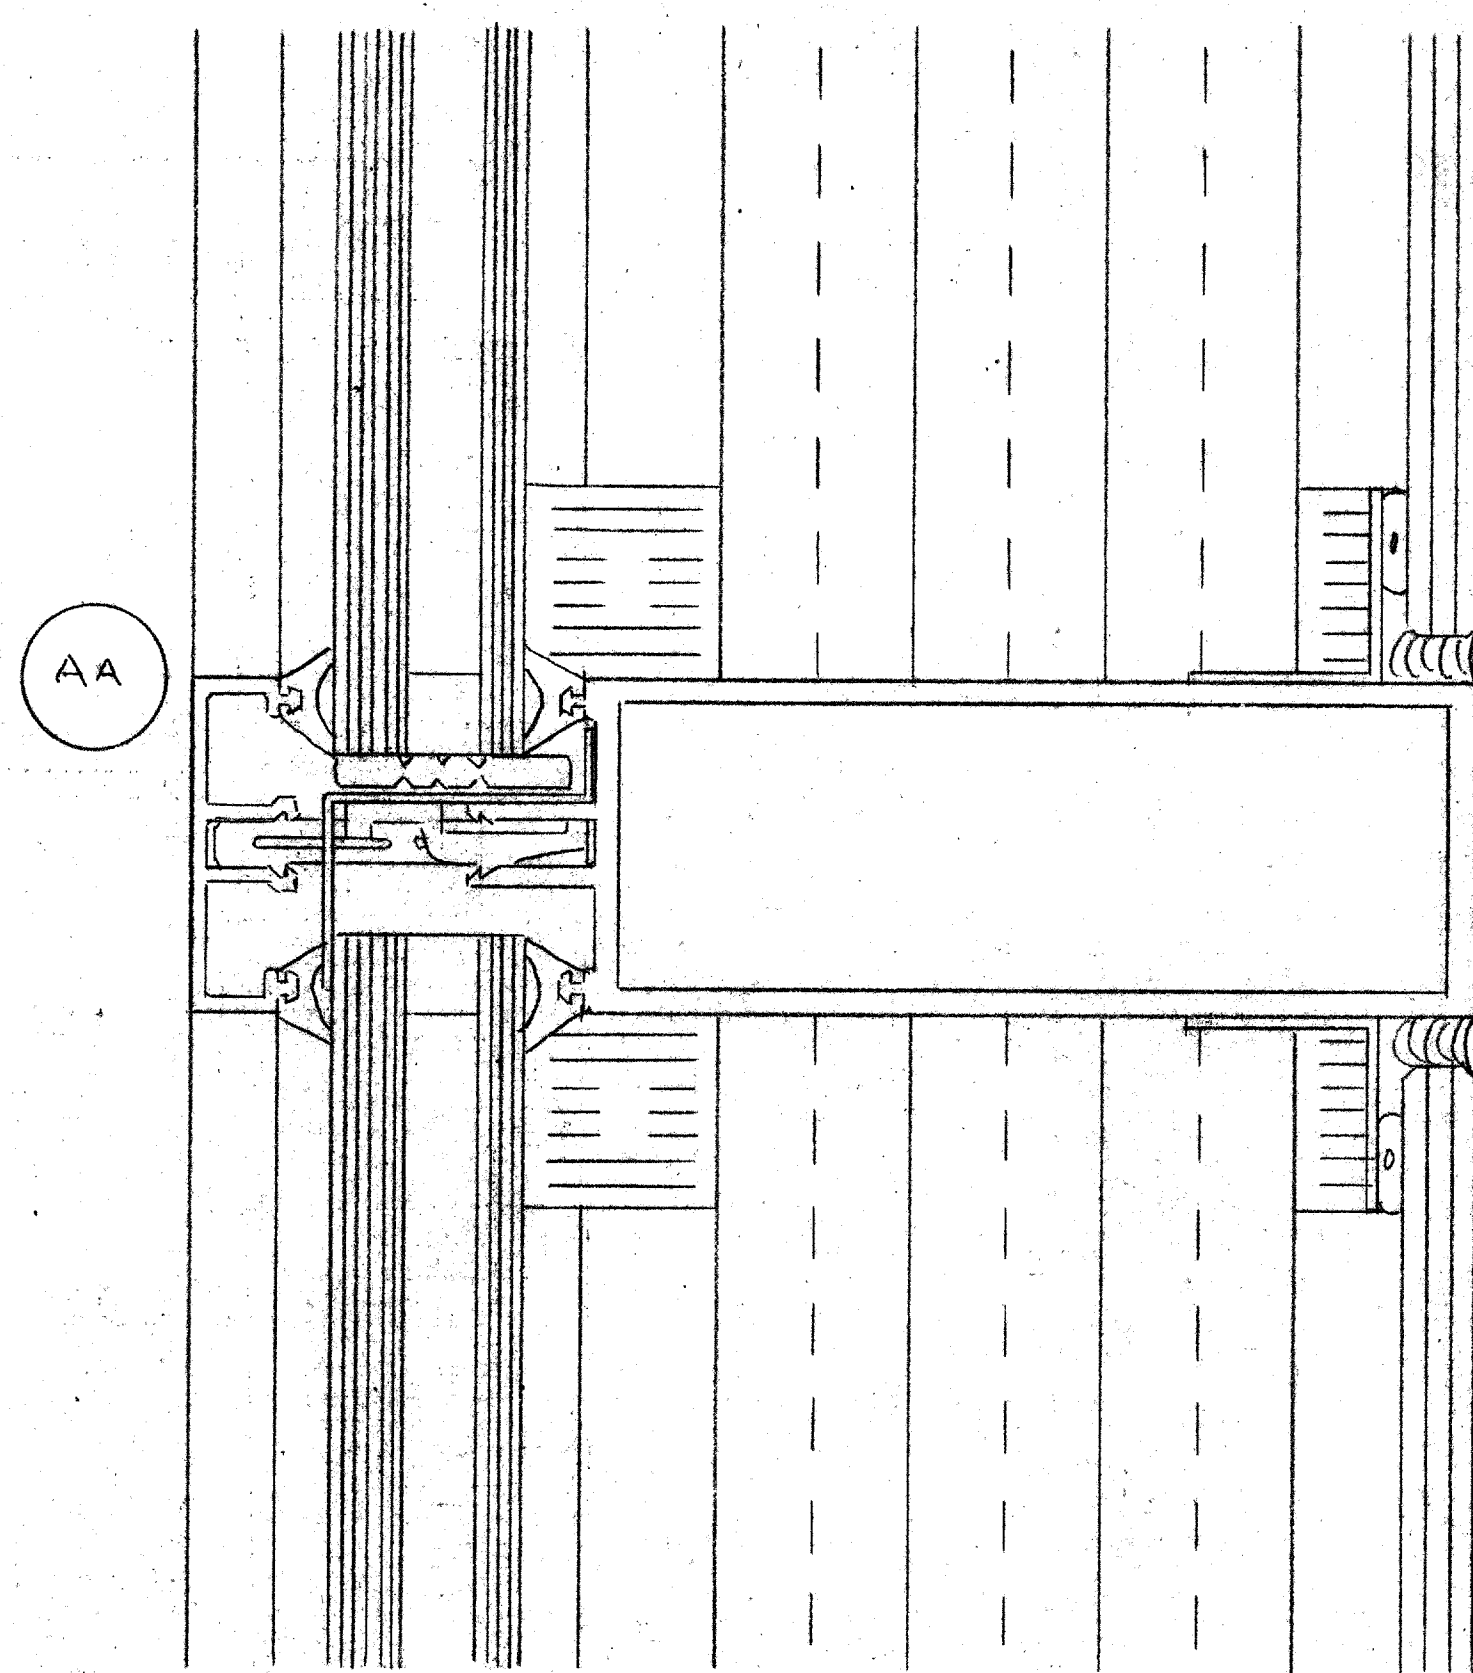


* NOTES SIM. DTL. (3)

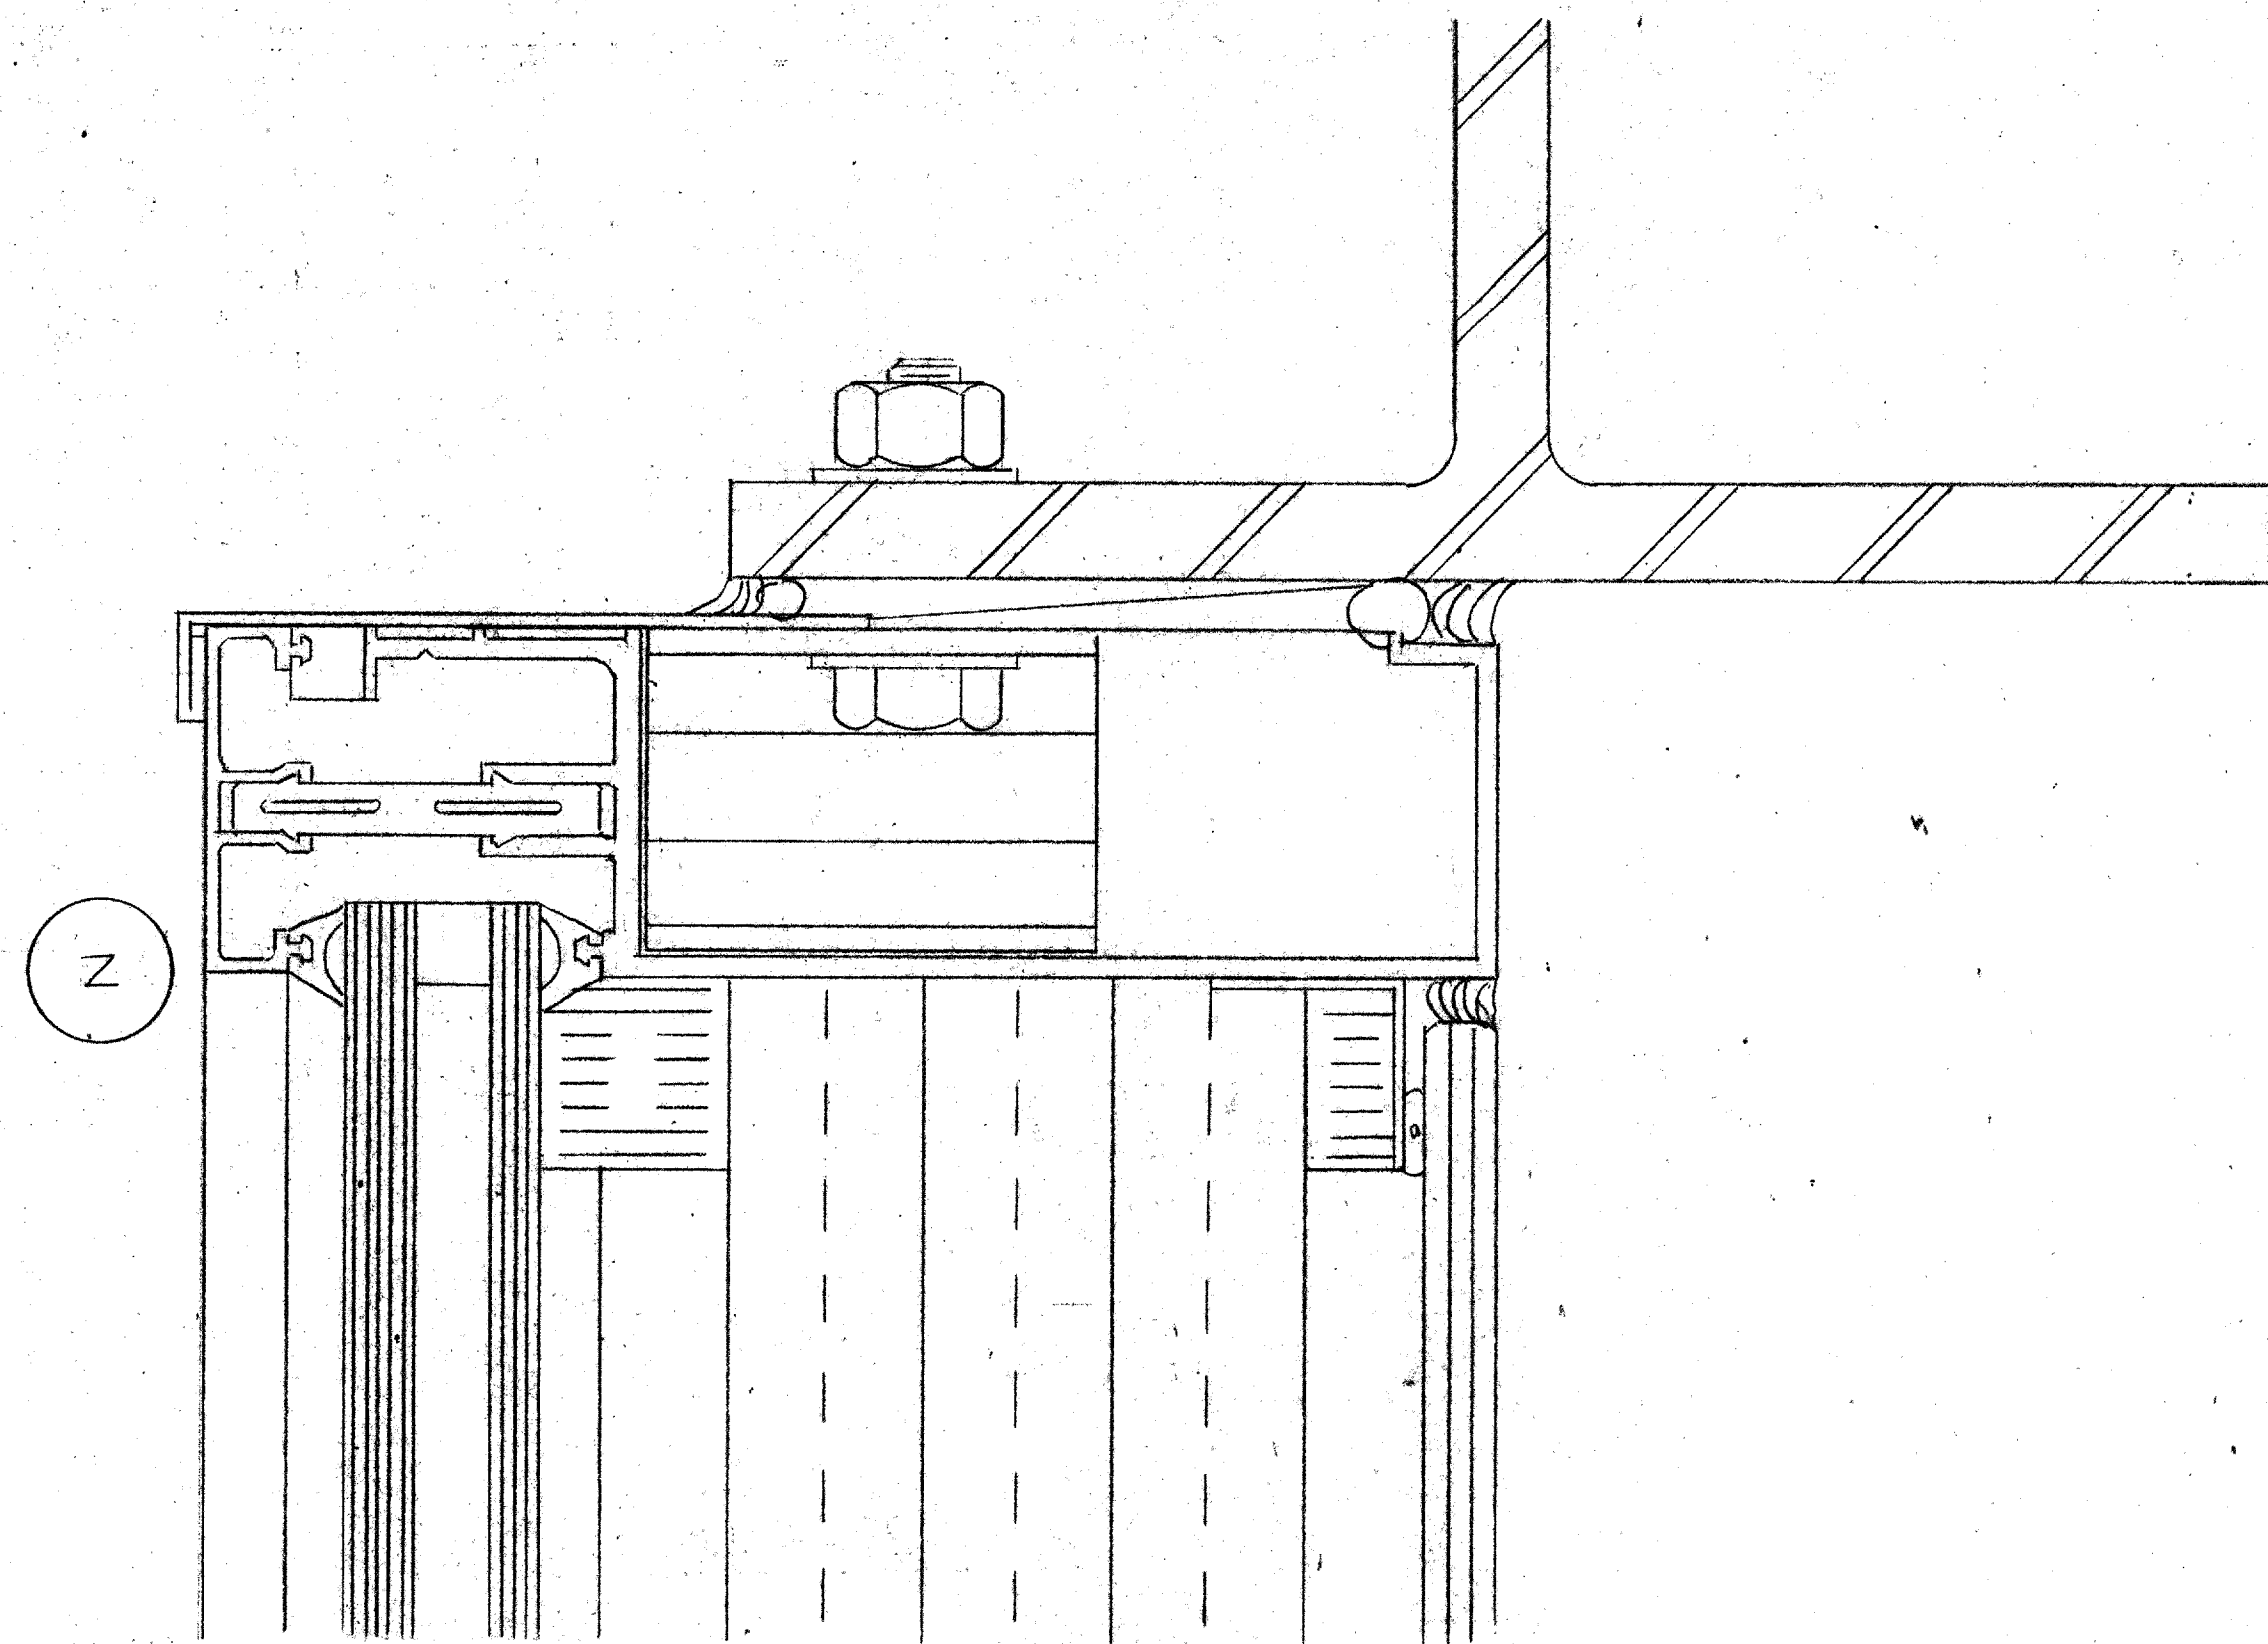

ADDISON ARTS AND EVENTS PAVILION
ADDISON, TEXAS

CUNNINGHAM ARCHITECTS
DALLAS, TEXAS

SCALE: FULL	APPROVED BY	DRAWN BY
DATE: 4-23-03		P. POTAMUS
BIG SKY CONSTRUCTION COMPANY, INC. SUNNYVALE, TEXAS		
INDUSTRIAL GLASS, INC. FORT WORTH TEXAS		DRAWING NUMBER 12 of 17