



B.M.  
629.60

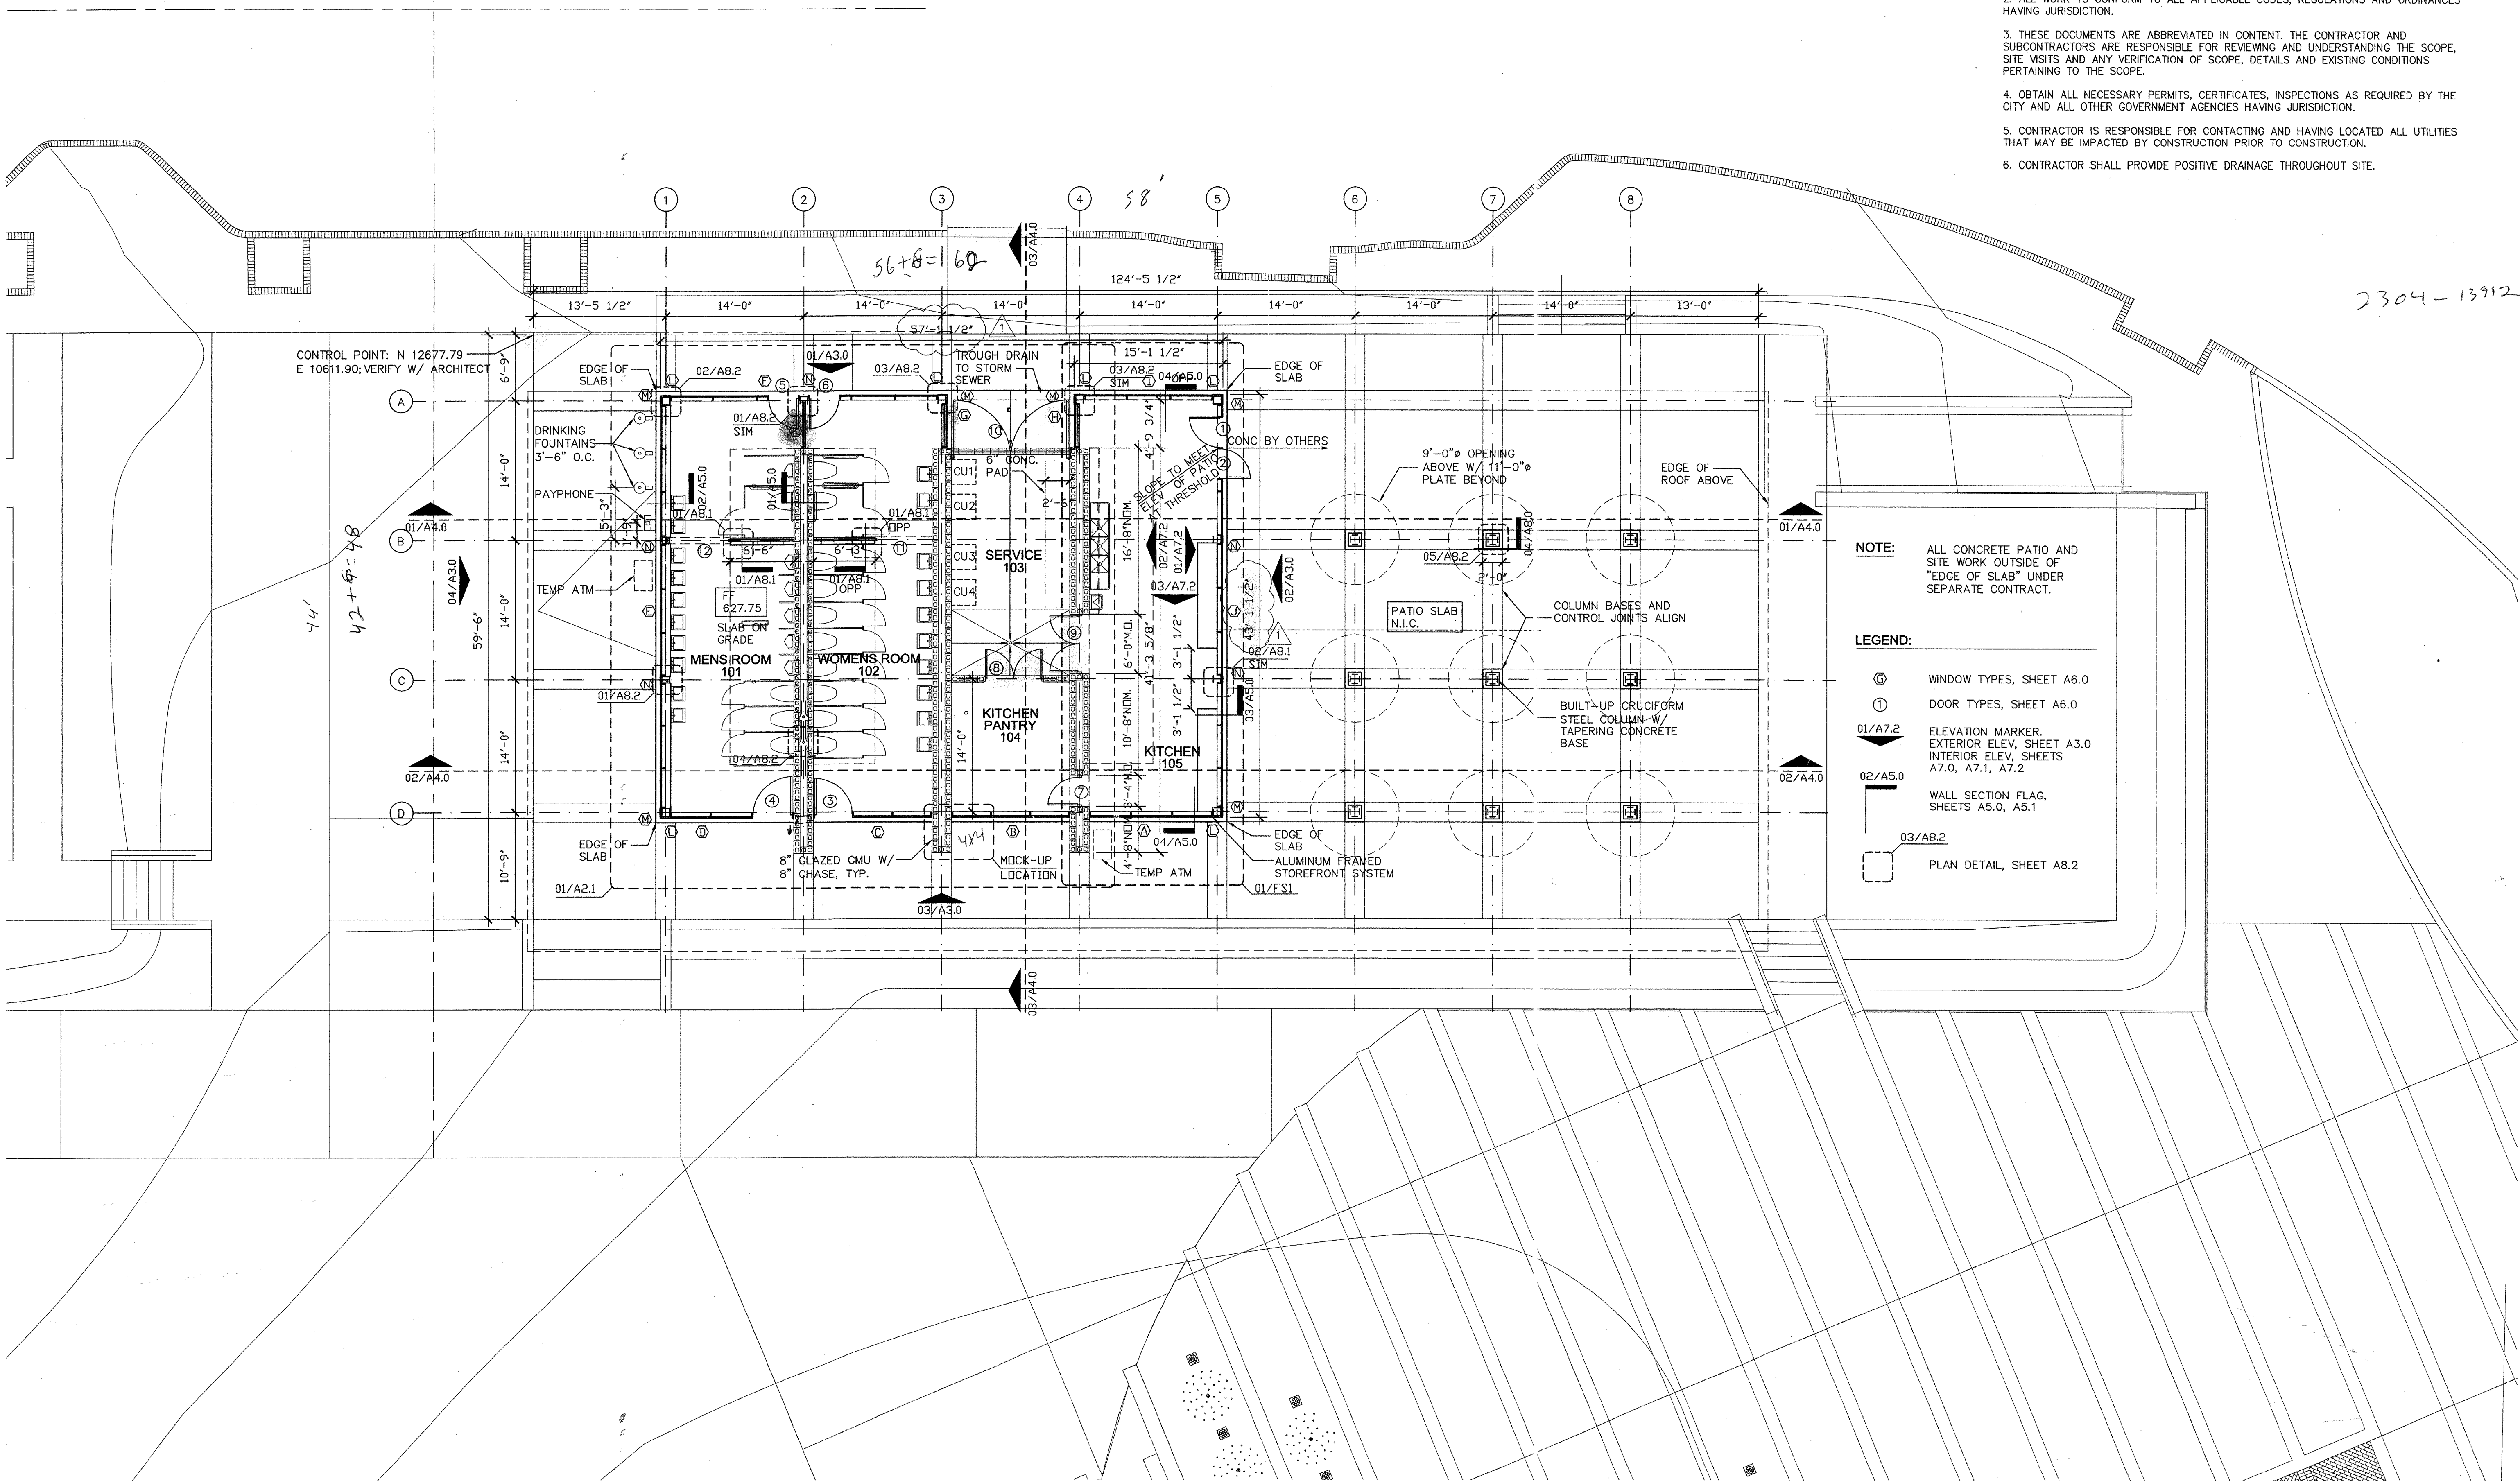

- GENERAL NOTES:
1. DO NOT SCALE DRAWINGS. BRING ANY DISCREPANCIES TO THE ATTENTION OF THE ARCHITECT.
  2. ALL WORK TO CONFORM TO ALL APPLICABLE CODES, REGULATIONS AND ORDINANCES HAVING JURISDICTION.
  3. THESE DOCUMENTS ARE ABBREVIATED IN CONTENT. THE CONTRACTOR AND SUBCONTRACTORS ARE RESPONSIBLE FOR REVIEWING AND UNDERSTANDING THE SCOPE, SITE VISITS AND ANY VERIFICATION OF SCOPE, DETAILS AND EXISTING CONDITIONS PERTAINING TO THE SCOPE.
  4. OBTAIN ALL NECESSARY PERMITS, CERTIFICATES, INSPECTIONS AS REQUIRED BY THE CITY AND ALL OTHER GOVERNMENT AGENCIES HAVING JURISDICTION.
  5. CONTRACTOR IS RESPONSIBLE FOR CONTACTING AND HAVING LOCATED ALL UTILITIES THAT MAY BE IMPACTED BY CONSTRUCTION PRIOR TO CONSTRUCTION.
  6. CONTRACTOR SHALL PROVIDE POSITIVE DRAINAGE THROUGHOUT SITE.

2304-13912

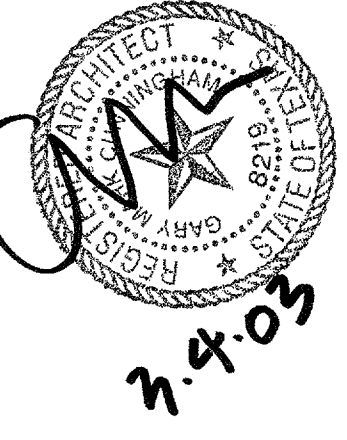

**cunningham architects**  
 918 Dragon Street  
 Dallas, Texas 75207  
 V 214.916.0900  
 F 214.916.0901

B.M.  
622.45

**NOTE:** ALL CONCRETE PATIO AND SITE WORK OUTSIDE OF "EDGE OF SLAB" UNDER SEPARATE CONTRACT.

**LEGEND:**

- ⊙ WINDOW TYPES, SHEET A6.0
- ⓪ DOOR TYPES, SHEET A6.0
- 01/A7.2 ELEVATION MARKER, EXTERIOR ELEV., SHEET A3.0  
INTERIOR ELEV., SHEETS A7.0, A7.1, A7.2
- 02/A5.0 WALL SECTION FLAG, SHEETS A5.0, A5.1
- 03/A8.2 PLAN DETAIL, SHEET A8.2

**Addison Arts and Events Pavilion**  
 4970 Addison Circle Drive  
 Addison, Texas

date	issue
08/28/02	DD
11/05/02	50% CD
01/23/03	100% CD
01/31/03	ADDENDUM 1

**1 FLOOR PLAN**  
 1/8"=1'-0"

N  
**A1.0**  
 FLOOR PLAN