
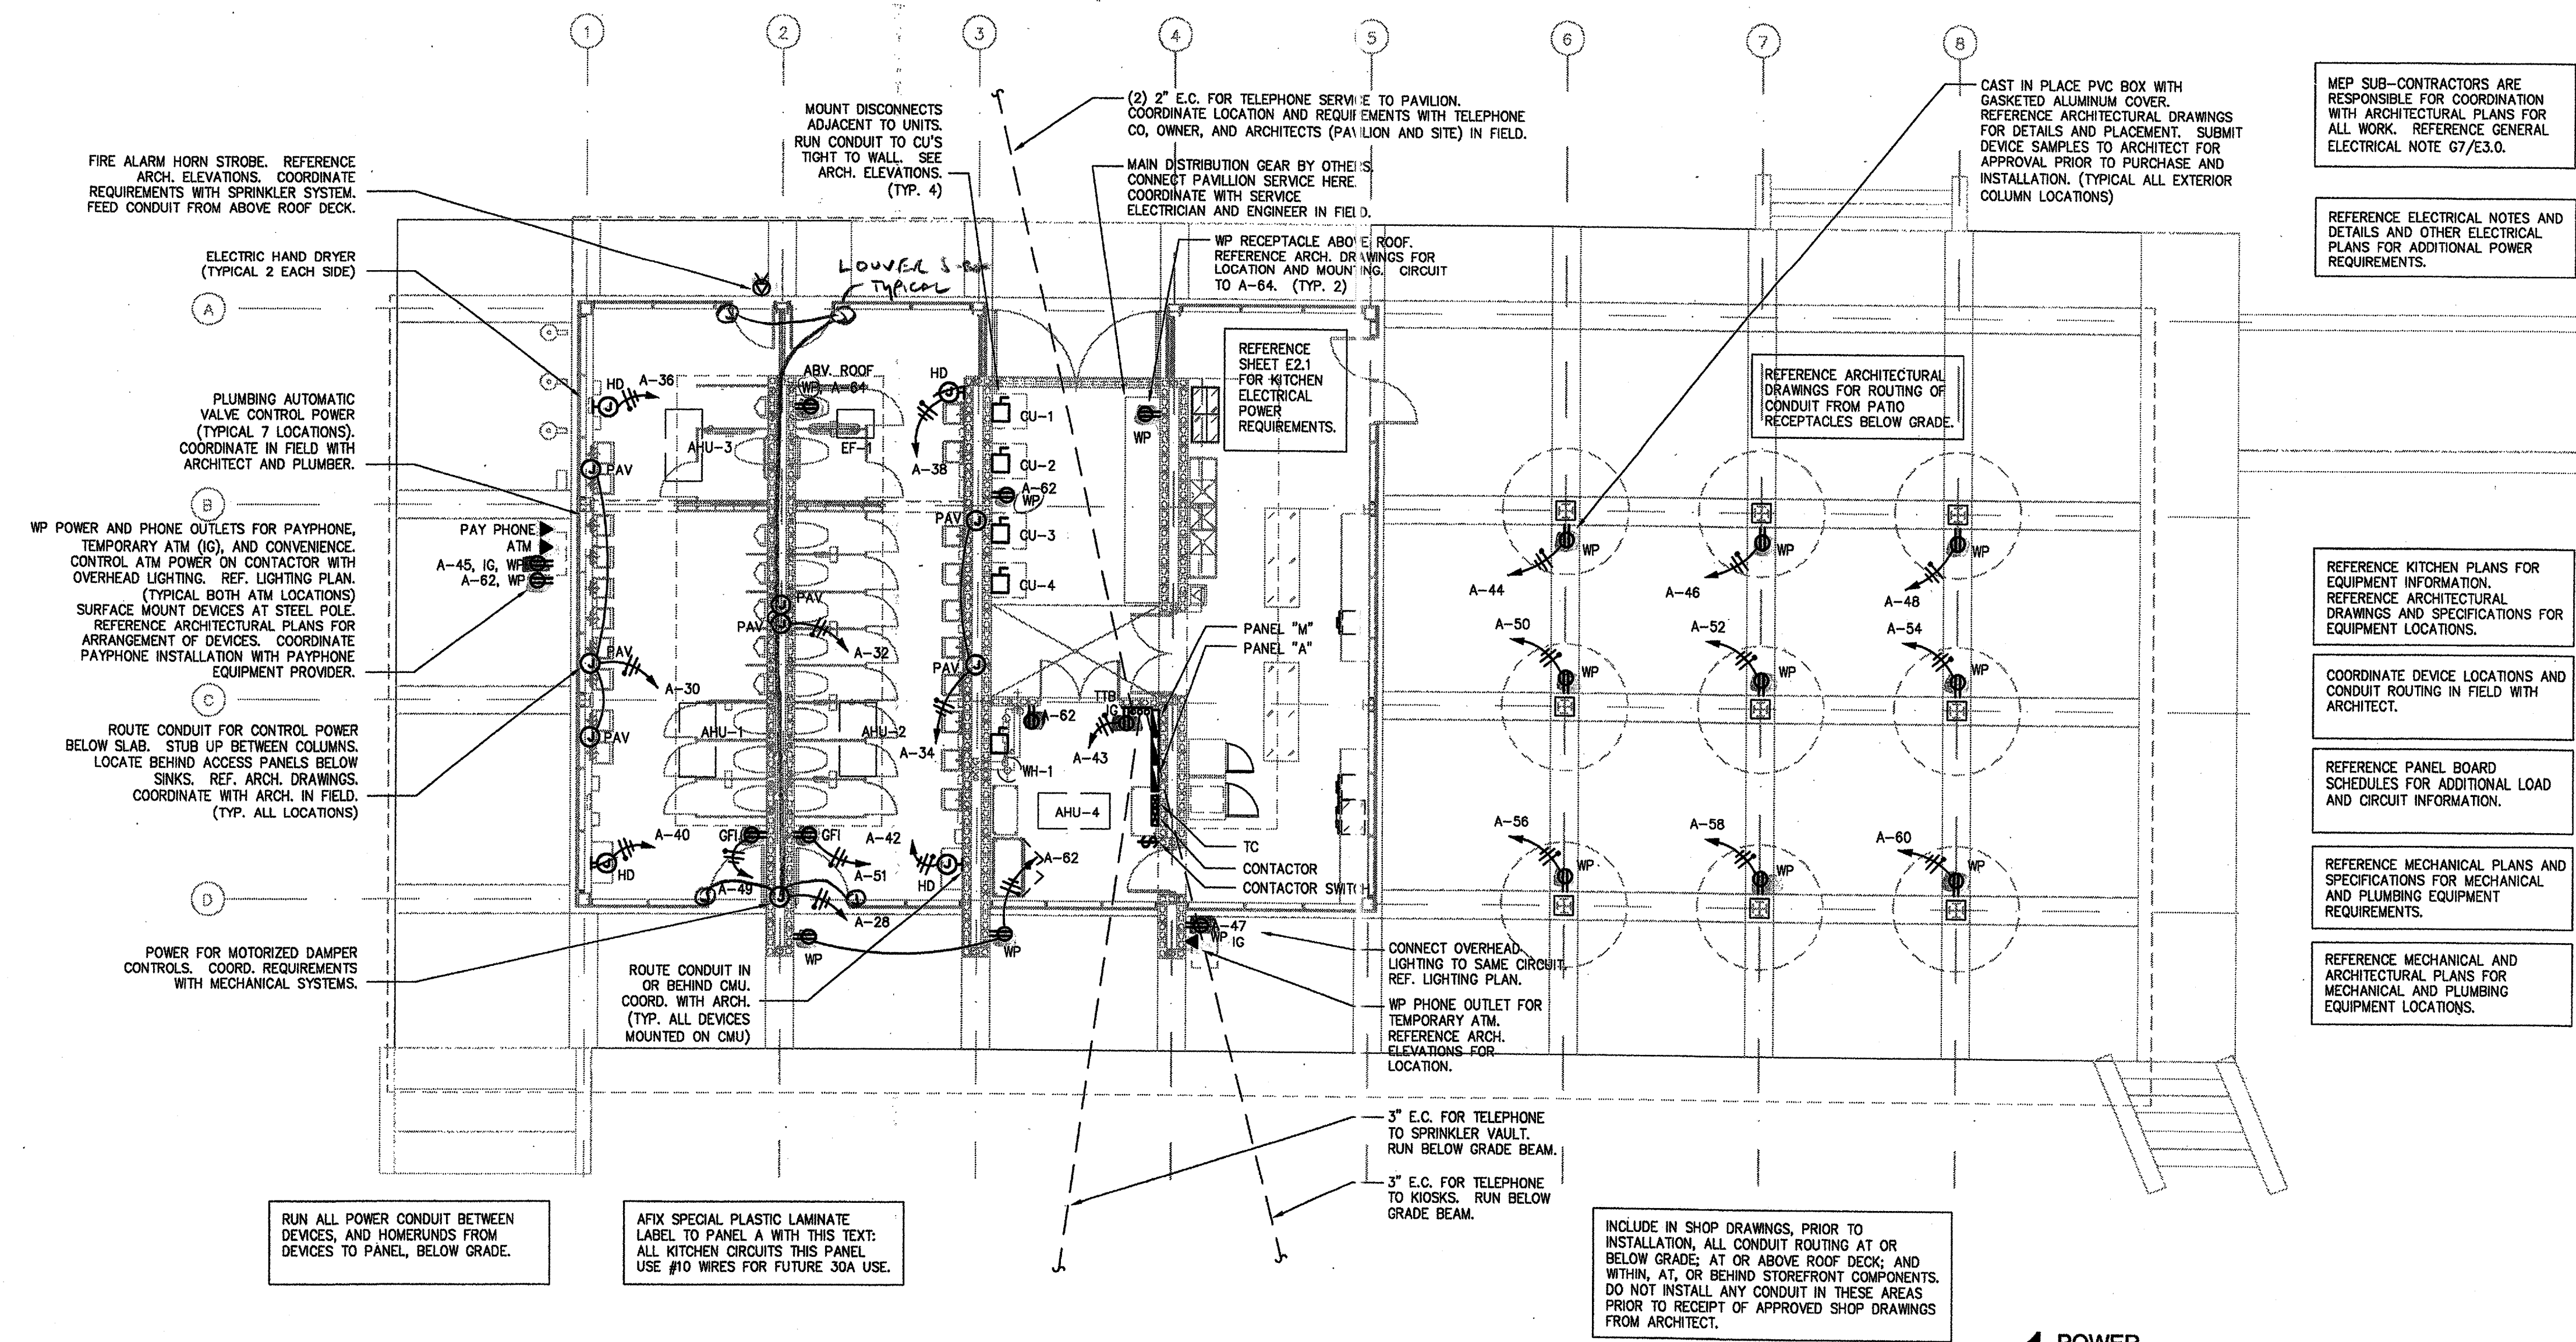


MECHANICAL EQUIPMENT SCHEDULE																			
PLAN MARK	EQUIPMENT DESCRIPTION/CATALOG NO.	LOCATION	MECHANICAL DATA				ELECTRICAL DATA							COMMENTS					
			VOLTS	PHASE	MOTOR HP	HEAT KW	STARTER	DISCONNECT	MAX DC PD	PANEL SERVED FROM	CIRCUIT	WIRES	COND						
AHU-1	AHU W/ HEAT FAN HEAT		208	3	0.5	2.2	13	36.1	48	M	00	E	60	50	50	M	1/3/5	3 #6, 1 #10G	1
AHU-2	AHU W/ HEAT FAN HEAT		208	3	0.5	2.2	9	24.1	33	M	00	E	60	35	35	M	7/9/11	3 #6, 1 #10G	0.75
AHU-3	AHU W/ HEAT FAN HEAT		208	3	0.5	2.2	9	24.1	33	M	00	E	60	35	35	M	113/15/17	3 #6, 1 #10G	0.75
AHU-4	AHU W/ HEAT FAN HEAT		208	3	0.8	3.1	19	51.9	69	M	00	E	100	80	70	M	19/21/23	3 #4, 1 #6G	1.25
CU-1	COMPRESSOR CONDENSER FAN		208	3					22	M		E	30	35	30	M	2/4/6	3 #10, 1 #10G	0.75
CU-2	COMPRESSOR CONDENSER FAN		208	3					15	M		E	30	25	20	M	8/10/12	3 #12, 1 #10G	0.5
CU-3	COMPRESSOR CONDENSER FAN		208	3					15	M		E	30	25	20	M	14/16/18	3 #12, 1 #10G	0.5
CU-4	COMPRESSOR CONDENSER FAN		208	3					26	M		E	60	40	35	M	20/22/24	3 #10, 1 #10G	0.75
EF-1	MOTOR		120	1	0.8	13.2			17	E	M	E	30	30	20	A	67	2 #12, 1 #10G	0.5
WH-1	WATER HEATER STORAGE		208	3			18	50.0	62			E		70	70	M	125/27/29	3 #4, 1 #6G	1.25

JOB NAME: PAVILION - LOCATION: ADDISON - JOB NUMBER: 02098 - MECHANICAL ENGINEER: MBP - ELECTRICAL: WMS - FILE NAME: 02098MES.W01 22-Dec-2002

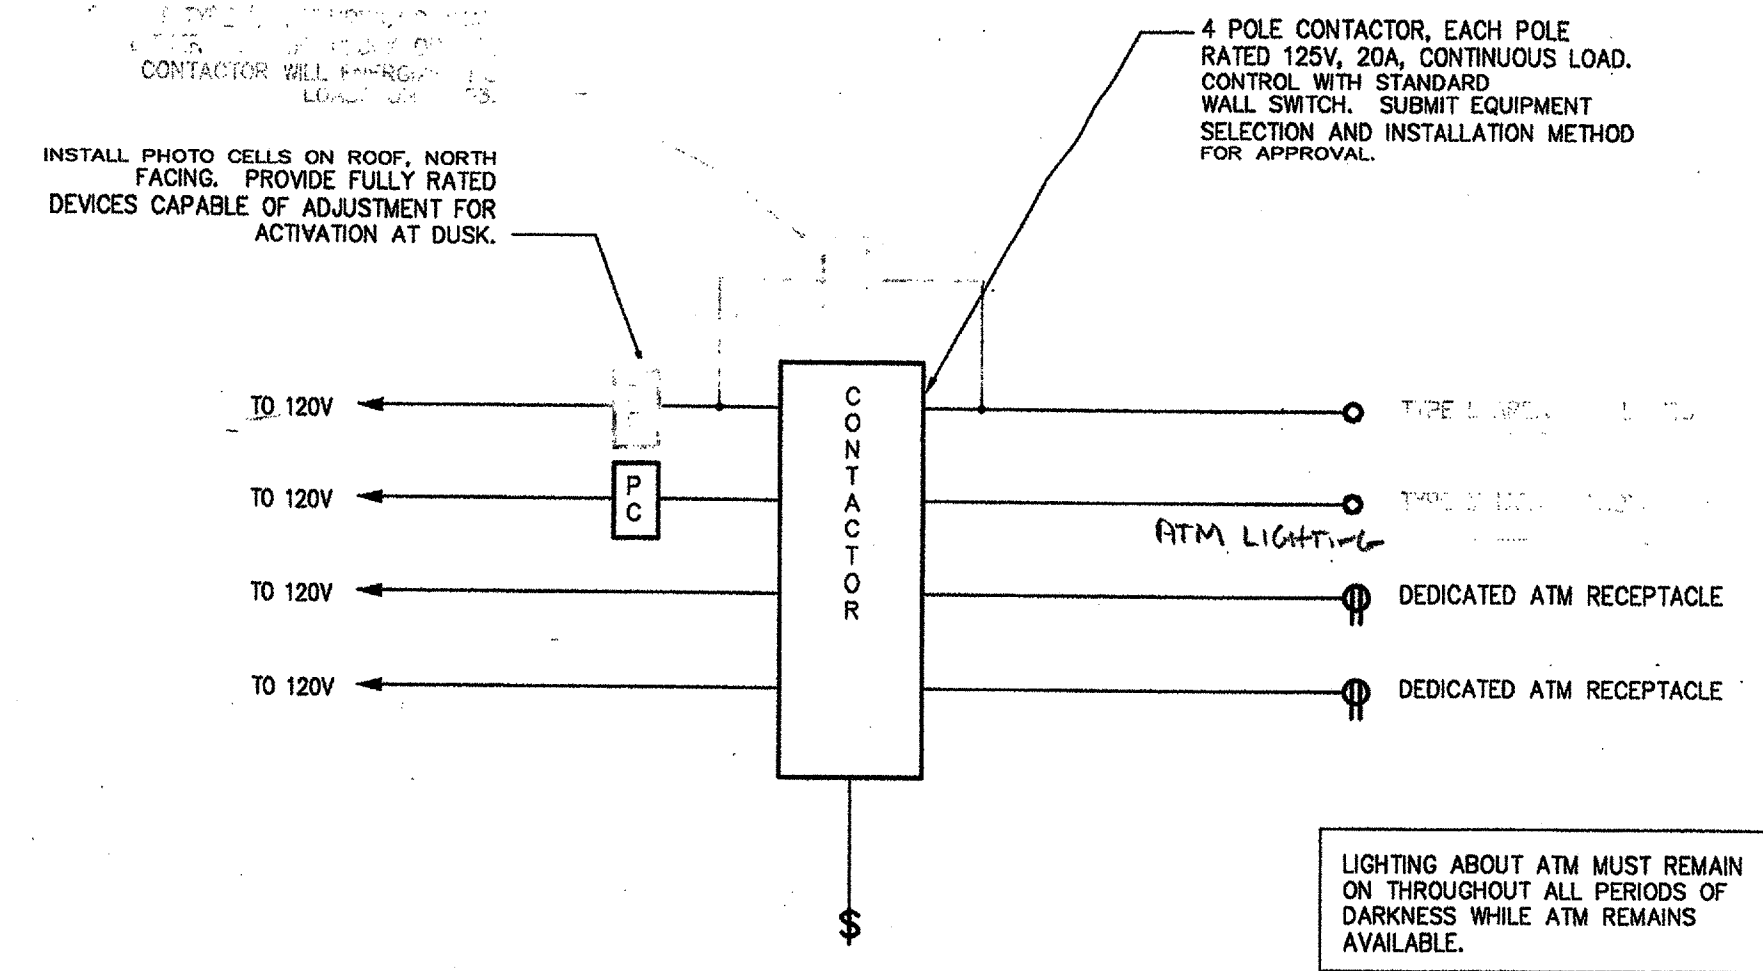

1 POWER ELECTRICAL PLAN 1/8"=1'-0"

**cunningham architects**  
 918 Oregon Street  
 Dallas, Texas 75207  
 V 214.915.0500  
 F 214.915.0501


ADDISON ARTS AND EVENTS PAVILION  
 Addison, Texas

date  
 08/26/02  
 10/31/02  
 01/23/03

issue  
 01  
 50% CD  
 95% CD

N  
**E2.0**  
 ELECTRICAL