


- MEP SUB-CONTRACTORS ARE RESPONSIBLE FOR COORDINATION WITH ARCHITECTURAL PLANS FOR ALL WORK. REFERENCE GENERAL ELECTRICAL NOTE G7/E3.0.
- REFERENCE ELECTRICAL NOTES AND DETAILS AND OTHER ELECTRICAL PLANS FOR ADDITIONAL POWER REQUIREMENTS.
- REFERENCE KITCHEN PLANS FOR EQUIPMENT INFORMATION. REFERENCE ARCHITECTURAL DRAWINGS AND SPECIFICATIONS FOR EQUIPMENT LOCATIONS.
- COORDINATE DEVICE LOCATIONS IN FIELD WITH ARCHITECT.
- REFERENCE PANEL BOARD SCHEDULES FOR ADDITIONAL LOAD AND CIRCUIT INFORMATION.
- REFERENCE MECHANICAL PLANS AND SPECIFICATIONS FOR MECHANICAL AND PLUMBING EQUIPMENT REQUIREMENTS.
- REFERENCE MECHANICAL AND ARCHITECTURAL PLANS FOR MECHANICAL AND PLUMBING EQUIPMENT LOCATIONS.

KITCHEN EQUIPMENT SCHEDULE																	
PLAN MARK	EQUIPMENT DESCRIPTION/CATALOG NO.	LOCATION	MECHANICAL DATA				ELECTRICAL DATA				COND. DIAM. (INCHES)	NOTES/COMMENTS					
			VOLTS	PHASE	MOTOR HP	RLA FLA	HEAT KW	AMPS	NCA	DEVICE TYPE			HEIGHT	MAX OCCP (SERVED)	PANEL FUSE	FROM CIRCUIT	WIRES
1	WARMER	KITCHEN	120	1		16.0	2	16.0	20	5-20R	18"	20	A	1	2 #10, 1 #10G	10.75	
1	WARMER	KITCHEN	120	1		16.0	2	16.0	20	5-20R	18"	20	A	3	2 #10, 1 #10G	10.75	
1	WARMER	KITCHEN	120	1		16.0	2	16.0	20	5-20R	18"	20	A	5	2 #10, 1 #10G	10.75	
1	WARMER	KITCHEN	120	1		16.0	2	16.0	20	5-20R	18"	20	A	7	2 #10, 1 #10G	10.75	
	KITCHEN DUPLEX	KITCHEN	120	1		10.0	1	10.0	13	5-20R	18"	20	A	9	2 #10, 1 #10G	10.75	
	KITCHEN DUPLEX	KITCHEN	120	1		10.0	1	10.0	13	5-20R	18"	20	A	11	2 #10, 1 #10G	10.75	
2	STEAMER	KITCHEN	208	1		14.4	3	14.4	18	FVR	18"	20	A	13/15	2 #10, 1 #10G	10.75	FVR
	KITCHEN DUPLEX	KITCHEN	120	1		10.0	1	10.0	13	5-20R	18"	20	A	17	2 #10, 1 #10G	10.75	
3	KITCHEN DUPLEX	KITCHEN	120	1		10.0	1	10.0	13	5-20R	34"	20	A	19	2 #10, 1 #10G	10.75	BTC
3	KITCHEN DUPLEX	KITCHEN	120	1		10.0	1	10.0	13	5-20R	34"	20	A	21	2 #10, 1 #10G	10.75	BTC
12	ROLL WARMER	KITCHEN	120	1		7.5	1	7.5	9	5-20R	18"	20	A	23	2 #10, 1 #10G	10.75	
13	CASH DRAWER	KITCHEN	120	1		5.0	1	5.0	6	5-20R	24"	20	A	25	2 #10, 1 #10G	10.75	BTC
	KITCHEN DUPLEX	KITCHEN	120	1		10.0	1	10.0	13	5-20R	34"	20	A	27	2 #10, 1 #10G	10.75	BTC
3	KITCHEN DUPLEX	KITCHEN	120	1		10.0	1	10.0	13	5-20R	34"	20	A	29	2 #10, 1 #10G	10.75	BTC
13	CASH DRAWER	KITCHEN	120	1		5.0	1	5.0	6	5-20R	24"	20	A	31	2 #10, 1 #10G	10.75	BTC
12	ROLL WARMER	KITCHEN	120	1		7.5	1	7.5	9	5-20R	18"	20	A	33	2 #10, 1 #10G	10.75	ALT. LOC.
	KITCHEN DUPLEX	KITCHEN	120	1		10.0	1	10.0	13	5-20R	34"	20	A	35	2 #10, 1 #10G	10.75	BTC
	KITCHEN DUPLEX	KITCHEN	120	1		10.0	1	10.0	13	5-20R	18"	20	A	37	2 #10, 1 #10G	10.75	BTC
	KITCHEN DUPLEX	KITCHEN	120	1		10.0	1	10.0	13	5-20R	18"	20	A	39	2 #10, 1 #10G	10.75	
	KITCHEN DUPLEX	KITCHEN	120	1		10.0	1	10.0	13	5-20R	18"	20	A	41	2 #10, 1 #10G	10.75	
8	WALKIN REFER	KITCHEN	120	1		10.6	1	10.6	13	5-20R	87"	20	A	2	2 #10, 1 #10G	10.75	
7	ROLL IN REFER	KITCHEN	120	1		8.0	1	8.0	10	5-20R	87"	20	A	4	2 #10, 1 #10G	10.75	
17	COFFEE	KITCHEN	208	1		29.0	6	29.0	36	1L6-4GR	24"	40	A	6/8	4 #8, 1 #10G	10.75	FVR
4	ICE MAKER	KITCHEN	208	1		11.0	2	11.0	14	J-BOX	60"	20	A	10/12	4 #10, 1 #10G	10.75	BTC
	KITCHEN DUPLEX	KITCHEN	120	1		10.0	1	10.0	13	5-20R	18"	20	A	14	2 #10, 1 #10G	10.75	

JOB NAME: PAVILION - LOCATED: ADDISON - JOB NUMBER: 02998 - MECHANICAL ENGINEER: MRP - ELECTRICAL: VMS - FILE NAME: 02998KES.WD1 22-Jan-2003

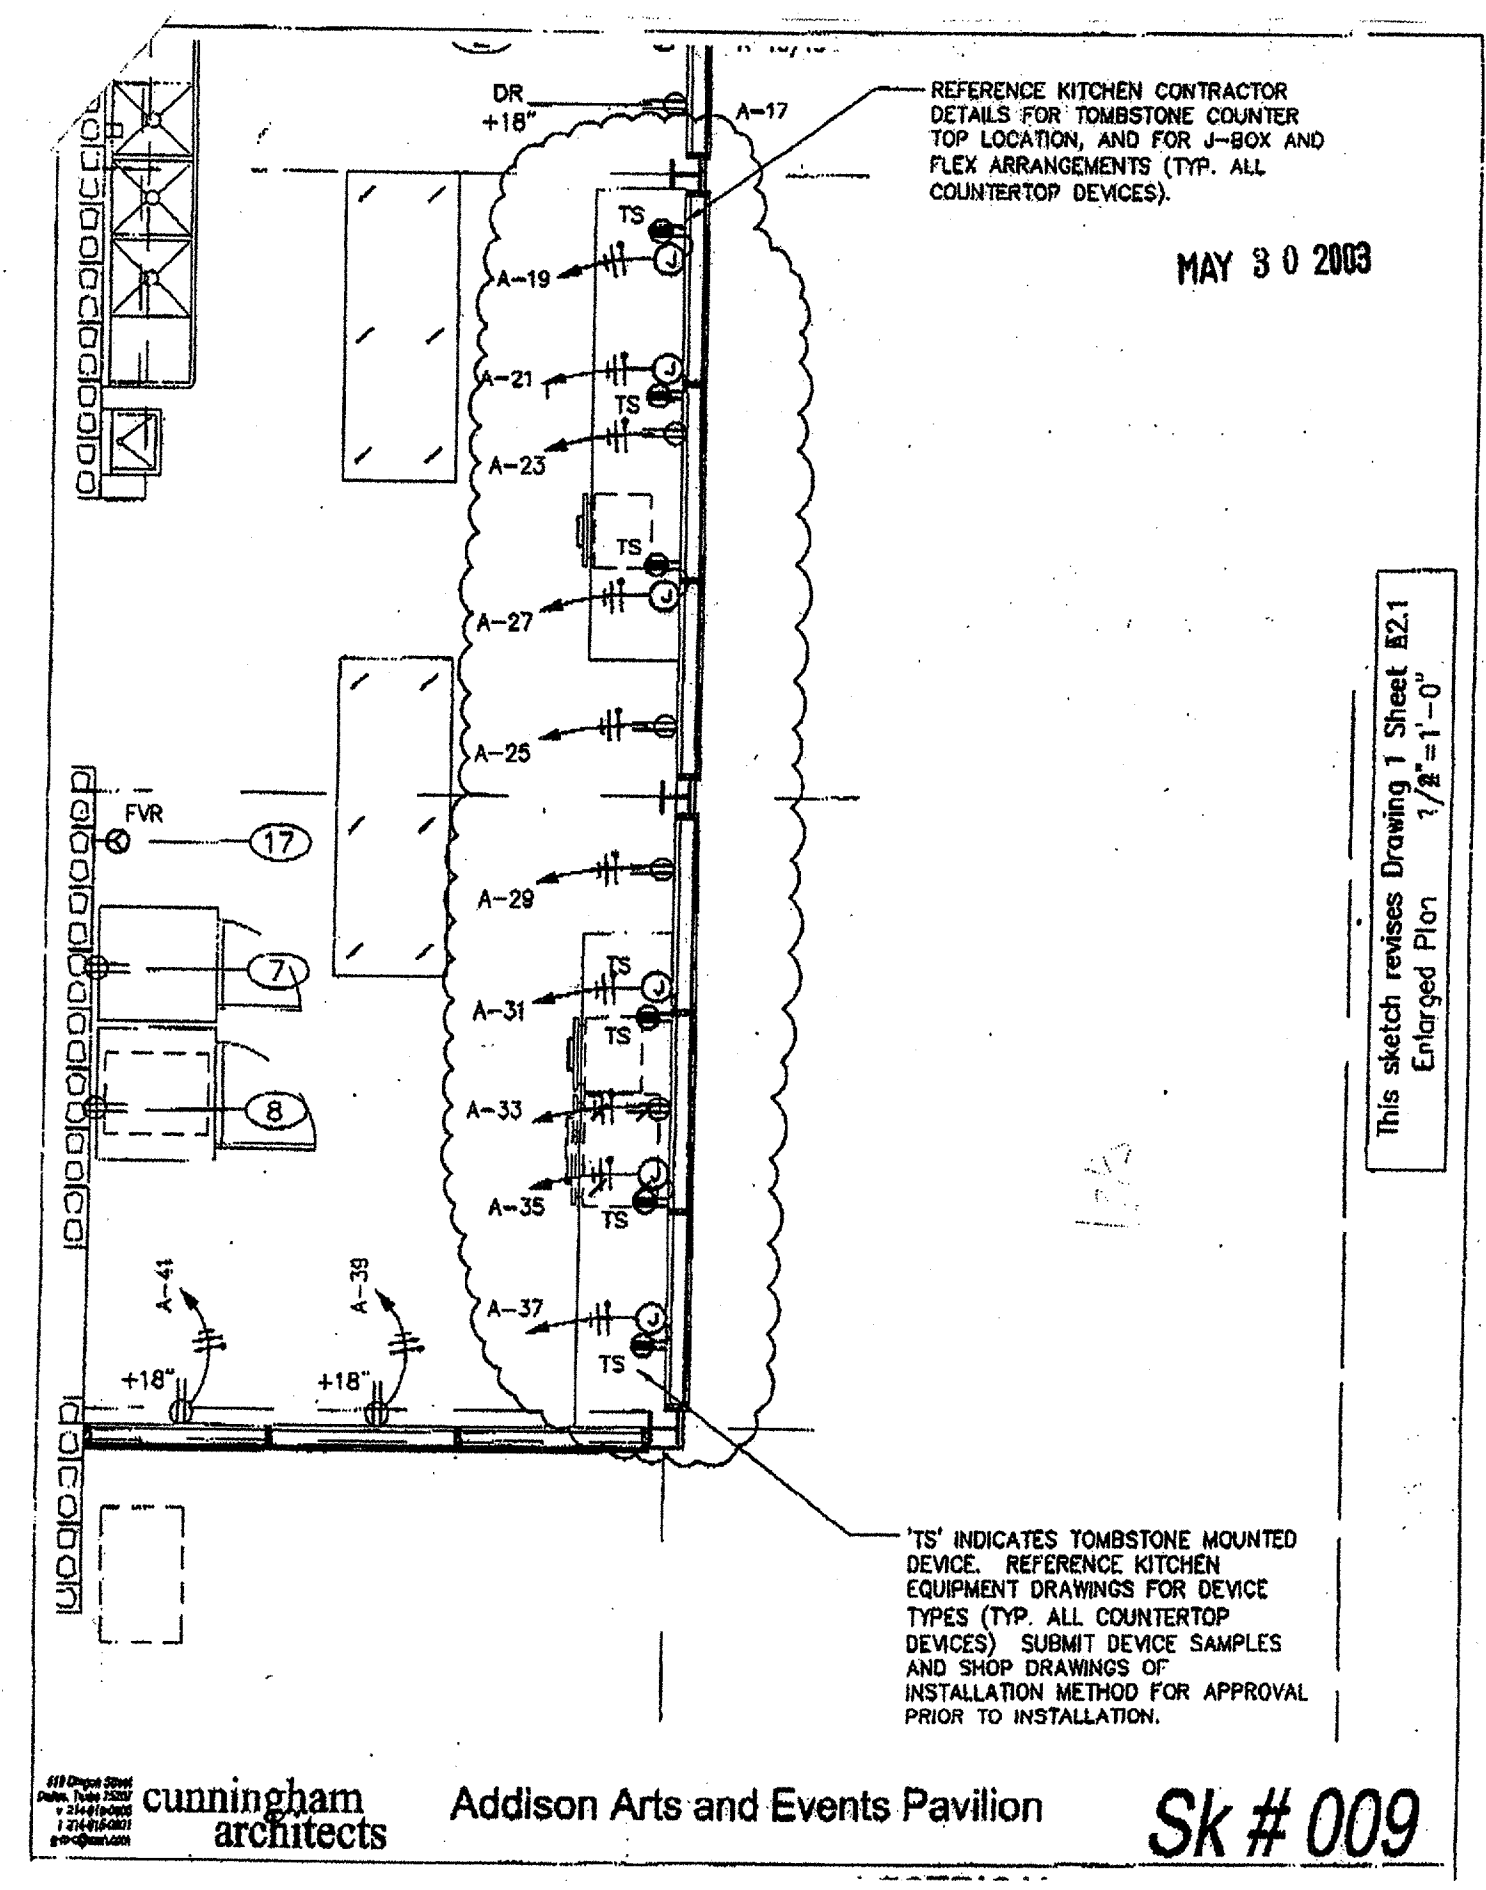

cunningham architects
918 Dragon Street
Dallas, Texas 75207
Tel: 214.915.0800
Fax: 214.915.0801

MEP CONSULTING SERVICES
918 Dragon Street Dallas, Texas 75207
Tel: 214.915.0800
Fax: 214.915.0801

MIRDIN
MEP SYSTEMS DESIGN AND ENGINEERING, INC.



Addison Arts and Events Pavilion
Addison, Texas

date
08/26/02
10/31/02
01/23/03

issue
DD 50% CD
95% CD

E2.1
KITCHEN ELECTRICAL

Sk # 009

cunningham architects
Addison Arts and Events Pavilion