


PLAN MARK	EQUIPMENT DESCRIPTION/CATALOG NO.	LOCATION	MECHANICAL DATA						ELECTRICAL DATA					COND. DIAM. INCHES	NOTES COMMENTS		
			VOLTS	PHASE	MOTR HP	FLA	HEAT KW	MCA	DEVI	HEIGHT	MAX DCPD BRKR	PANEL SERVED FROM	CIRCUIT			WIRES	
1	WARMER	KITCHEN	120	1		16.0	2	16.0	20	5-20R	18"	20	A	1	2 #10, 1 #10G	0.75	
1	WARMER	KITCHEN	120	1		16.0	2	16.0	20	5-20R	18"	20	A	3	2 #10, 1 #10G	0.75	
1	WARMER	KITCHEN	120	1		16.0	2	16.0	20	5-20R	18"	20	A	5	2 #10, 1 #10G	0.75	
1	WARMER	KITCHEN	120	1		16.0	2	16.0	20	5-20R	18"	20	A	7	2 #10, 1 #10G	0.75	
	KITCHEN DUPLEX	KITCHEN	120	1		10.0	1	10.0	13	5-20R	18"	20	A	9	2 #10, 1 #10G	0.75	
	KITCHEN DUPLEX	KITCHEN	120	1		10.0	1	10.0	13	5-20R	18"	20	A	11	2 #10, 1 #10G	0.75	
2	STEAMER	KITCHEN	208	1		14.4	3	14.4	18	FVR	18"	20	A	13/15	2 #10, 1 #10G	0.75	FVR
	KITCHEN DUPLEX	KITCHEN	120	1		10.0	1	10.0	13	5-20R	18"	20	A	17	2 #10, 1 #10G	0.75	
3	KITCHEN DUPLEX	KITCHEN	120	1		10.0	1	10.0	13	5-20R	34"	20	A	19	2 #10, 1 #10G	0.75	BTC
3	KITCHEN DUPLEX	KITCHEN	120	1		10.0	1	10.0	13	5-20R	34"	20	A	21	2 #10, 1 #10G	0.75	BTC
12	ROLL WARMER	KITCHEN	120	1		7.5	1	7.5	9	5-20R	18"	20	A	23	2 #10, 1 #10G	0.75	
13	CASH DRAWER	KITCHEN	120	1		5.0	1	5.0	6	5-20R	24"	20	A	25	2 #10, 1 #10G	0.75	BTC
	KITCHEN DUPLEX	KITCHEN	120	1		10.0	1	10.0	13	5-20R	34"	20	A	27	2 #10, 1 #10G	0.75	BTC
3	KITCHEN DUPLEX	KITCHEN	120	1		10.0	1	10.0	13	5-20R	34"	20	A	29	2 #10, 1 #10G	0.75	BTC
13	CASH DRAWER	KITCHEN	120	1		5.0	1	5.0	6	5-20R	24"	20	A	31	2 #10, 1 #10G	0.75	BTC
12	ROLL WARMER	KITCHEN	120	1		7.5	1	7.5	9	5-20R	18"	20	A	33	2 #10, 1 #10G	0.75	ALT. LOC.
3	KITCHEN DUPLEX	KITCHEN	120	1		10.0	1	10.0	13	5-20R	34"	20	A	35	2 #10, 1 #10G	0.75	BTC
3	KITCHEN DUPLEX	KITCHEN	120	1		10.0	1	10.0	13	5-20R	34"	20	A	37	2 #10, 1 #10G	0.75	BTC
	KITCHEN DUPLEX	KITCHEN	120	1		10.0	1	10.0	13	5-20R	18"	20	A	39	2 #10, 1 #10G	0.75	
	KITCHEN DUPLEX	KITCHEN	120	1		10.0	1	10.0	13	5-20R	18"	20	A	41	2 #10, 1 #10G	0.75	
8	WALKIN REFER	KITCHEN	120	1		10.6	1	10.6	13	5-20R	87"	20	A	2	2 #10, 1 #10G	0.75	
7	ROLL IN REFER	KITCHEN	120	1		8.0	1	8.0	10	5-20R	87"	20	A	4	2 #10, 1 #10G	0.75	
17	COFFEE	KITCHEN	208	1		29.0	6	29.0	36	1L6-4GR	24"	40	A	6/8	4 #8, 1 #10G	0.75	FVR
4	ICE MAKER	KITCHEN	208	1		11.0	2	11.0	14	J-BOX	60"	20	A	10/12	4 #10, 1 #10G	0.75	BTC
	KITCHEN DUPLEX	KITCHEN	120	1		10.0	1	10.0	13	5-20R	18"	20	A	14	2 #10, 1 #10G	0.75	

JOB NAME: PAVILION - LOCATION: ADDISON - JOB NUMBER: 02098 - MECHANICAL ENGINEER: MBP - ELECTRICAL: WWS - FILE NAME: 02098KES.WD1 22-Jan-2003


- MEP SUB-CONTRACTORS ARE RESPONSIBLE FOR COORDINATION WITH ARCHITECTURAL PLANS FOR ALL WORK. REFERENCE GENERAL ELECTRICAL NOTE G7/E3.0.
- REFERENCE ELECTRICAL NOTES AND DETAILS AND OTHER ELECTRICAL PLANS FOR ADDITIONAL POWER REQUIREMENTS.
- REFERENCE KITCHEN PLANS FOR EQUIPMENT INFORMATION. REFERENCE ARCHITECTURAL DRAWINGS AND SPECIFICATIONS FOR EQUIPMENT LOCATIONS.
- COORDINATE DEVICE LOCATIONS IN FIELD WITH ARCHITECT.
- REFERENCE PANEL BOARD SCHEDULES FOR ADDITIONAL LOAD AND CIRCUIT INFORMATION.
- REFERENCE MECHANICAL PLANS AND SPECIFICATIONS FOR MECHANICAL AND PLUMBING EQUIPMENT REQUIREMENTS.
- REFERENCE MECHANICAL AND ARCHITECTURAL PLANS FOR MECHANICAL AND PLUMBING EQUIPMENT LOCATIONS.

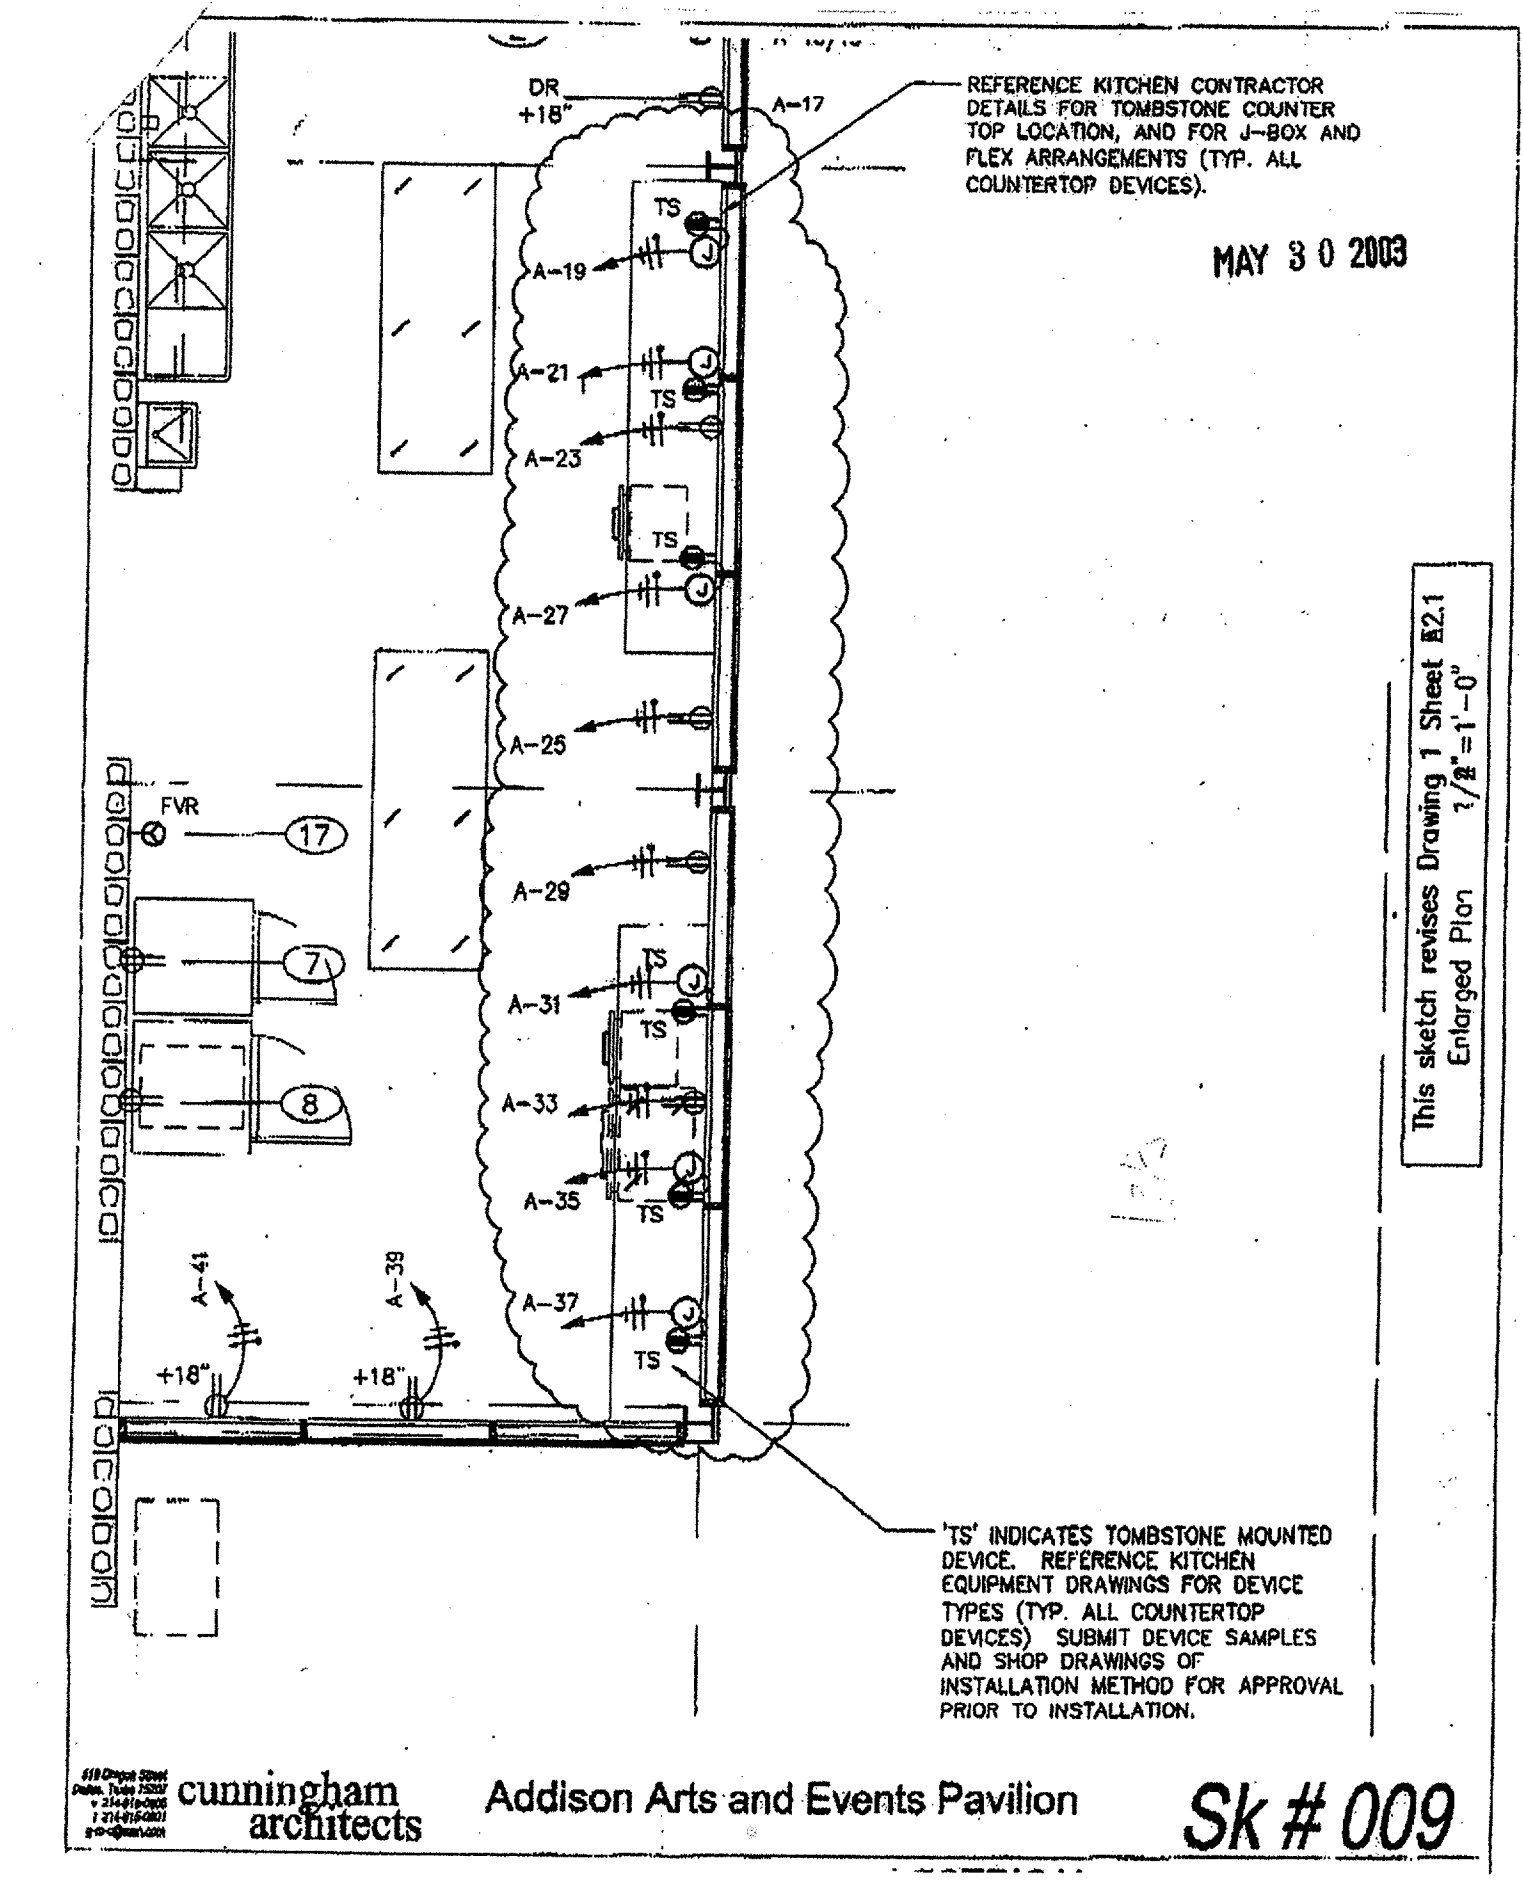

cunningham architects
918 Dragon Street, Dallas, Texas 75207
972.443.0000
972.443.0001

MEP SYSTEMS DESIGN AND ENGINEERING, INC.
918 Dragon Street, Dallas, Texas 75207
972.443.0000
972.443.0001

MYRDIN
MEP SYSTEMS DESIGN AND ENGINEERING, INC.

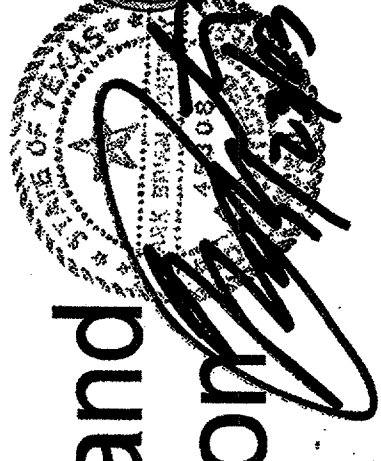

Addison Arts and Events Pavilion
Addison, Texas

date
06/26/02
10/31/02
01/23/03

issue
DD 50% CD
95% CD

E2.1
KITCHEN ELECTRICAL