


2 SPRINKLER PLAN
 PLAN 1/8"=1'-0"

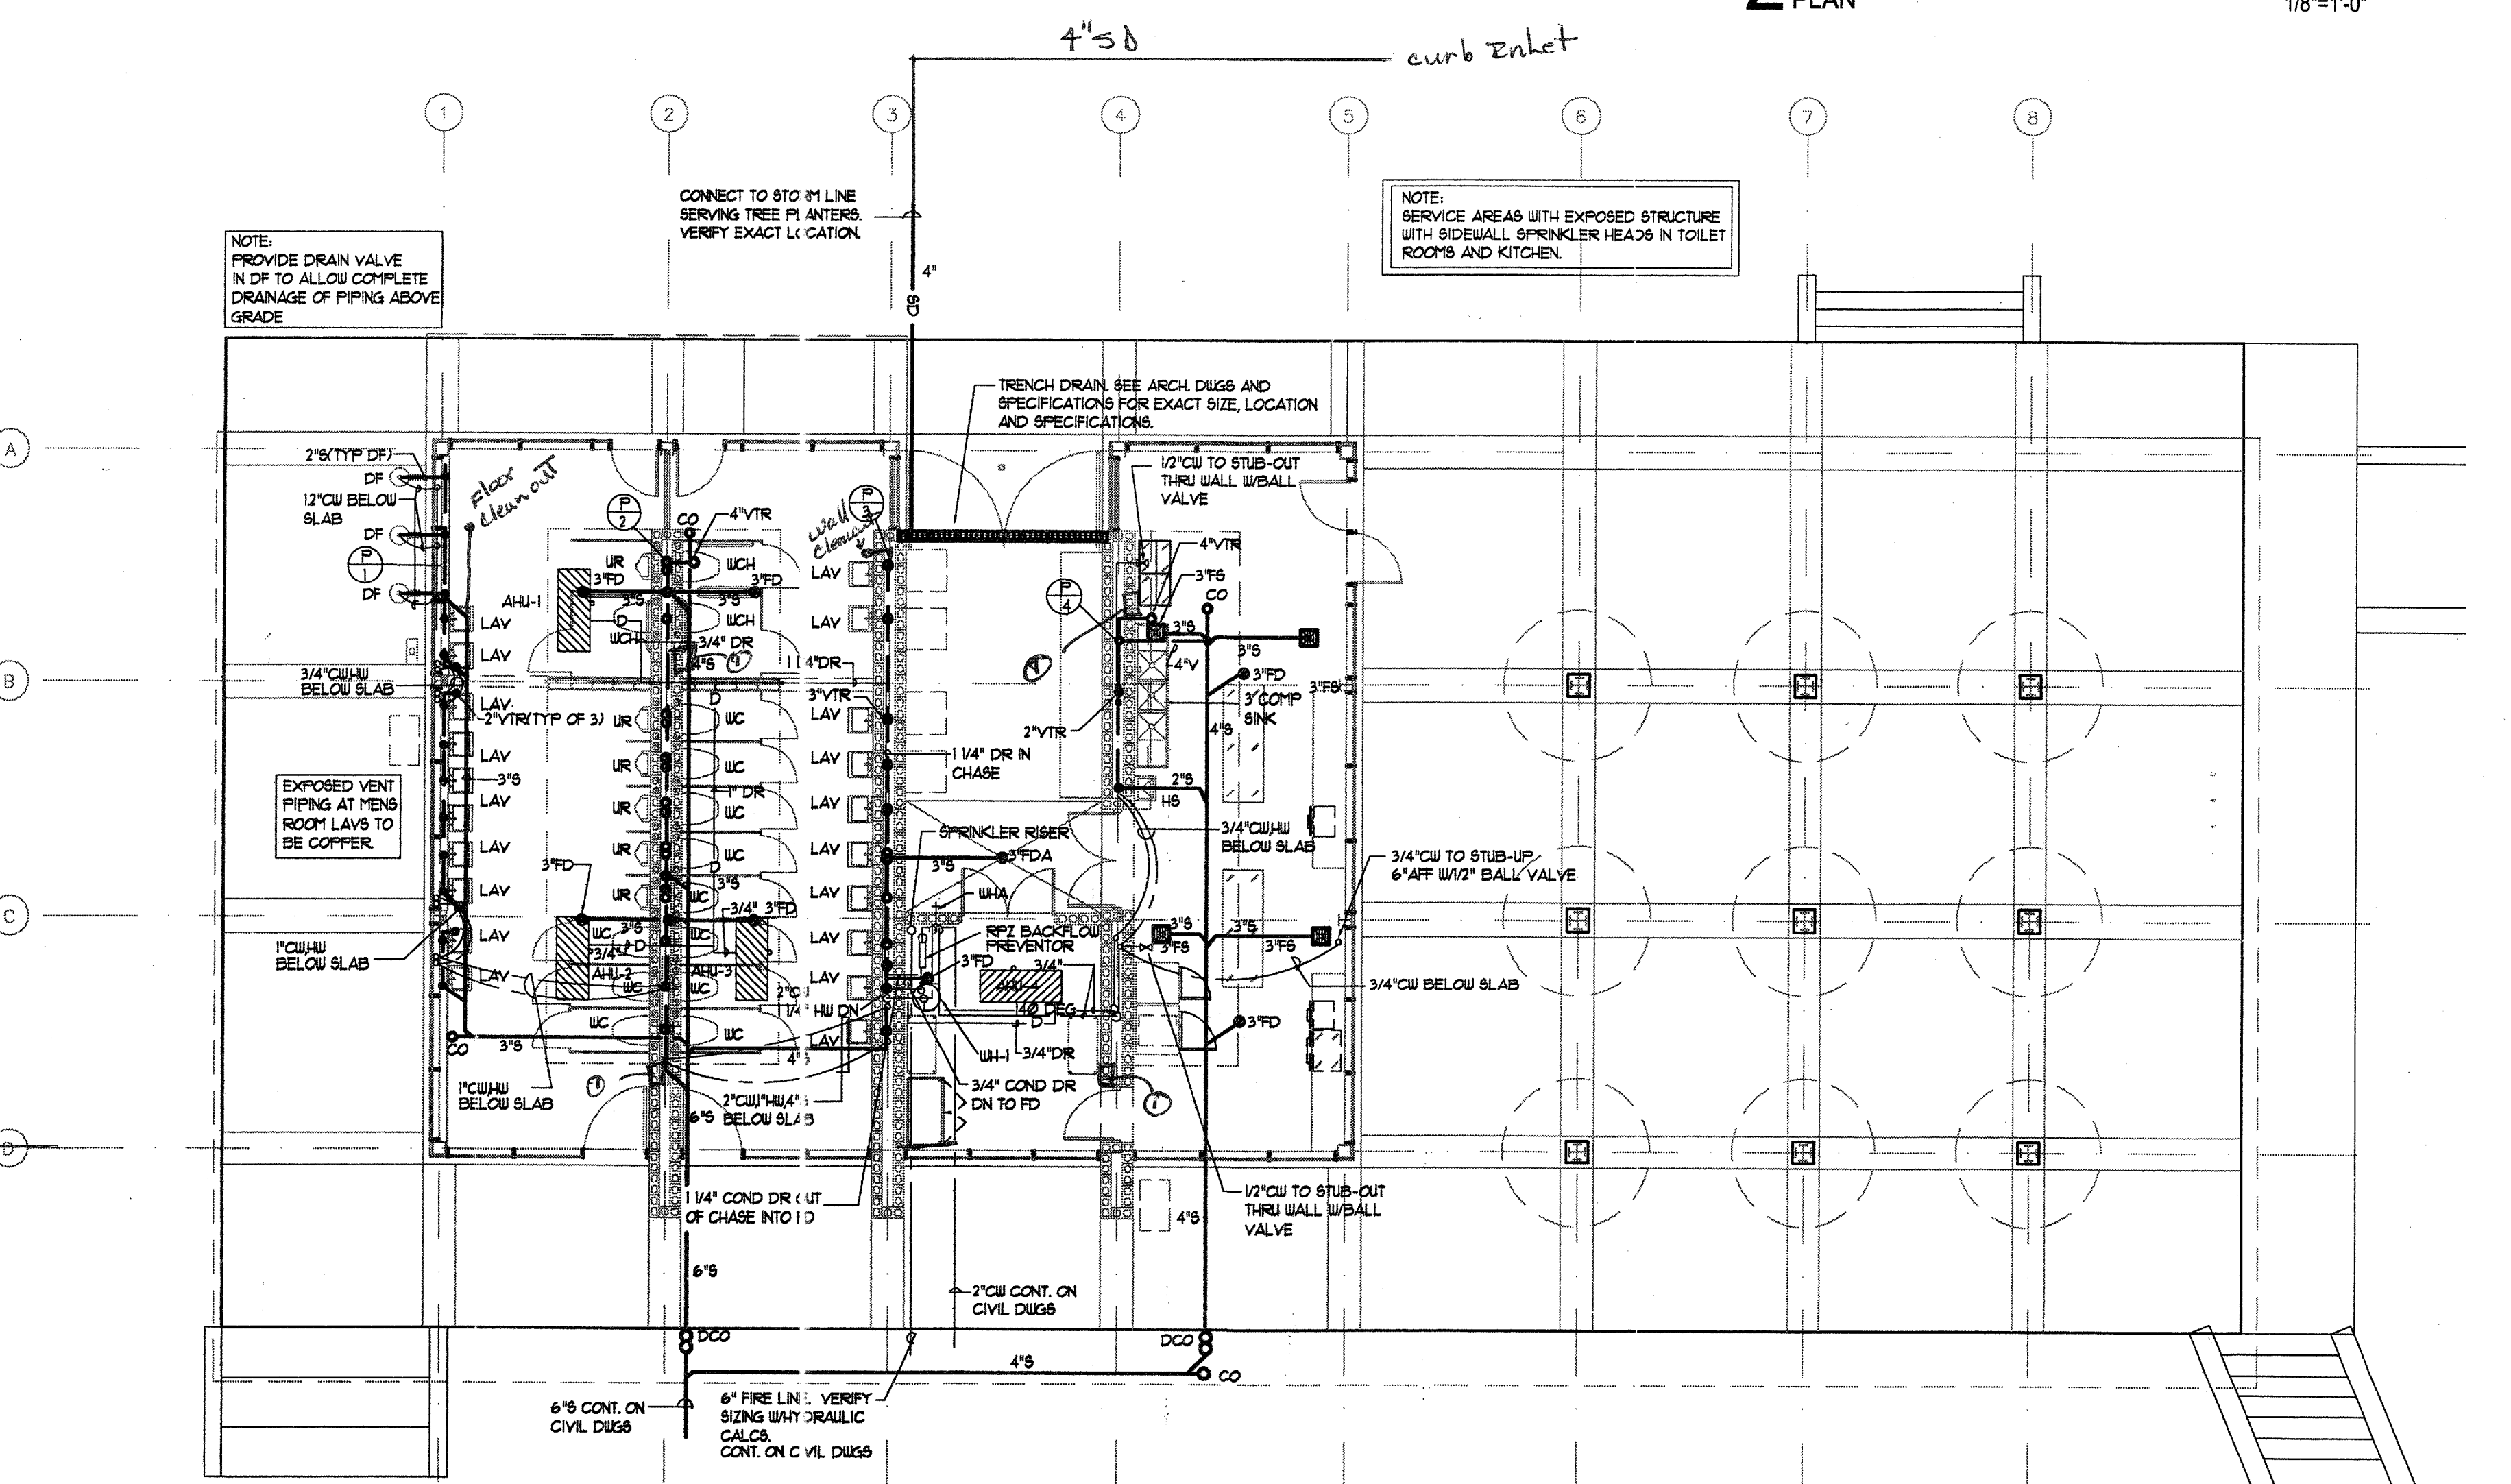

1 PLUMBING PLAN
 PLAN 1/8"=1'-0"

CONTRACTOR TO COORDINATE WITH ALL OTHER TRADES AND ALL ARCHITECTURAL PLANS BEFORE INSTALLATION IS BEGUN. NO ADDED COST WILL BE ALLOWED FOR LACK OF COORDINATION WITH ALL PLANS AND OTHER TRADES.

NOTE: PROVIDE DRAIN VALVE IN DF TO ALLOW COMPLETE DRAINAGE OF PIPING ABOVE GRADE

NOTE: SERVICE AREAS WITH EXPOSED STRUCTURE WITH SIDEWALL SPRINKLER HEADS IN TOILET ROOMS AND KITCHEN

Note: ① Access Doors For Trap Primer Valves

ISSUE	DD	50% CD	95% CD
DATE	08/26/02	10/31/02	01/23/03

P1.0
 FLOOR PLAN