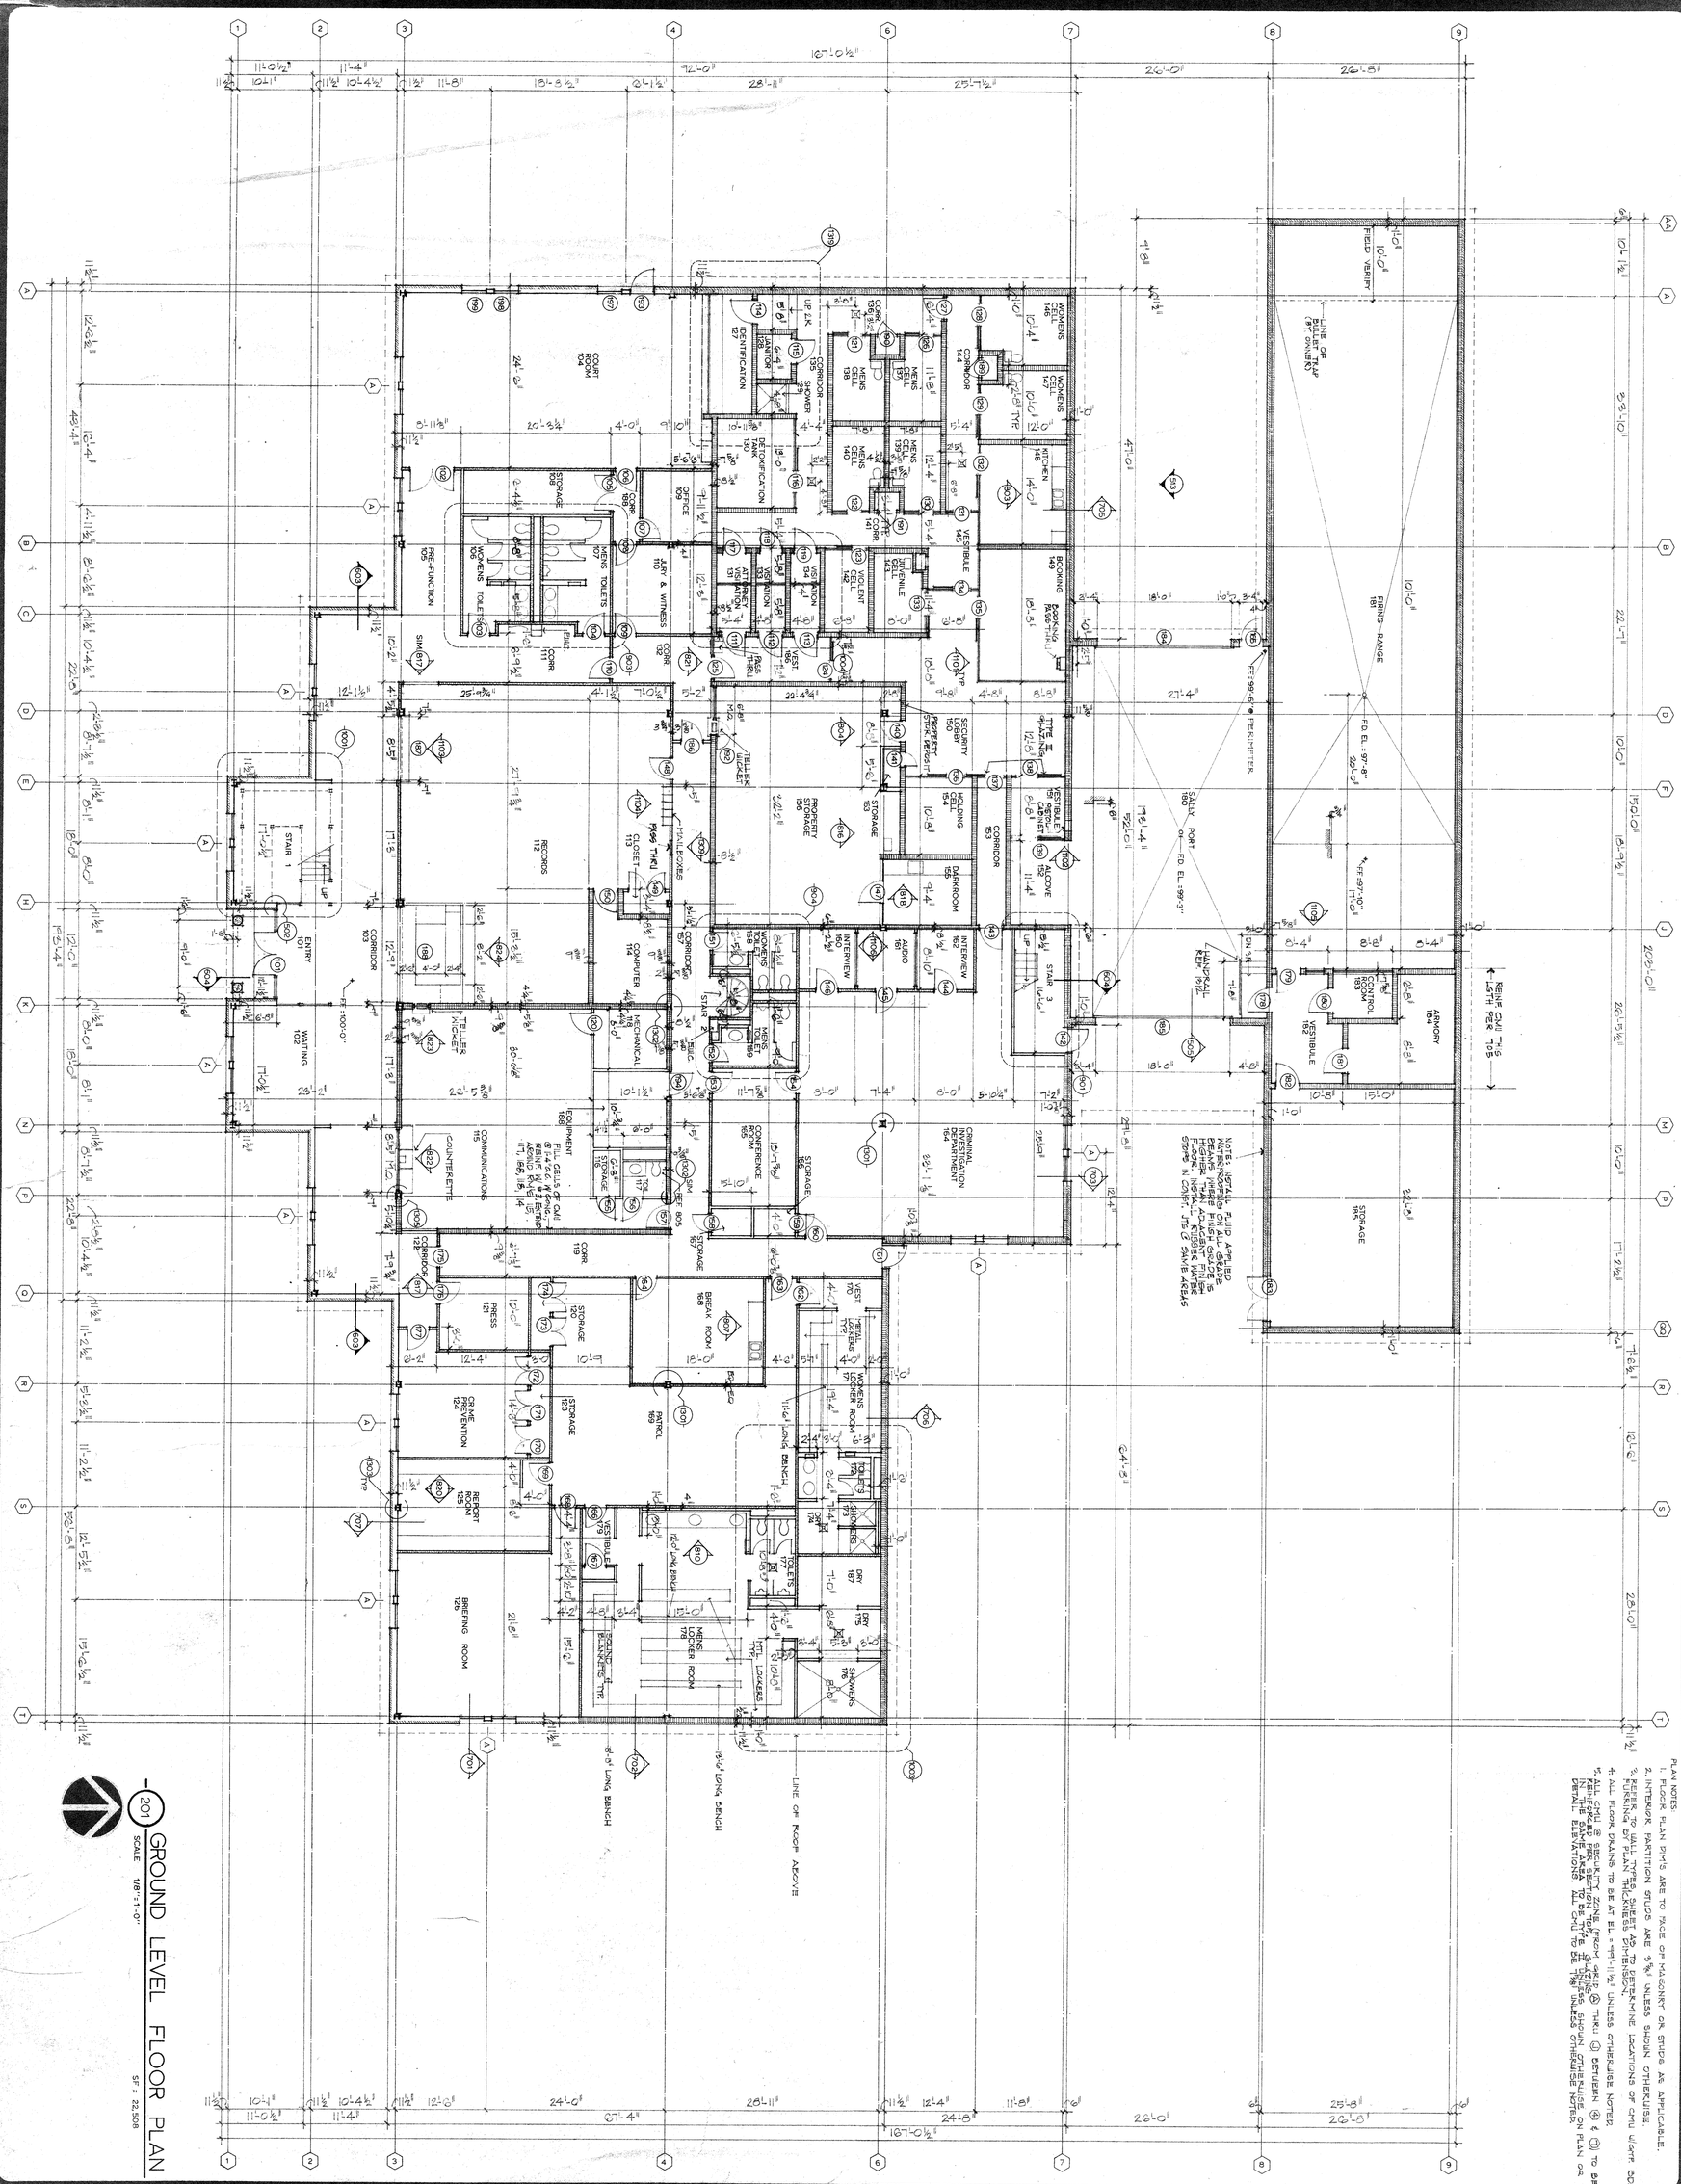

PLAN NOTES:
1. FLOOR PLAN DIMS ARE TO FACE OF MASONRY OR STUDS AS APPLICABLE.
2. INTERIOR PARTITION STUDS ARE 3 5/8" UNLESS SHOWN OTHERWISE.
3. REFER TO WALL TYPES SHEET A9 TO DETERMINE LOCATIONS OF CMU WALLS REQ. FURRING BY PLAN THICKNESS DIMENSION.
4. ALL FLOOR DRAINS TO BE AT EL. -1'-1 1/2" UNLESS OTHERWISE NOTED.
5. REINFORCED CMU WALLS PER SECTION 1/A10 @ THRU @ BETWEEN @ & @ TO BE FURRED AS REQ'D FOR THICKNESS SHOWN ON PLAN OR DETAIL. ELEVATIONS TO BE TYPE 'E' UNLESS SHOWN OTHERWISE ON PLAN OR DETAIL. ALL CMU TO BE TYPE 'E' UNLESS OTHERWISE NOTED.

201 GROUND LEVEL FLOOR PLAN

SCALE 1/8"=1'-0"

SF = 22,508

SHEET A2

DATE JULY 12 1982

JOB NO. 318

REVISIONS

A NEW POLICE FACILITY FOR THE

TOWN OF ADDISON

4799 AIRPORT PARKWAY
ADDISON, TEXAS
75248

SHEPHERD + BOYD
ARCHITECTS/PLANNERS & INTERIORS
8235 DOUGLAS AVENUE
DOUGLAS BUILDING SUITE 900
DALLAS TEXAS 75225
TELEPHONE 214/691-9000