





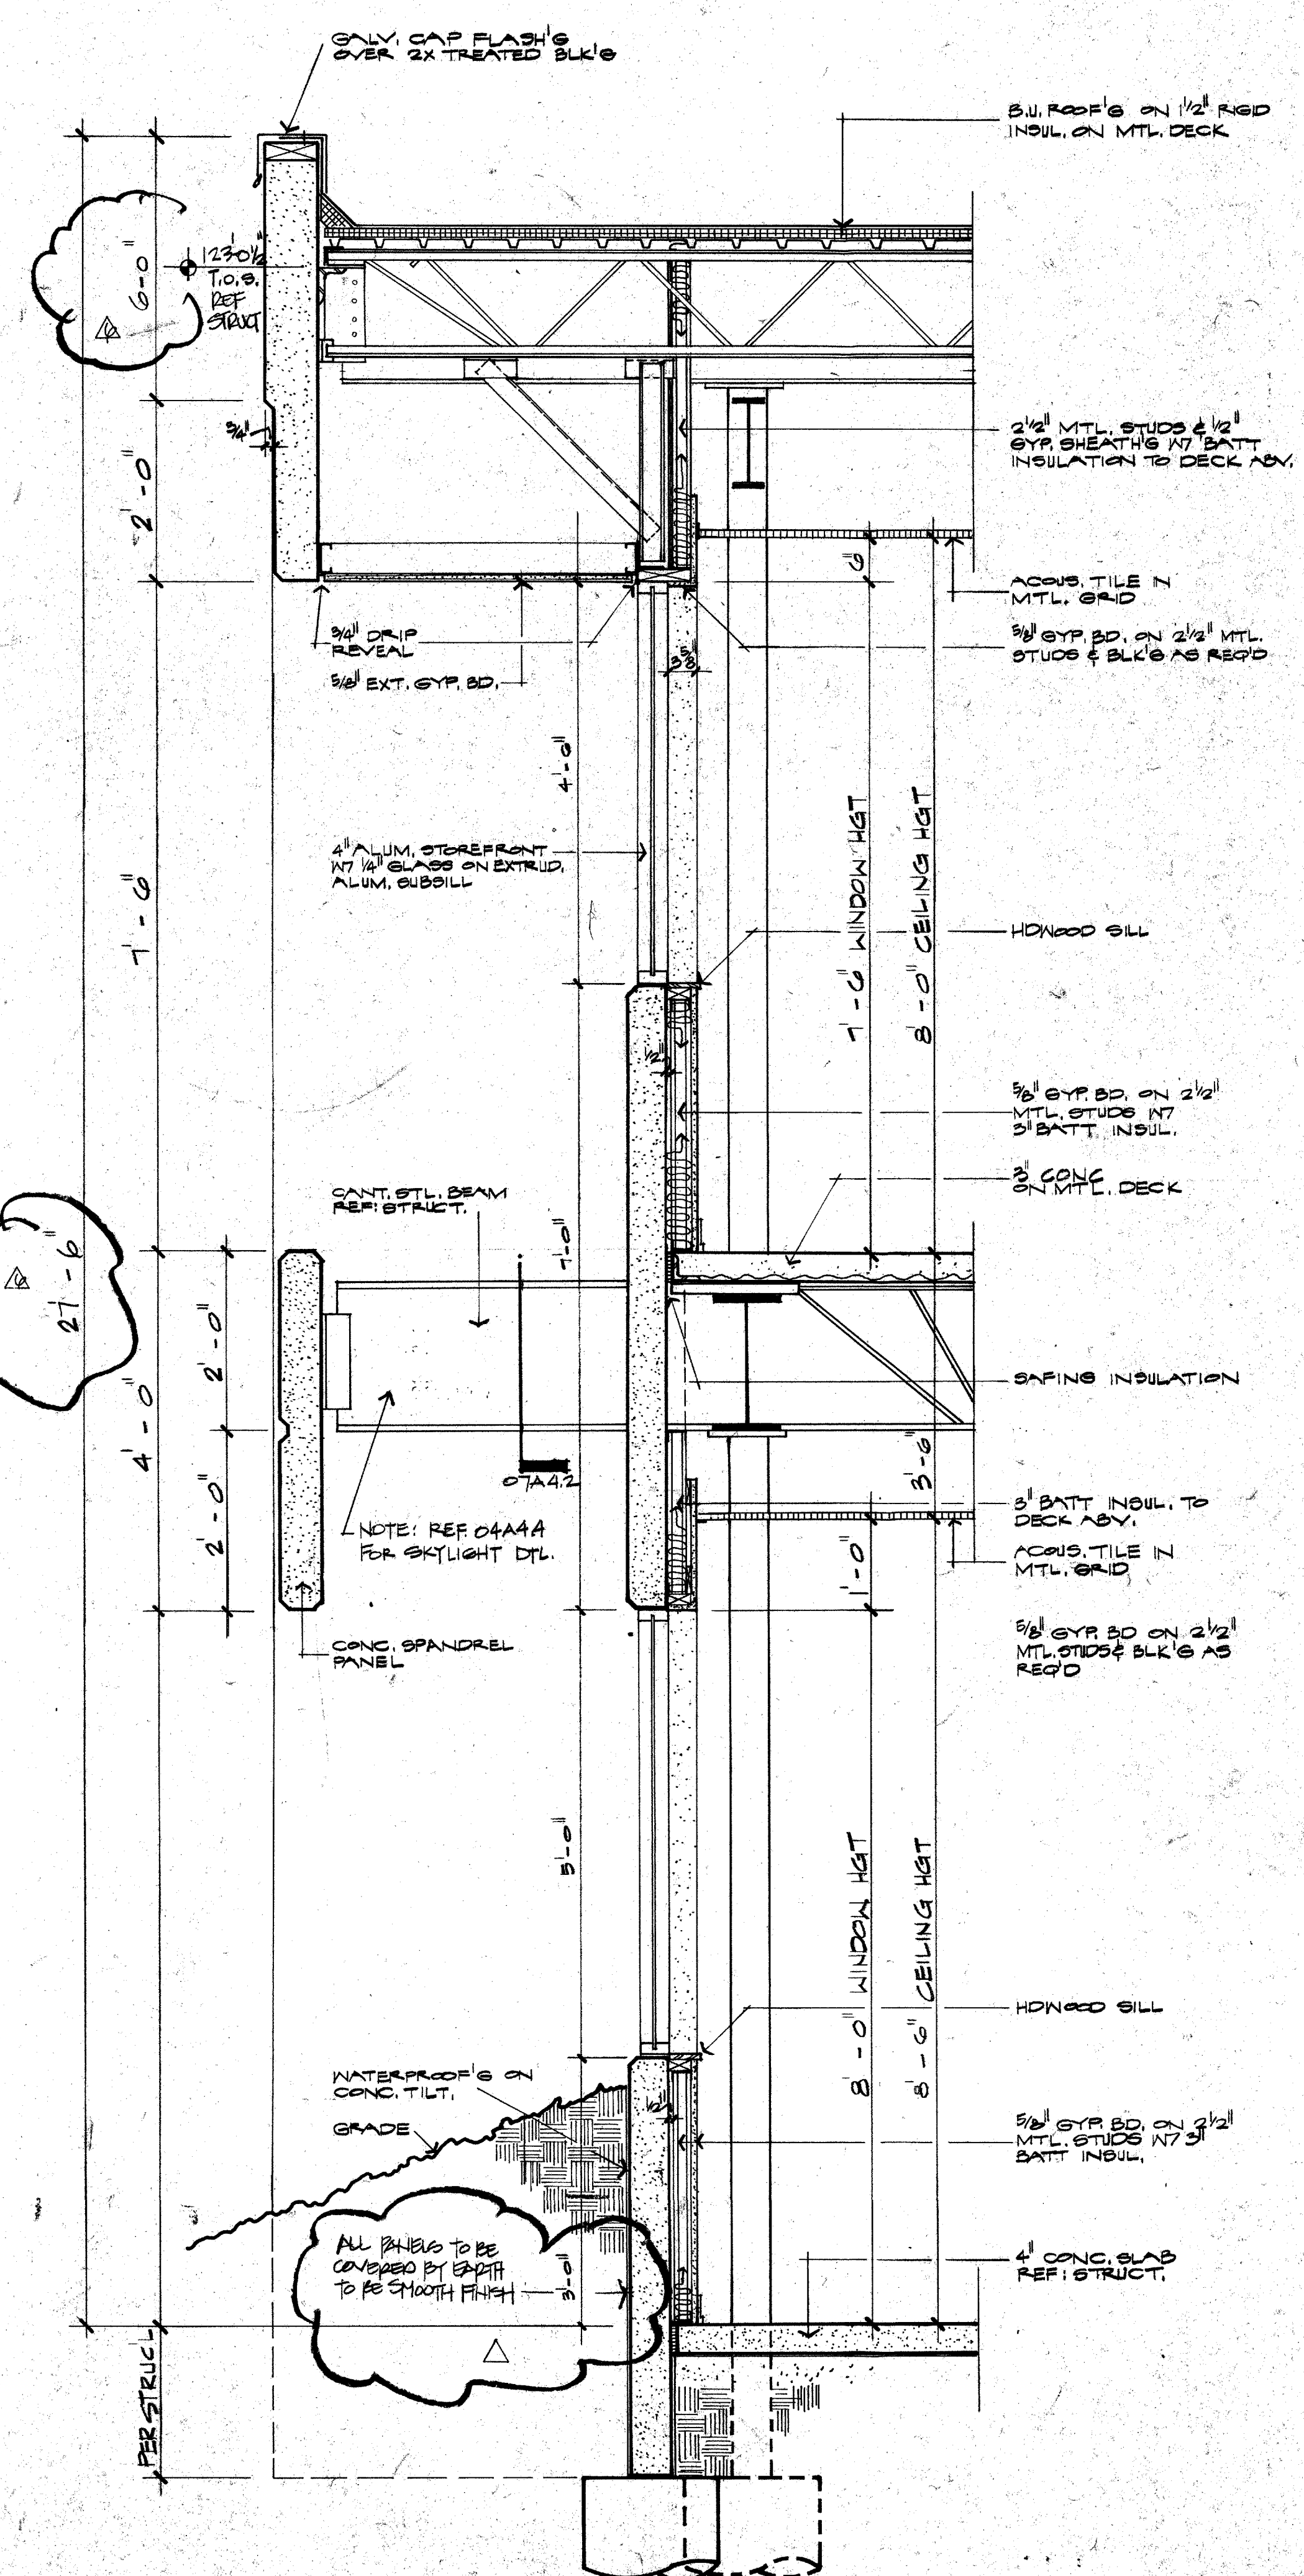


03 WALL SECTION  
A4.1 3/4" = 1'-0"

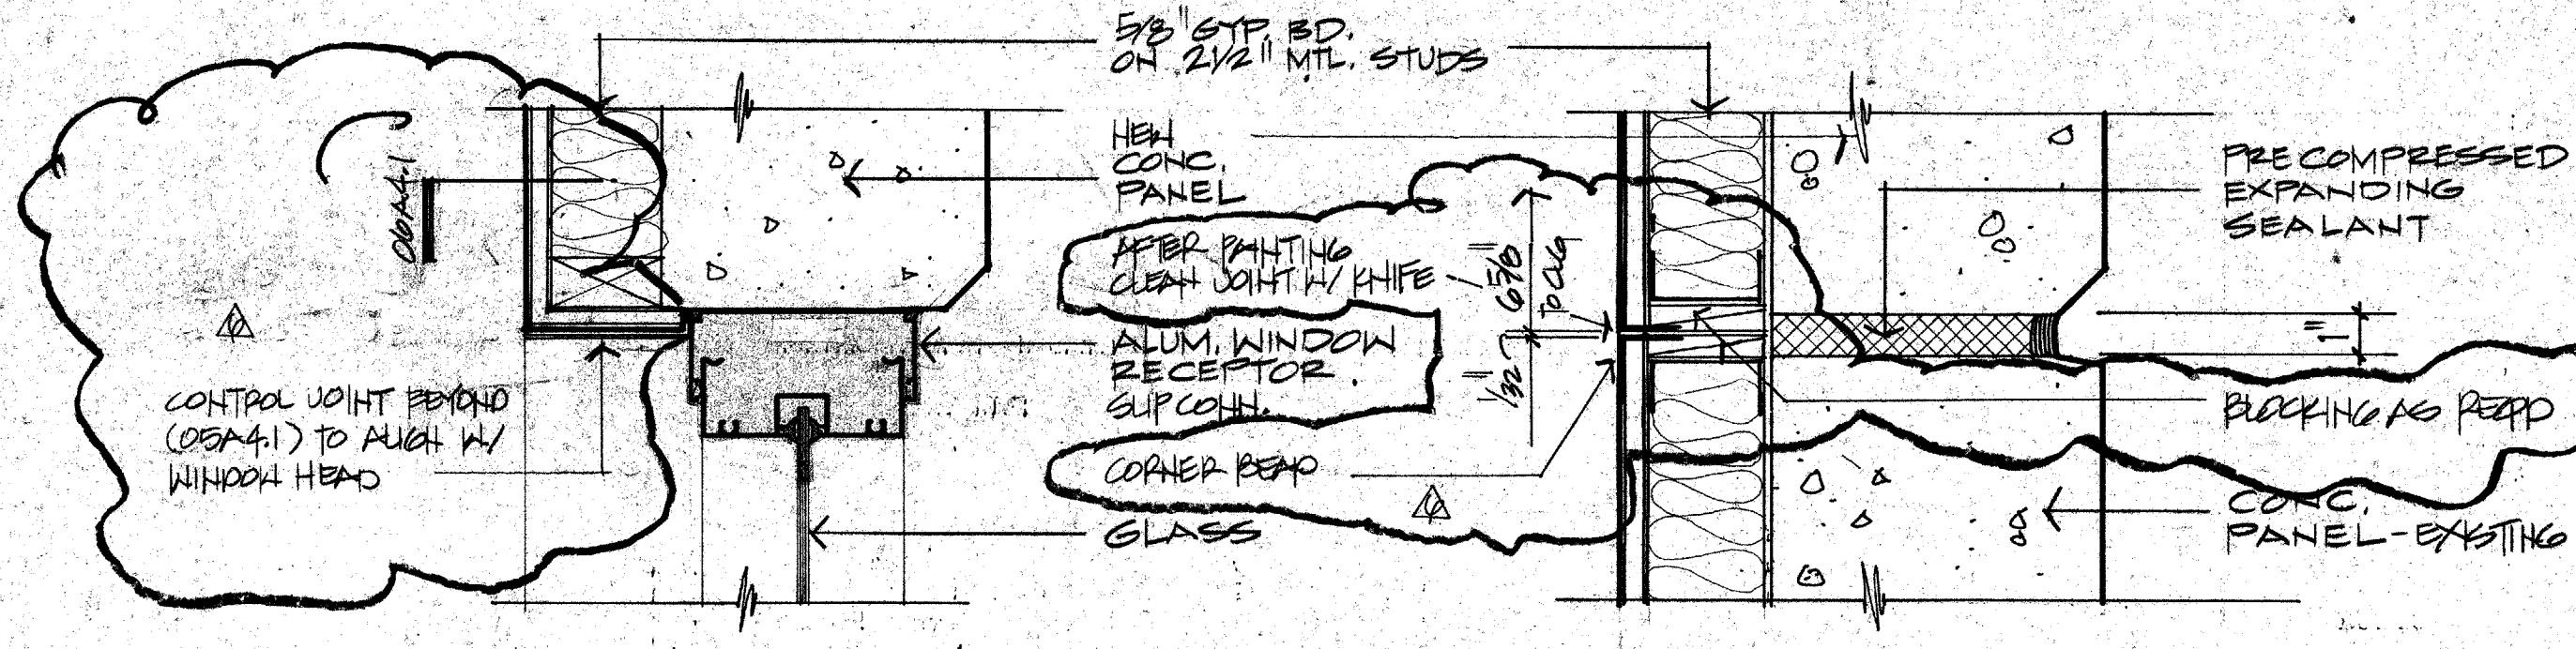


04 HEAD DETAIL  
A4.1 3/4" = 1'-0"

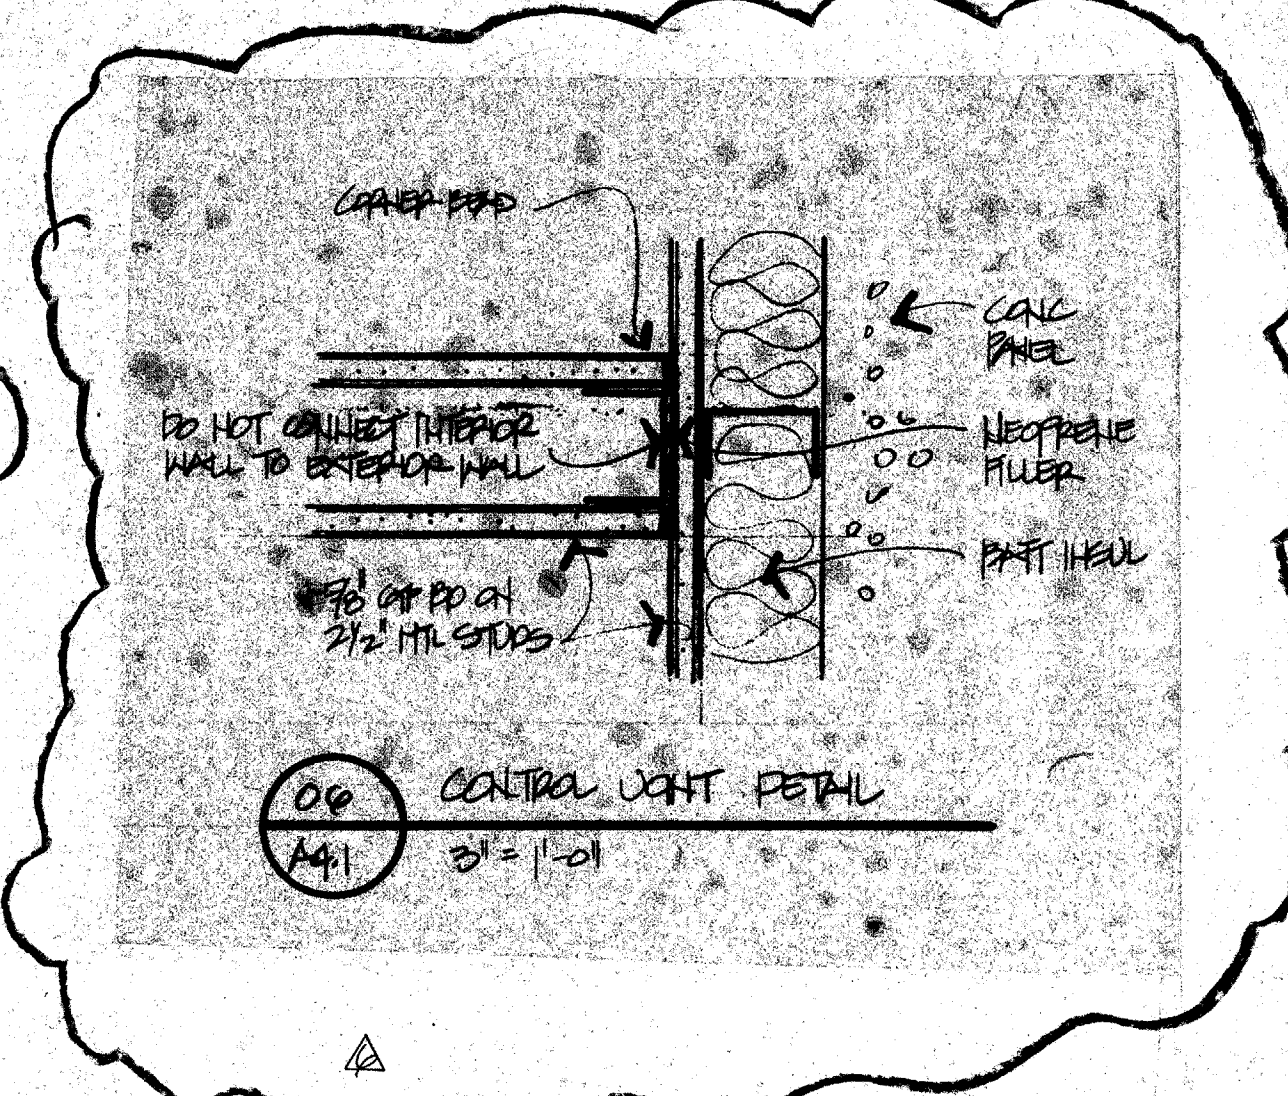



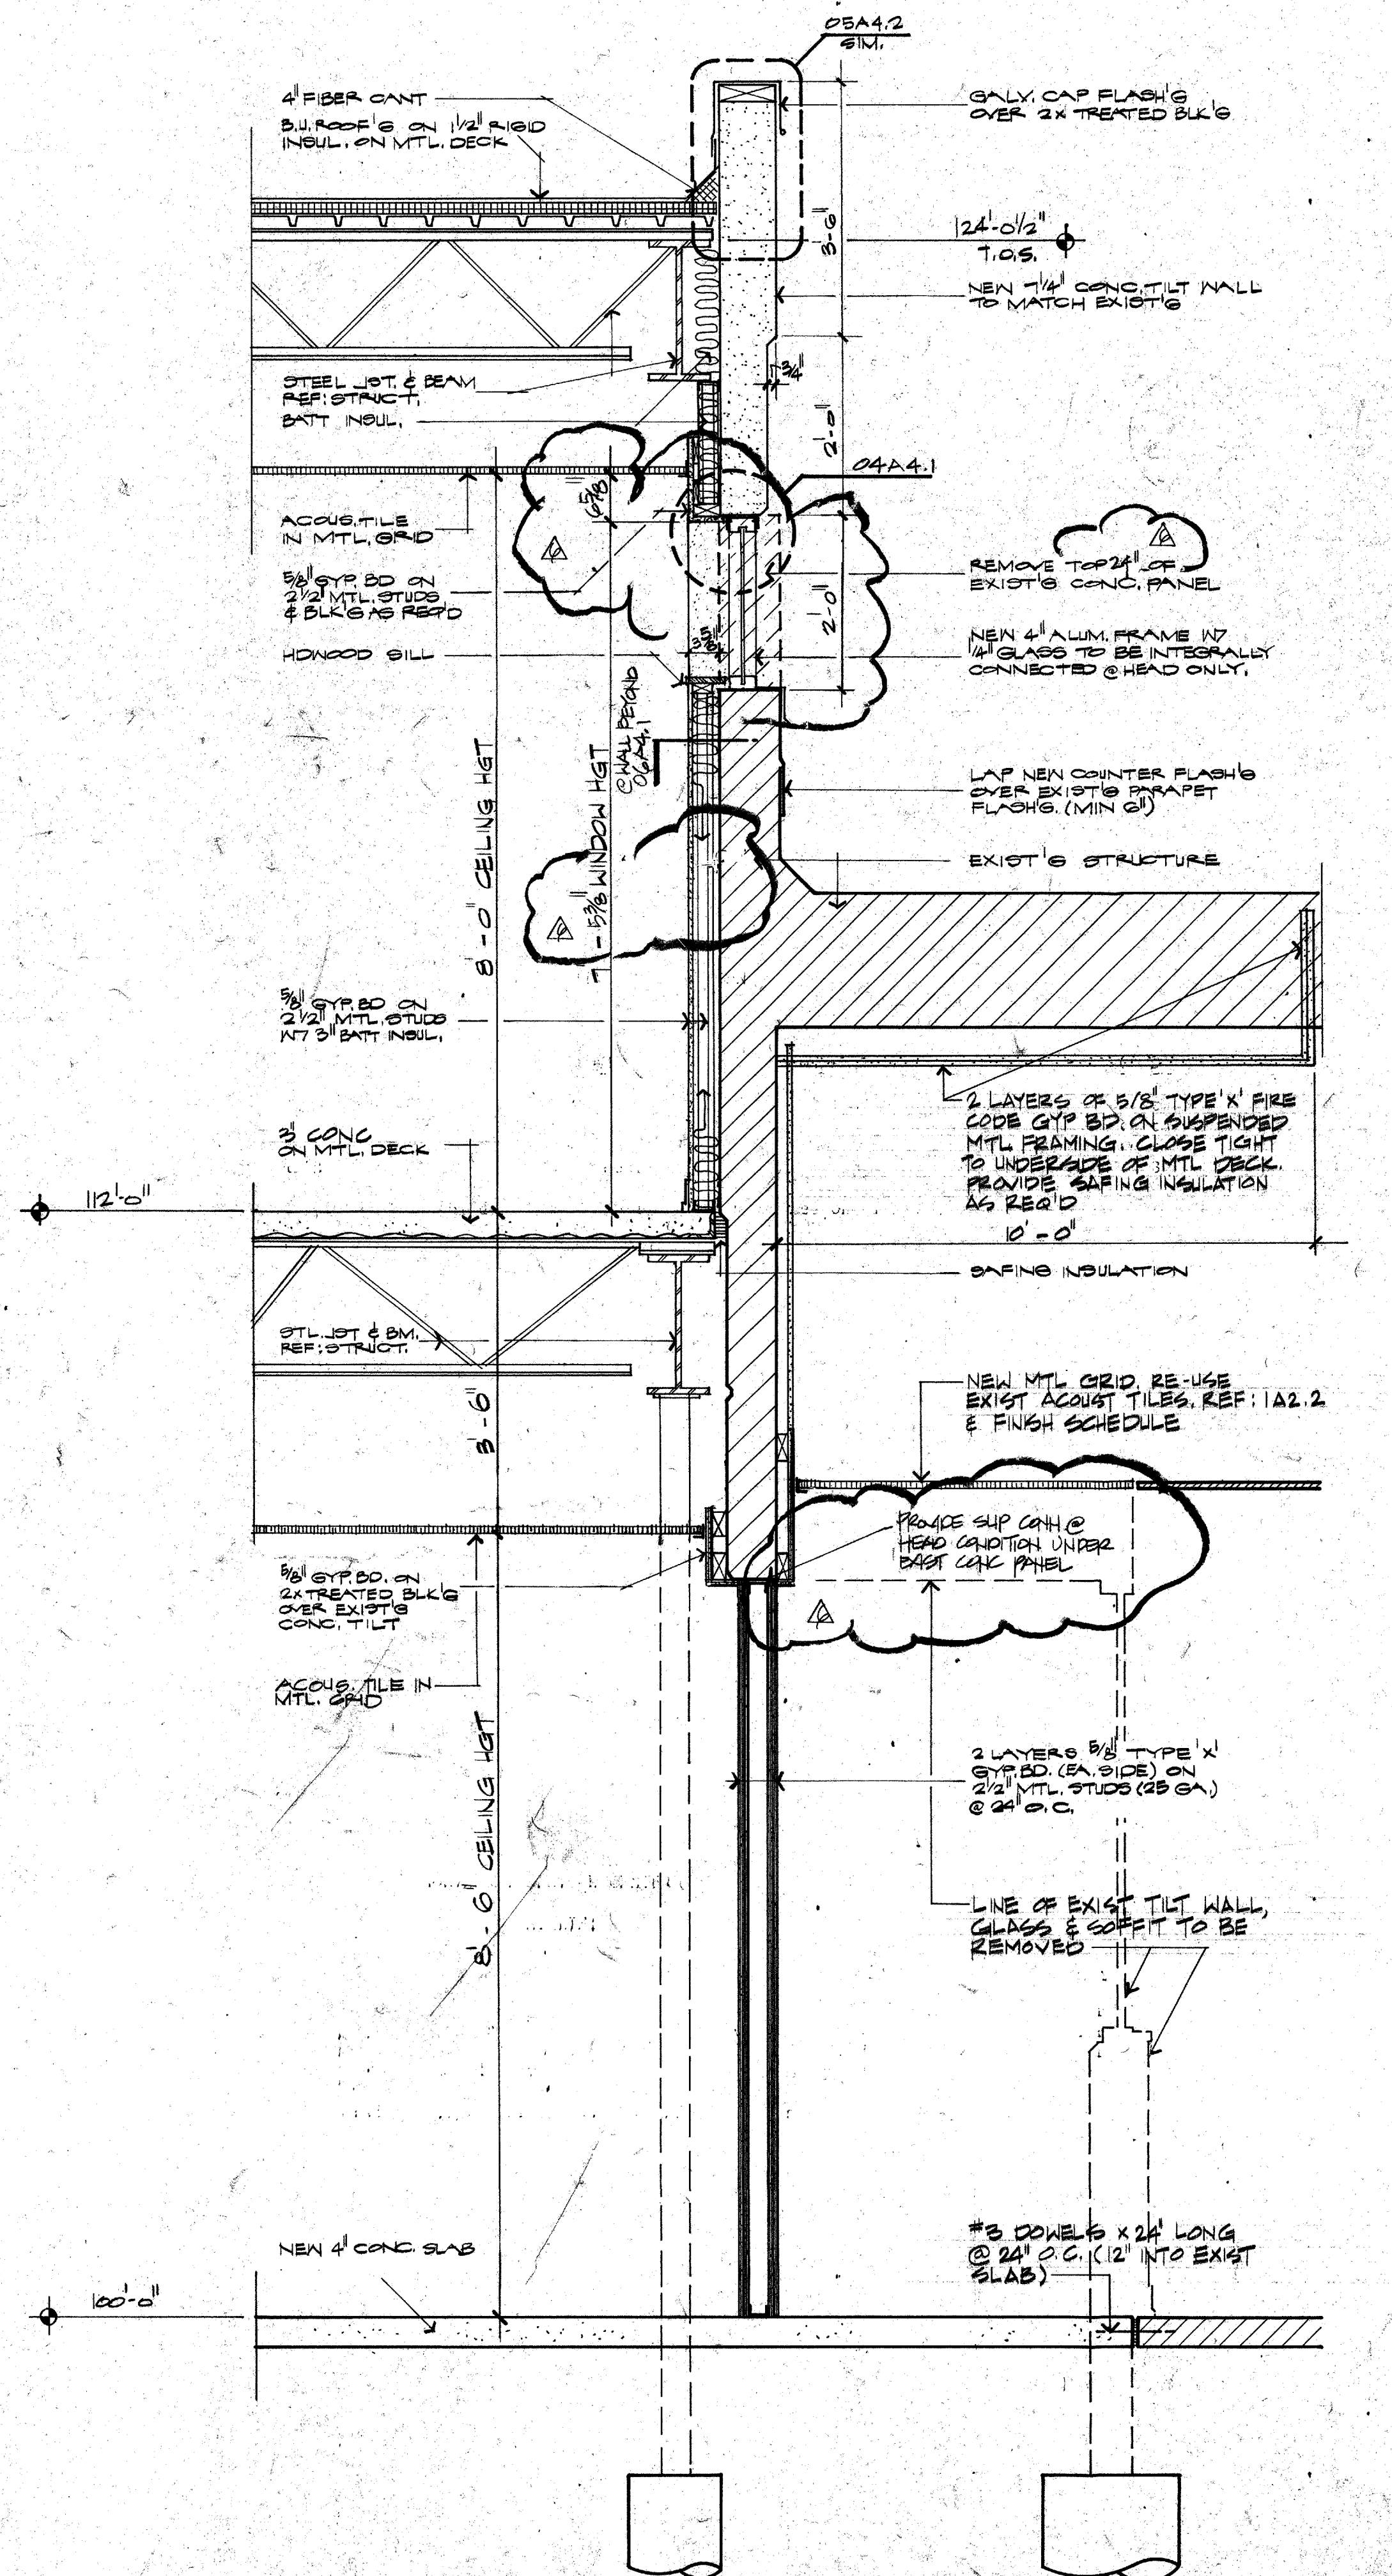

02 WALL SECTION  
A4.1 3/4" = 1'-0"

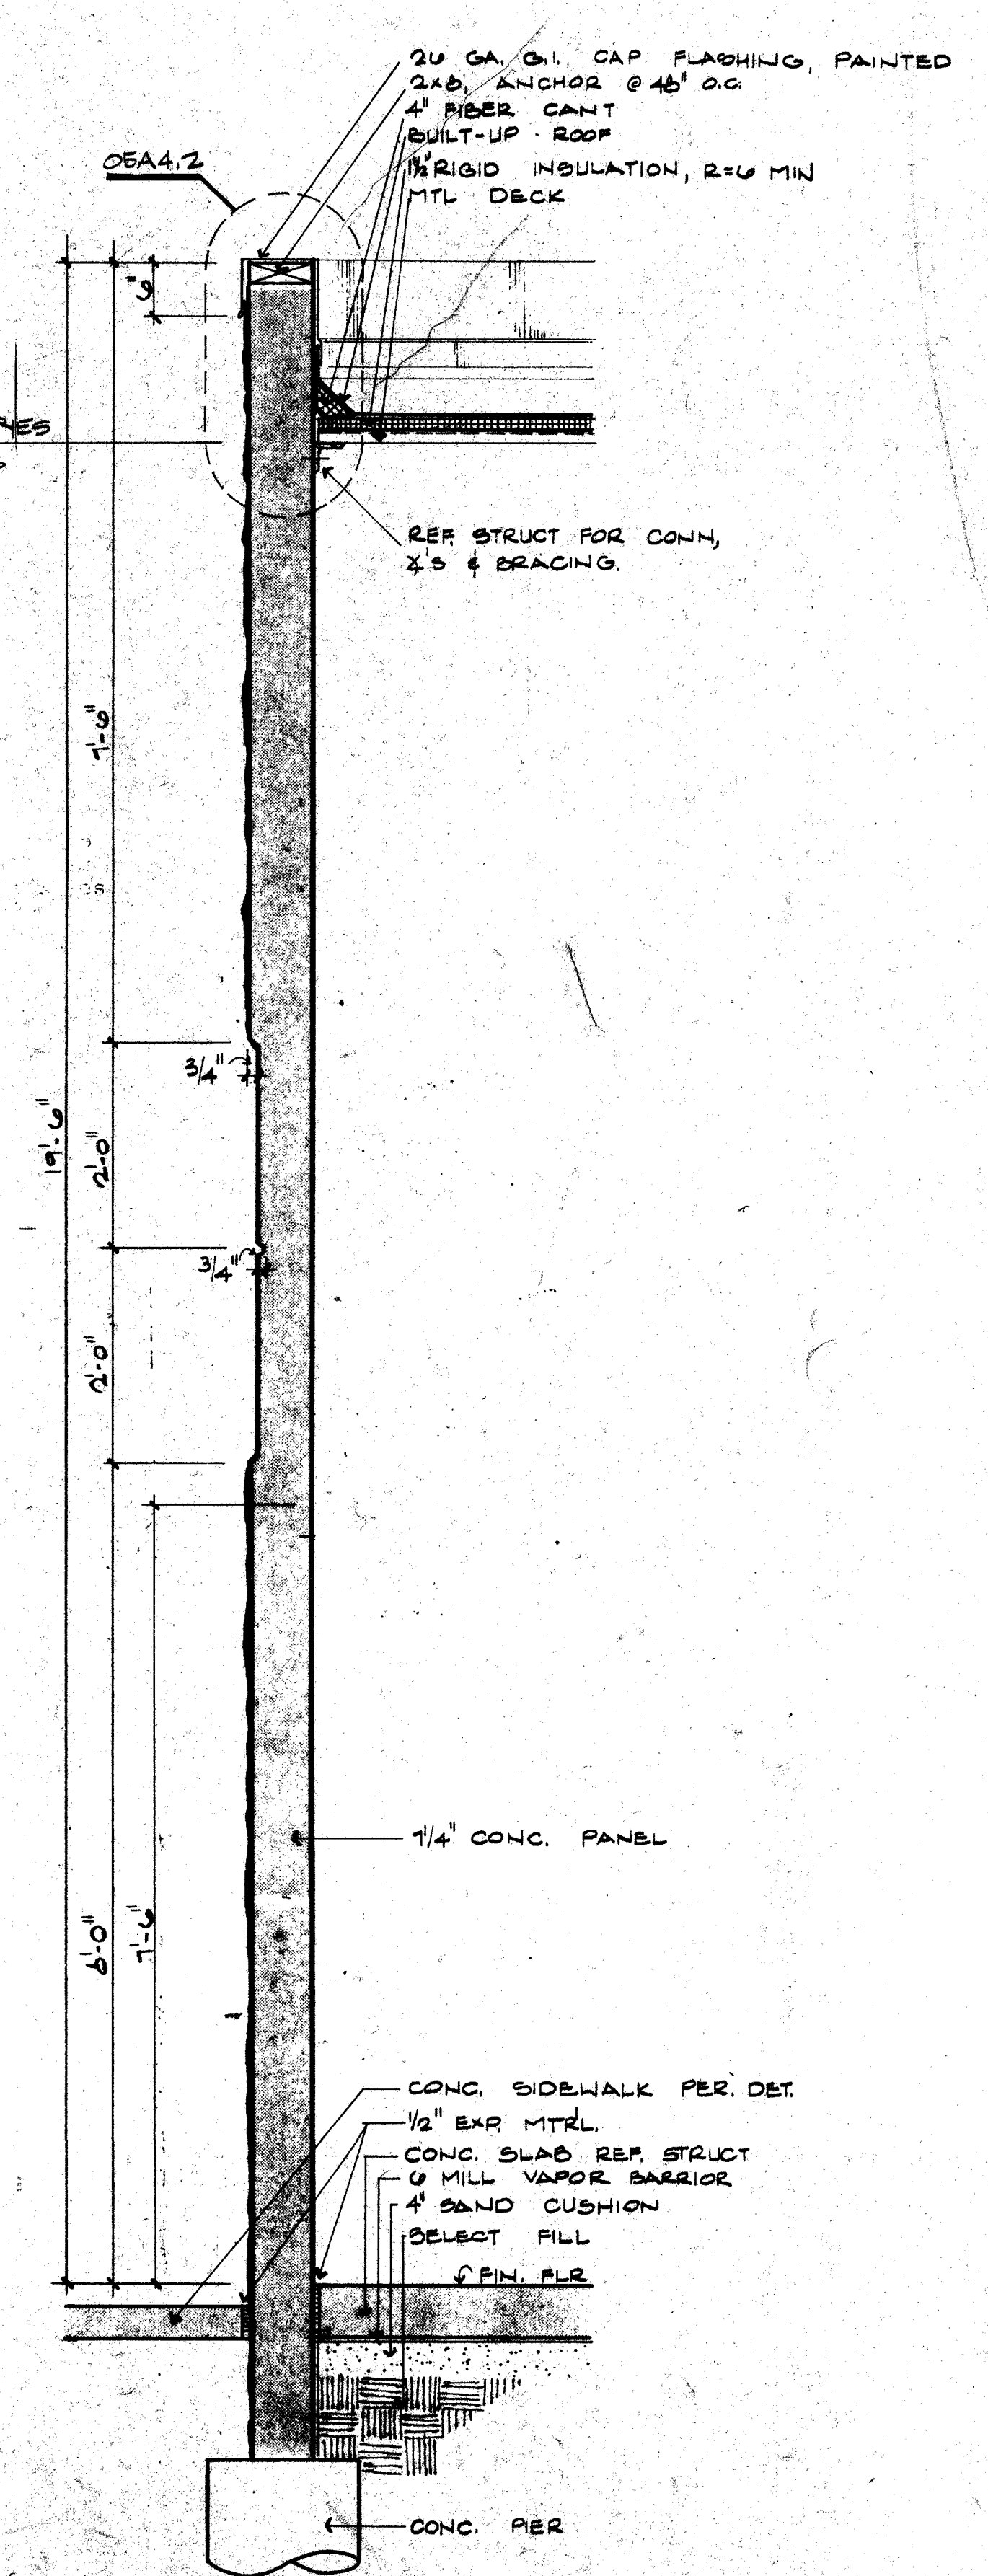

01 WALL SECTION  
A4.1 3/4" = 1'-0"

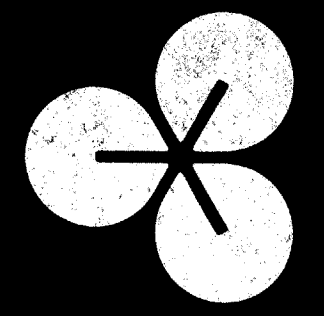

**EDI ARCHITECTS, INC.**  
ARCHITECTURE PLANNING INTERIOR DESIGN  
8440 WALNUT HILL LANE  
SUITE 300  
DALLAS, TEXAS 75201  
512 / 468-6308

---

TOWN OF  
**ADDISON**

---

**ADDITION TO  
PUBLIC WORKS SERVICE CENTER**  
Westgrove Road  
Addison Texas

---

DATE: 5-18-86  
11 JUNE 86  
24 JULY 1986 - BID  
REV 6.7 10.02.86

---

SHEET NO:  
**A4.1**  
OF SHEETS  
JOB NO: 851-137