





05 ENLARGED PLAN
A&1 1/4" = 1'-0"

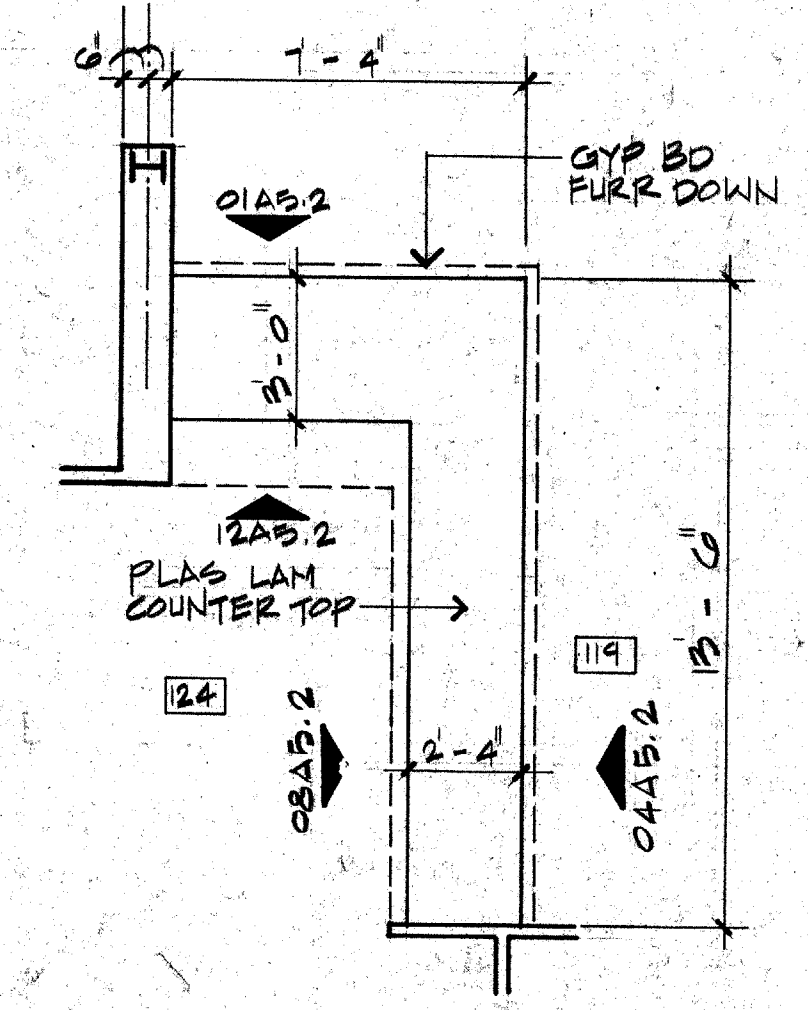


06 ENLARGED PLAN
A&1 1/4" = 1'-0"

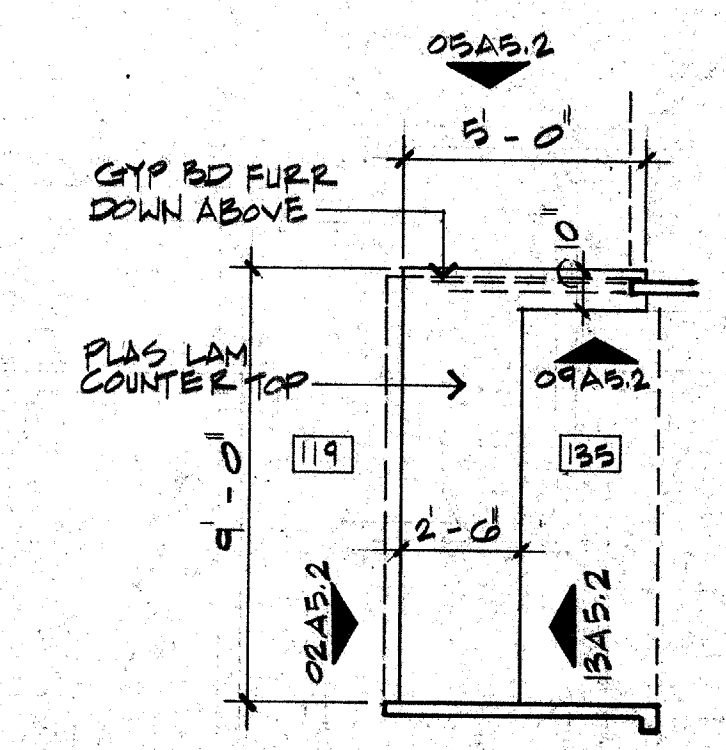


03 ENLARGED PLAN
A&1 1/4" = 1'-0"

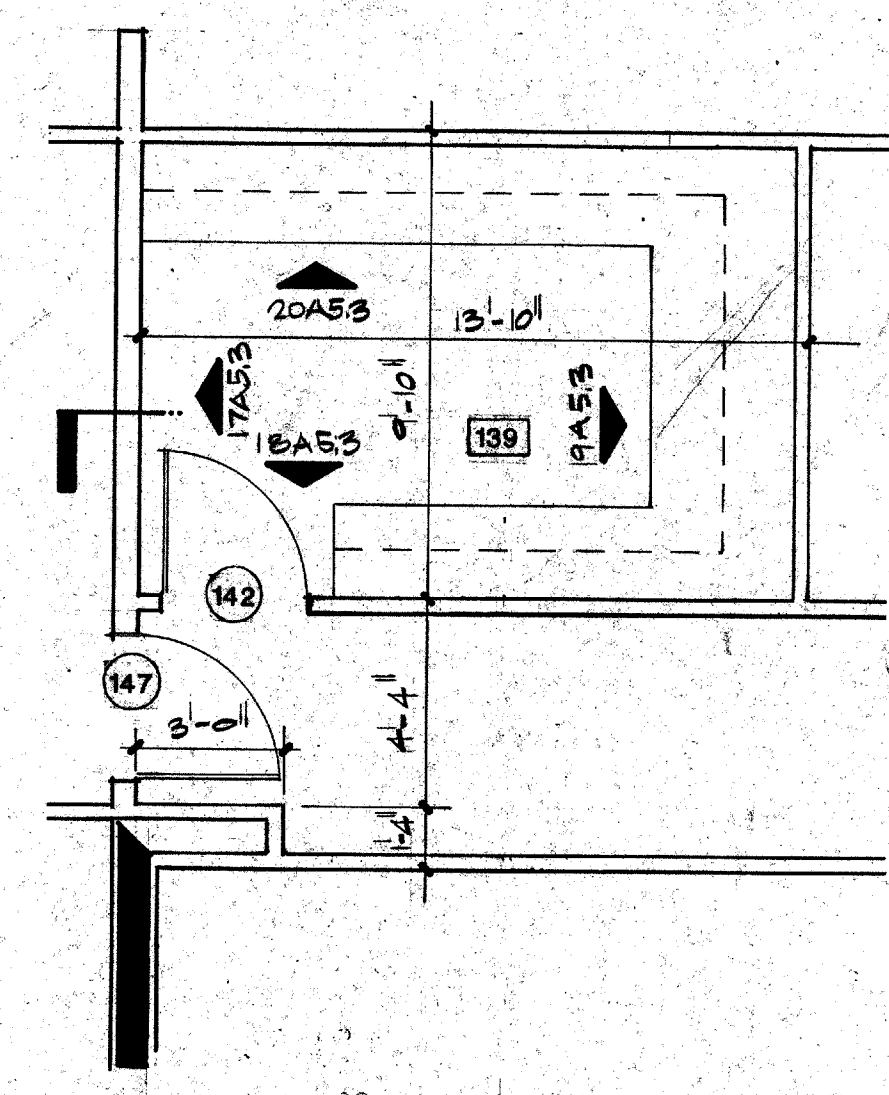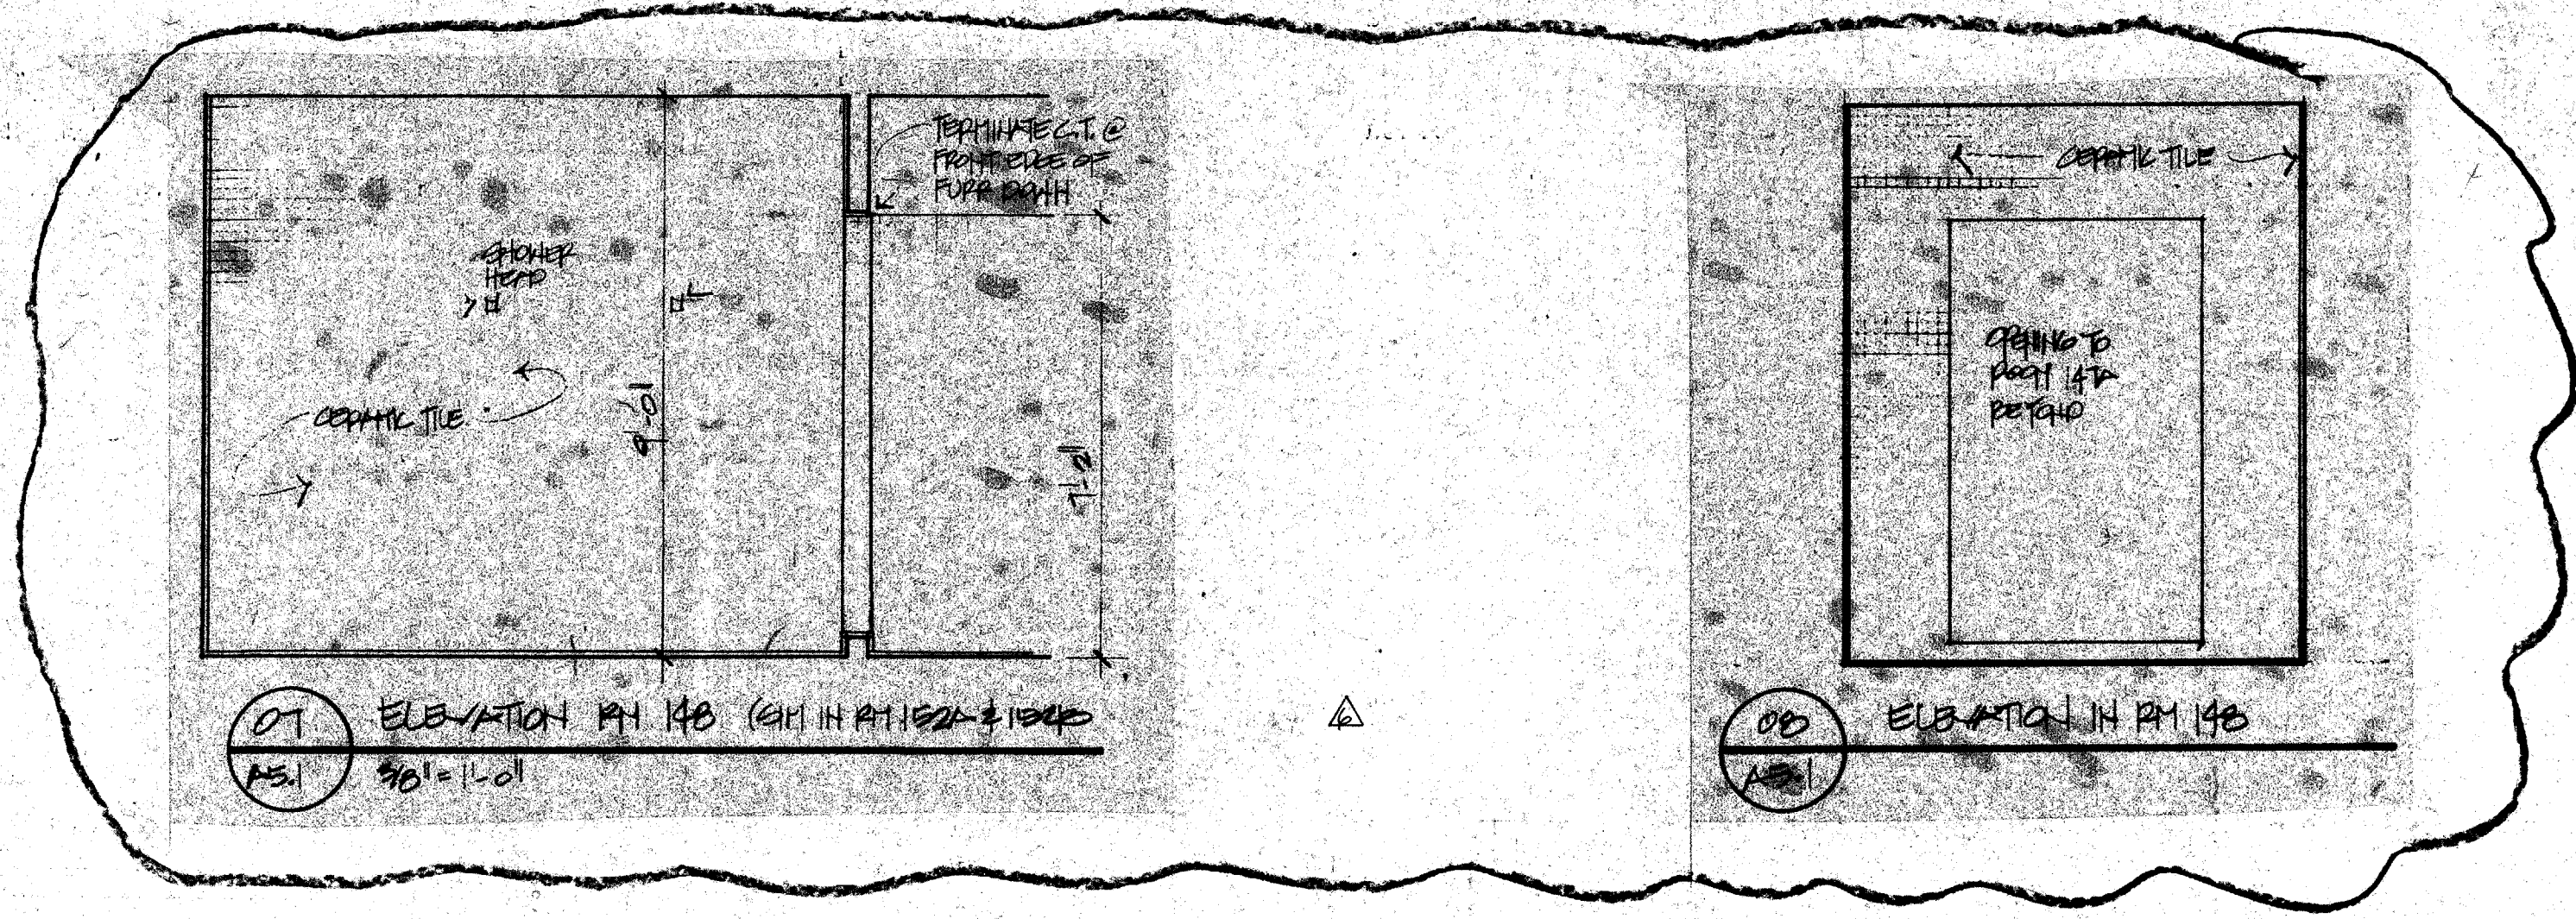

02 ENLARGED PLAN
A&1 1/4" = 1'-0"

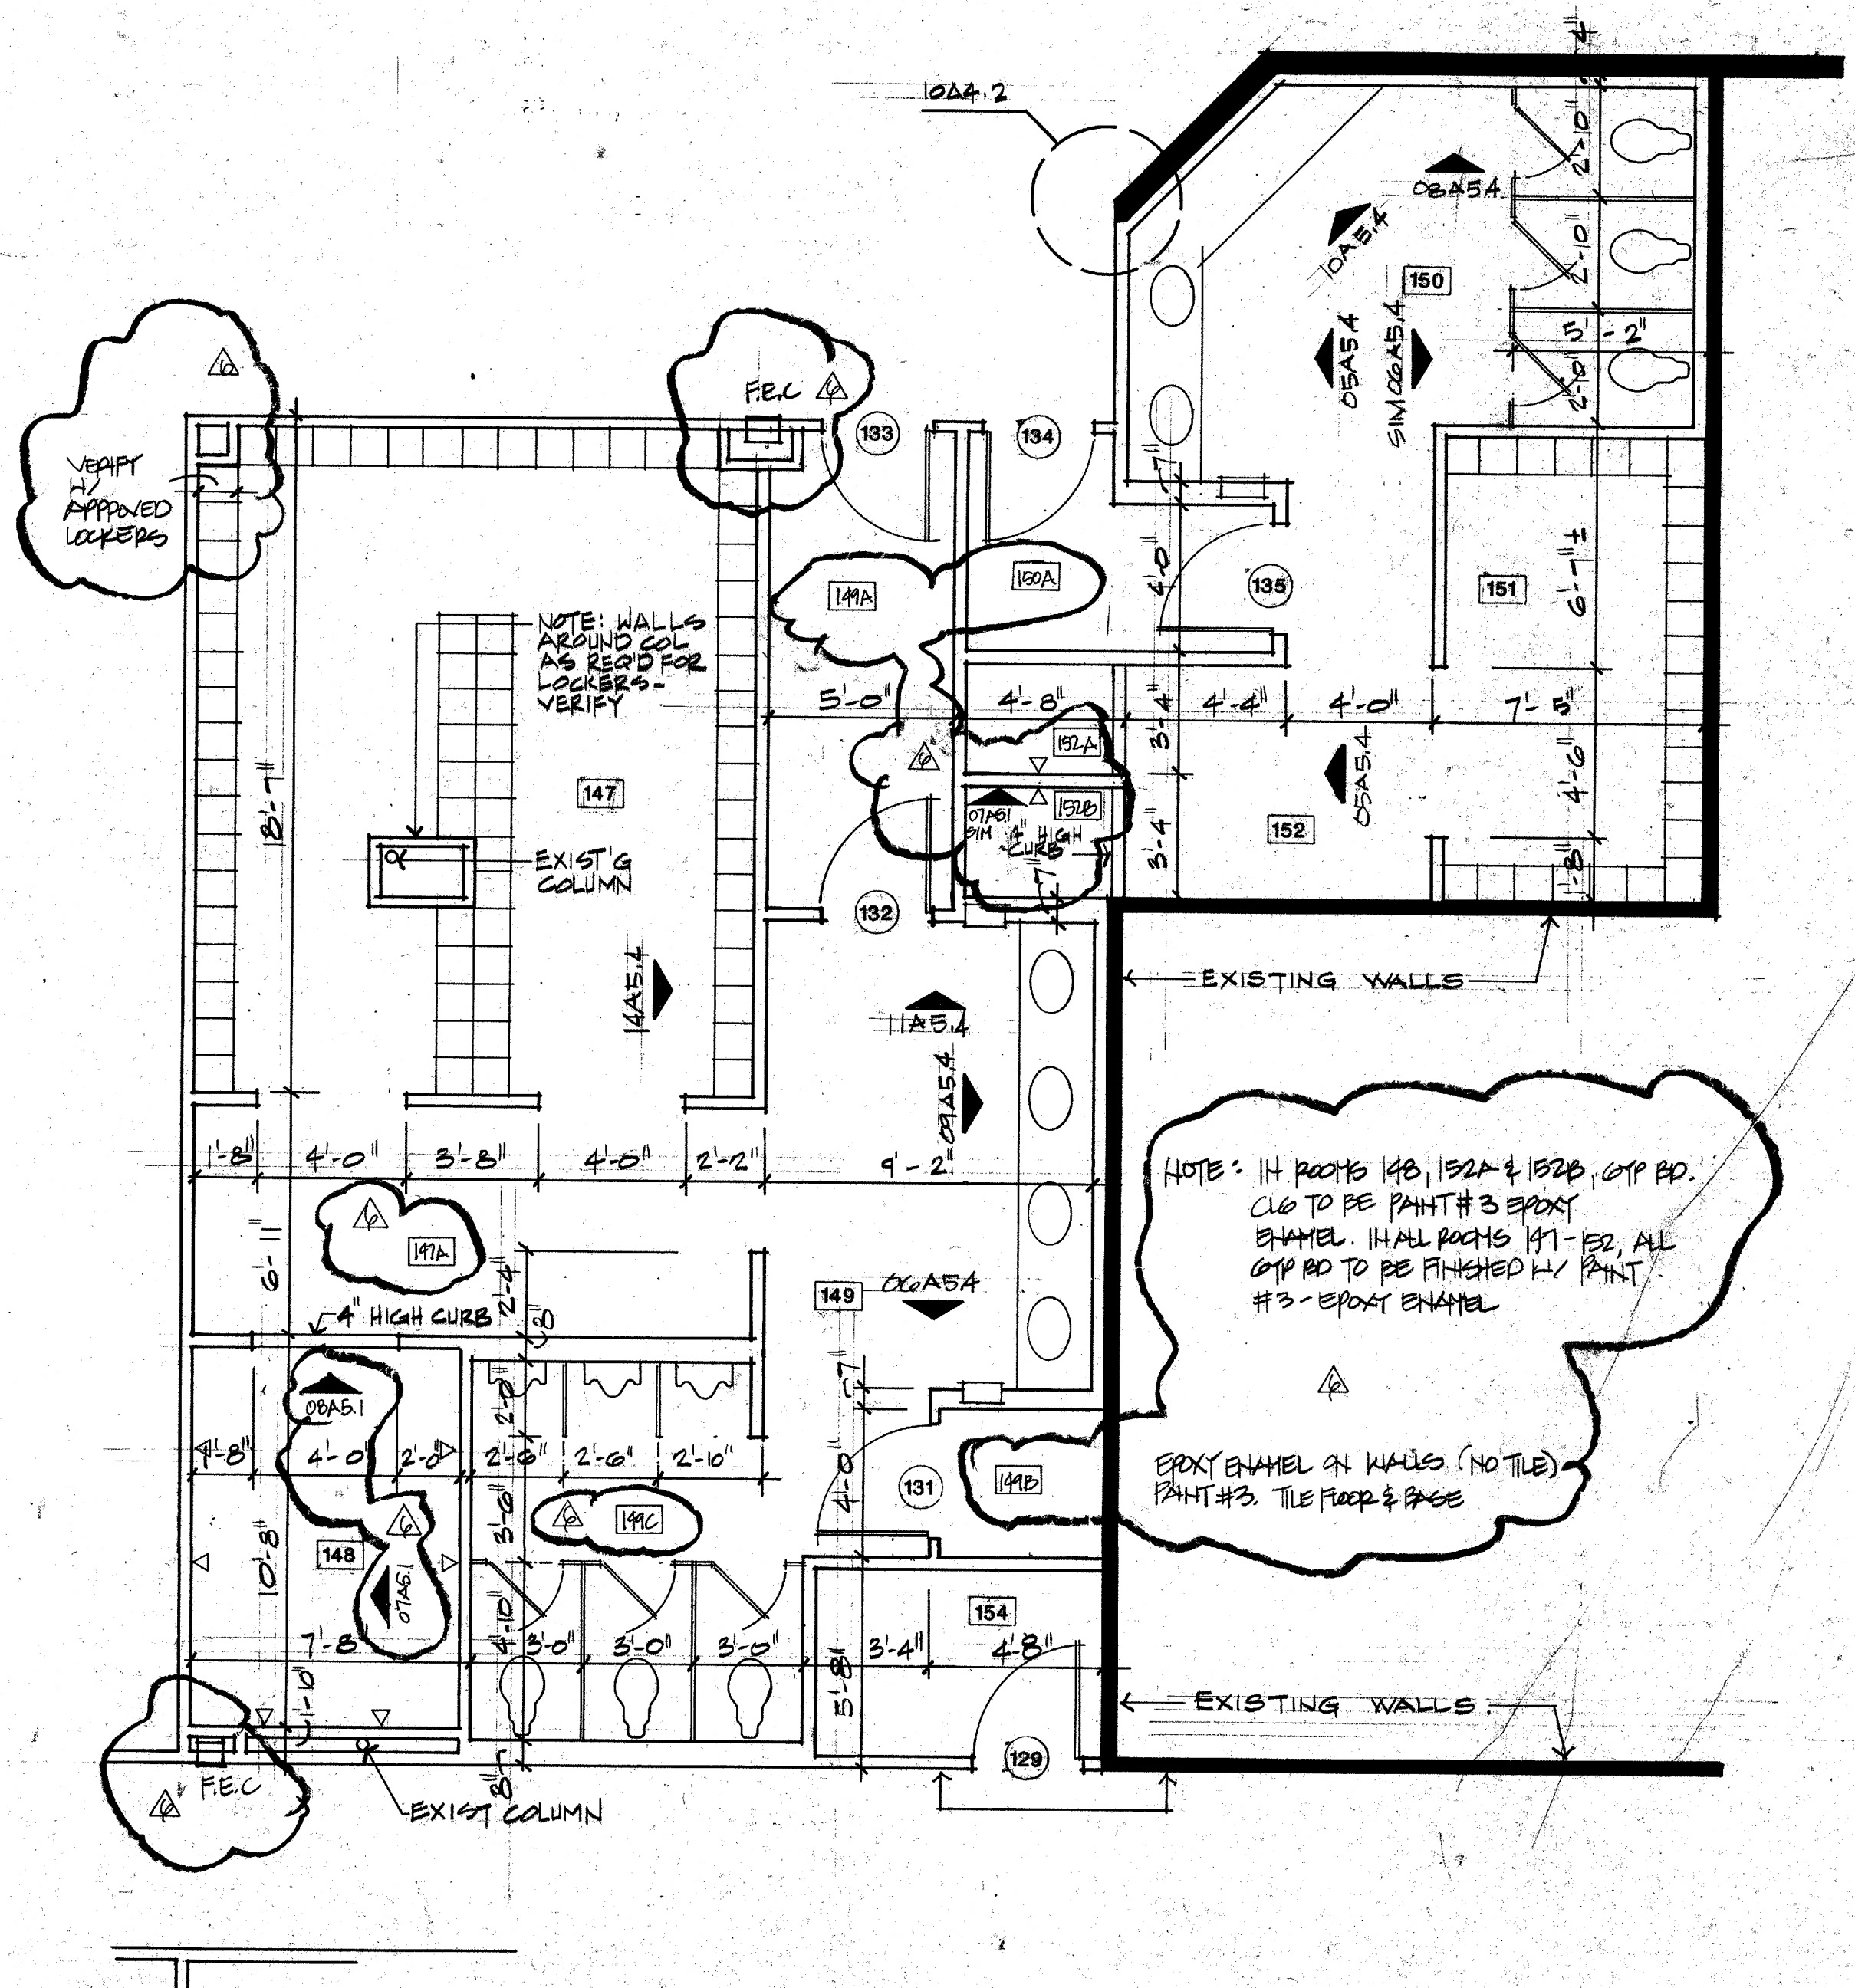

04 ENLARGED PLAN
A&1 1/4" = 1'-0"

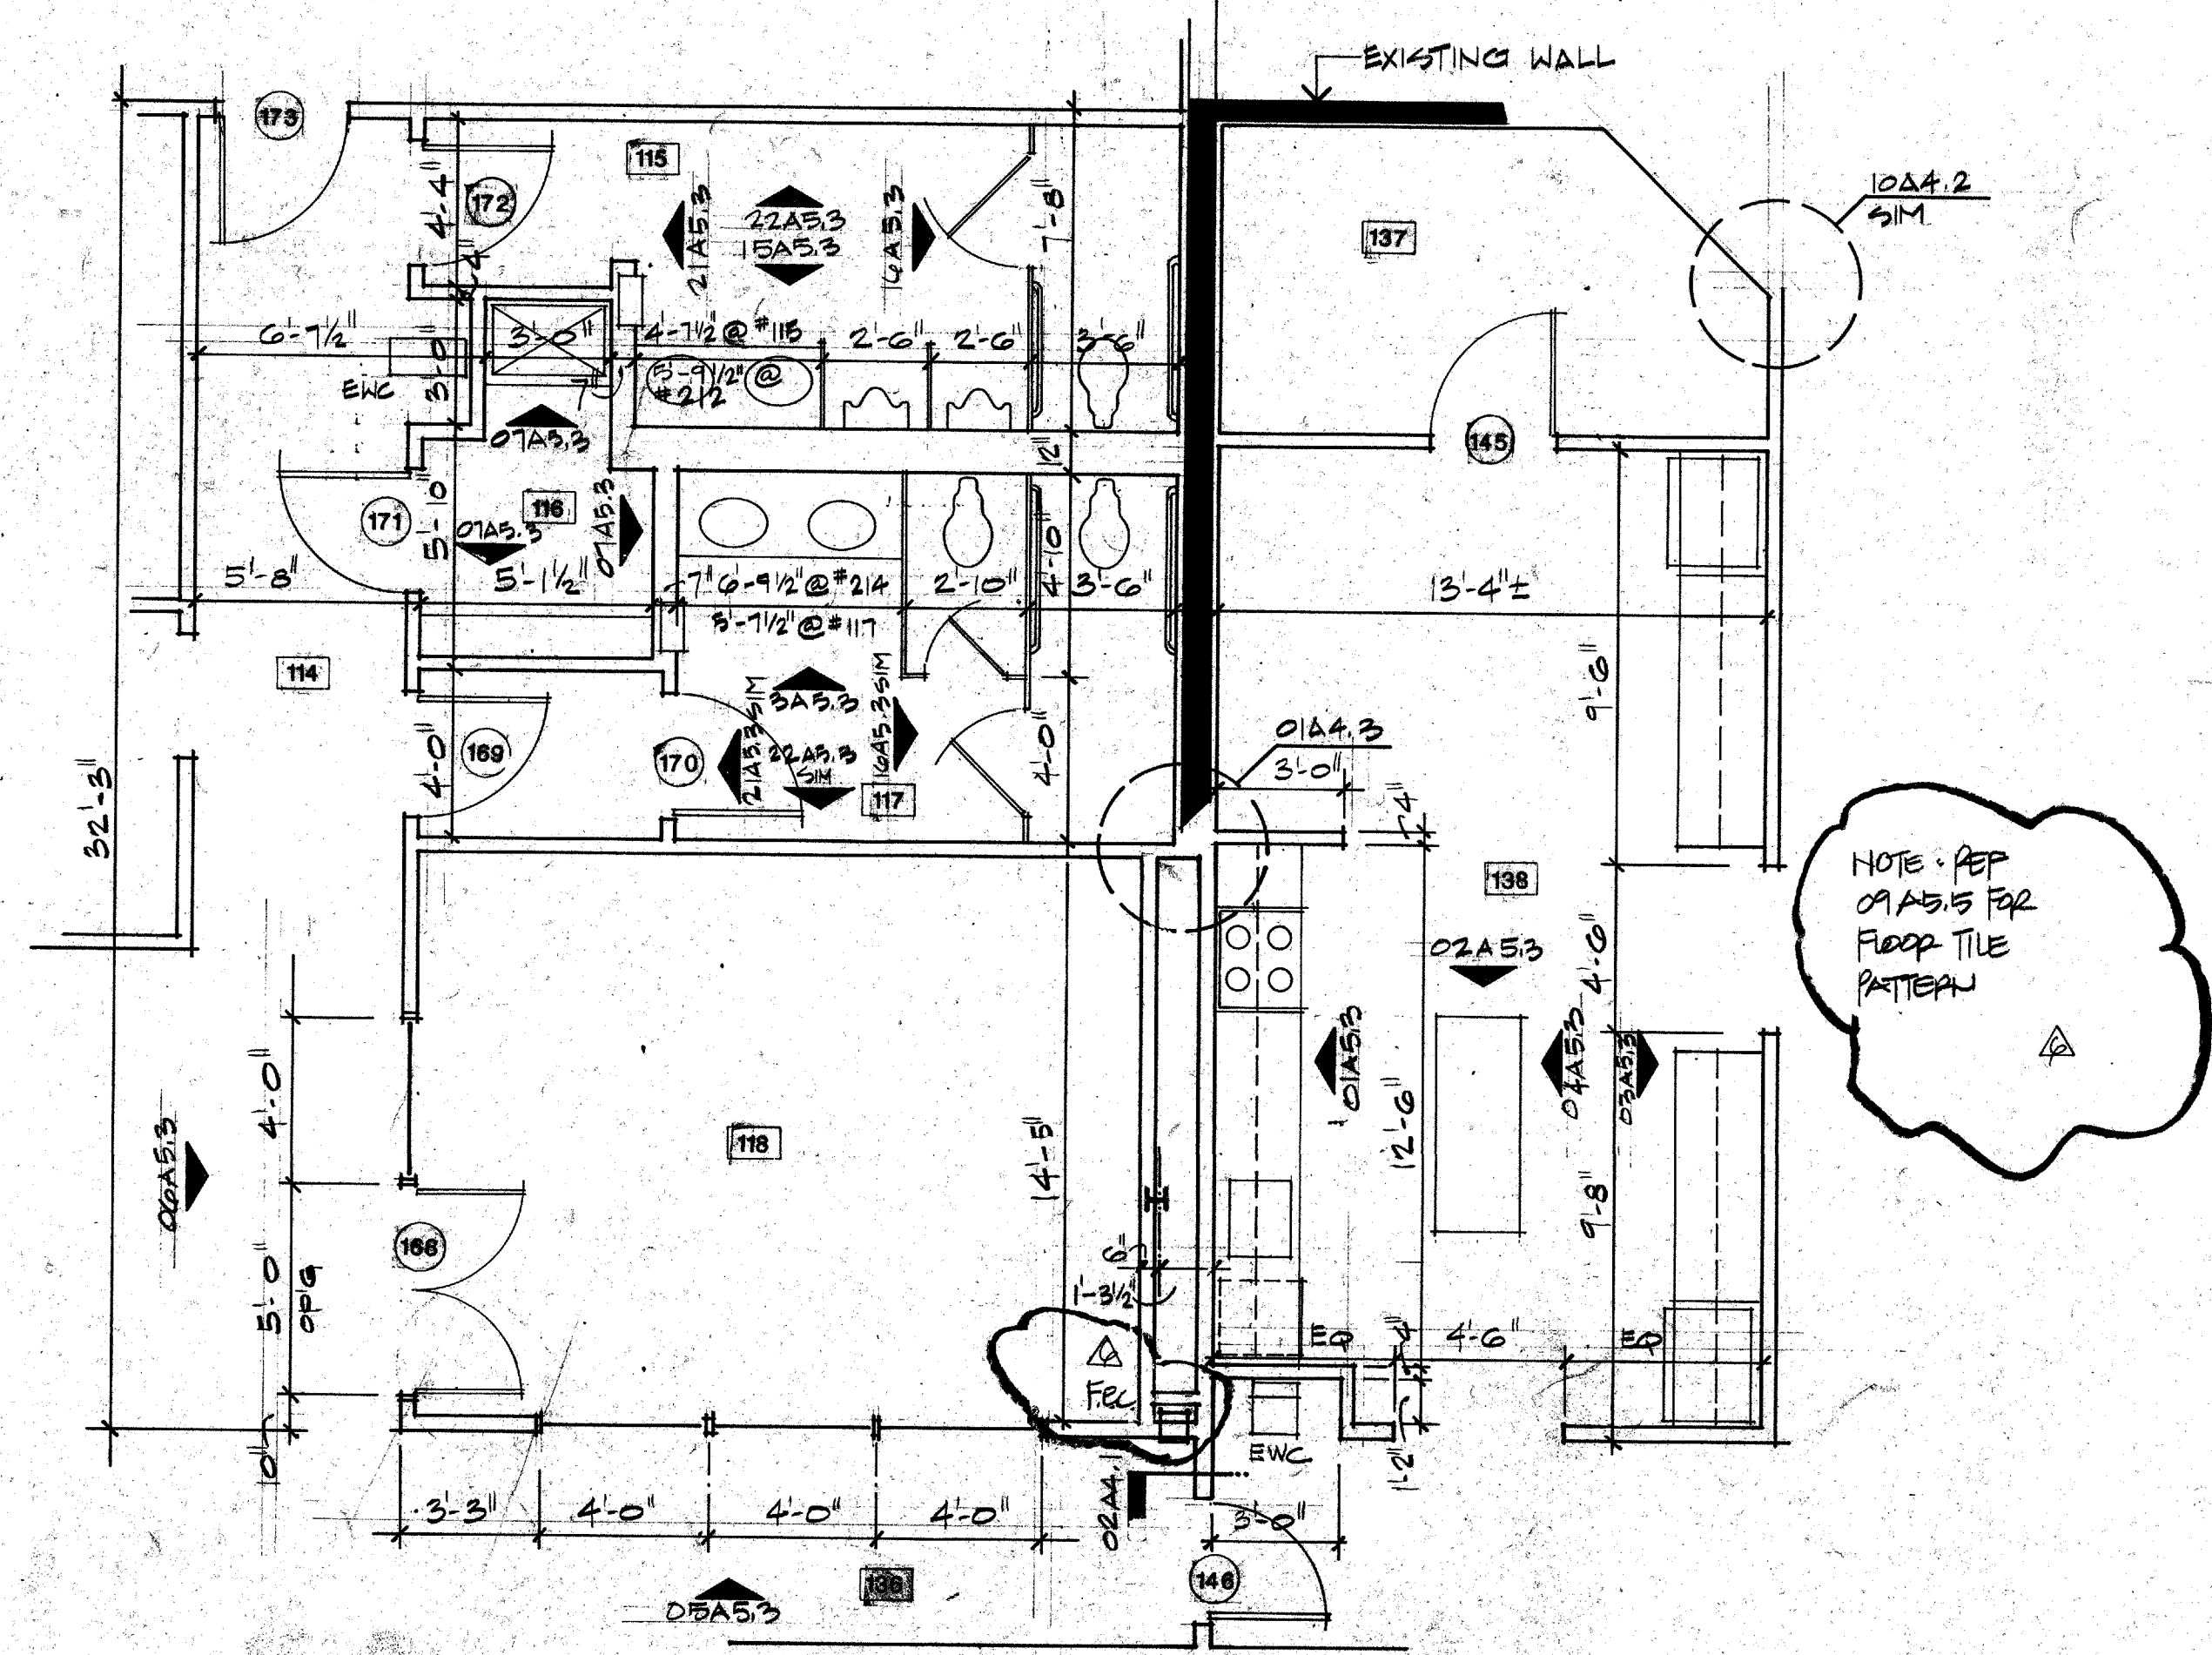

01 ENLARGED PLAN
A&1 1/4" = 1'-0"

EDI ARCHITECTS, INC.
ARCHITECTURE PLANNING ENGINEERING INTERIOR DESIGN
AMERICAN BANK BUILDING
SUITE 1000 DALLAS, TEXAS 75201
DALLAS, TEXAS 75201
214 / 750-1998
FAX / 750-6308

TOWN OF
ADDISON

**ADDITION TO
PUBLIC WORKS SERVICE CENTER**
Addison Texas
Westgrove Road

DATE 5-16-86
11 JUNE 86
24 JULY 1986 - BID

SHEET NO.
151
OF SHEETS
JOB NO. 551-137