




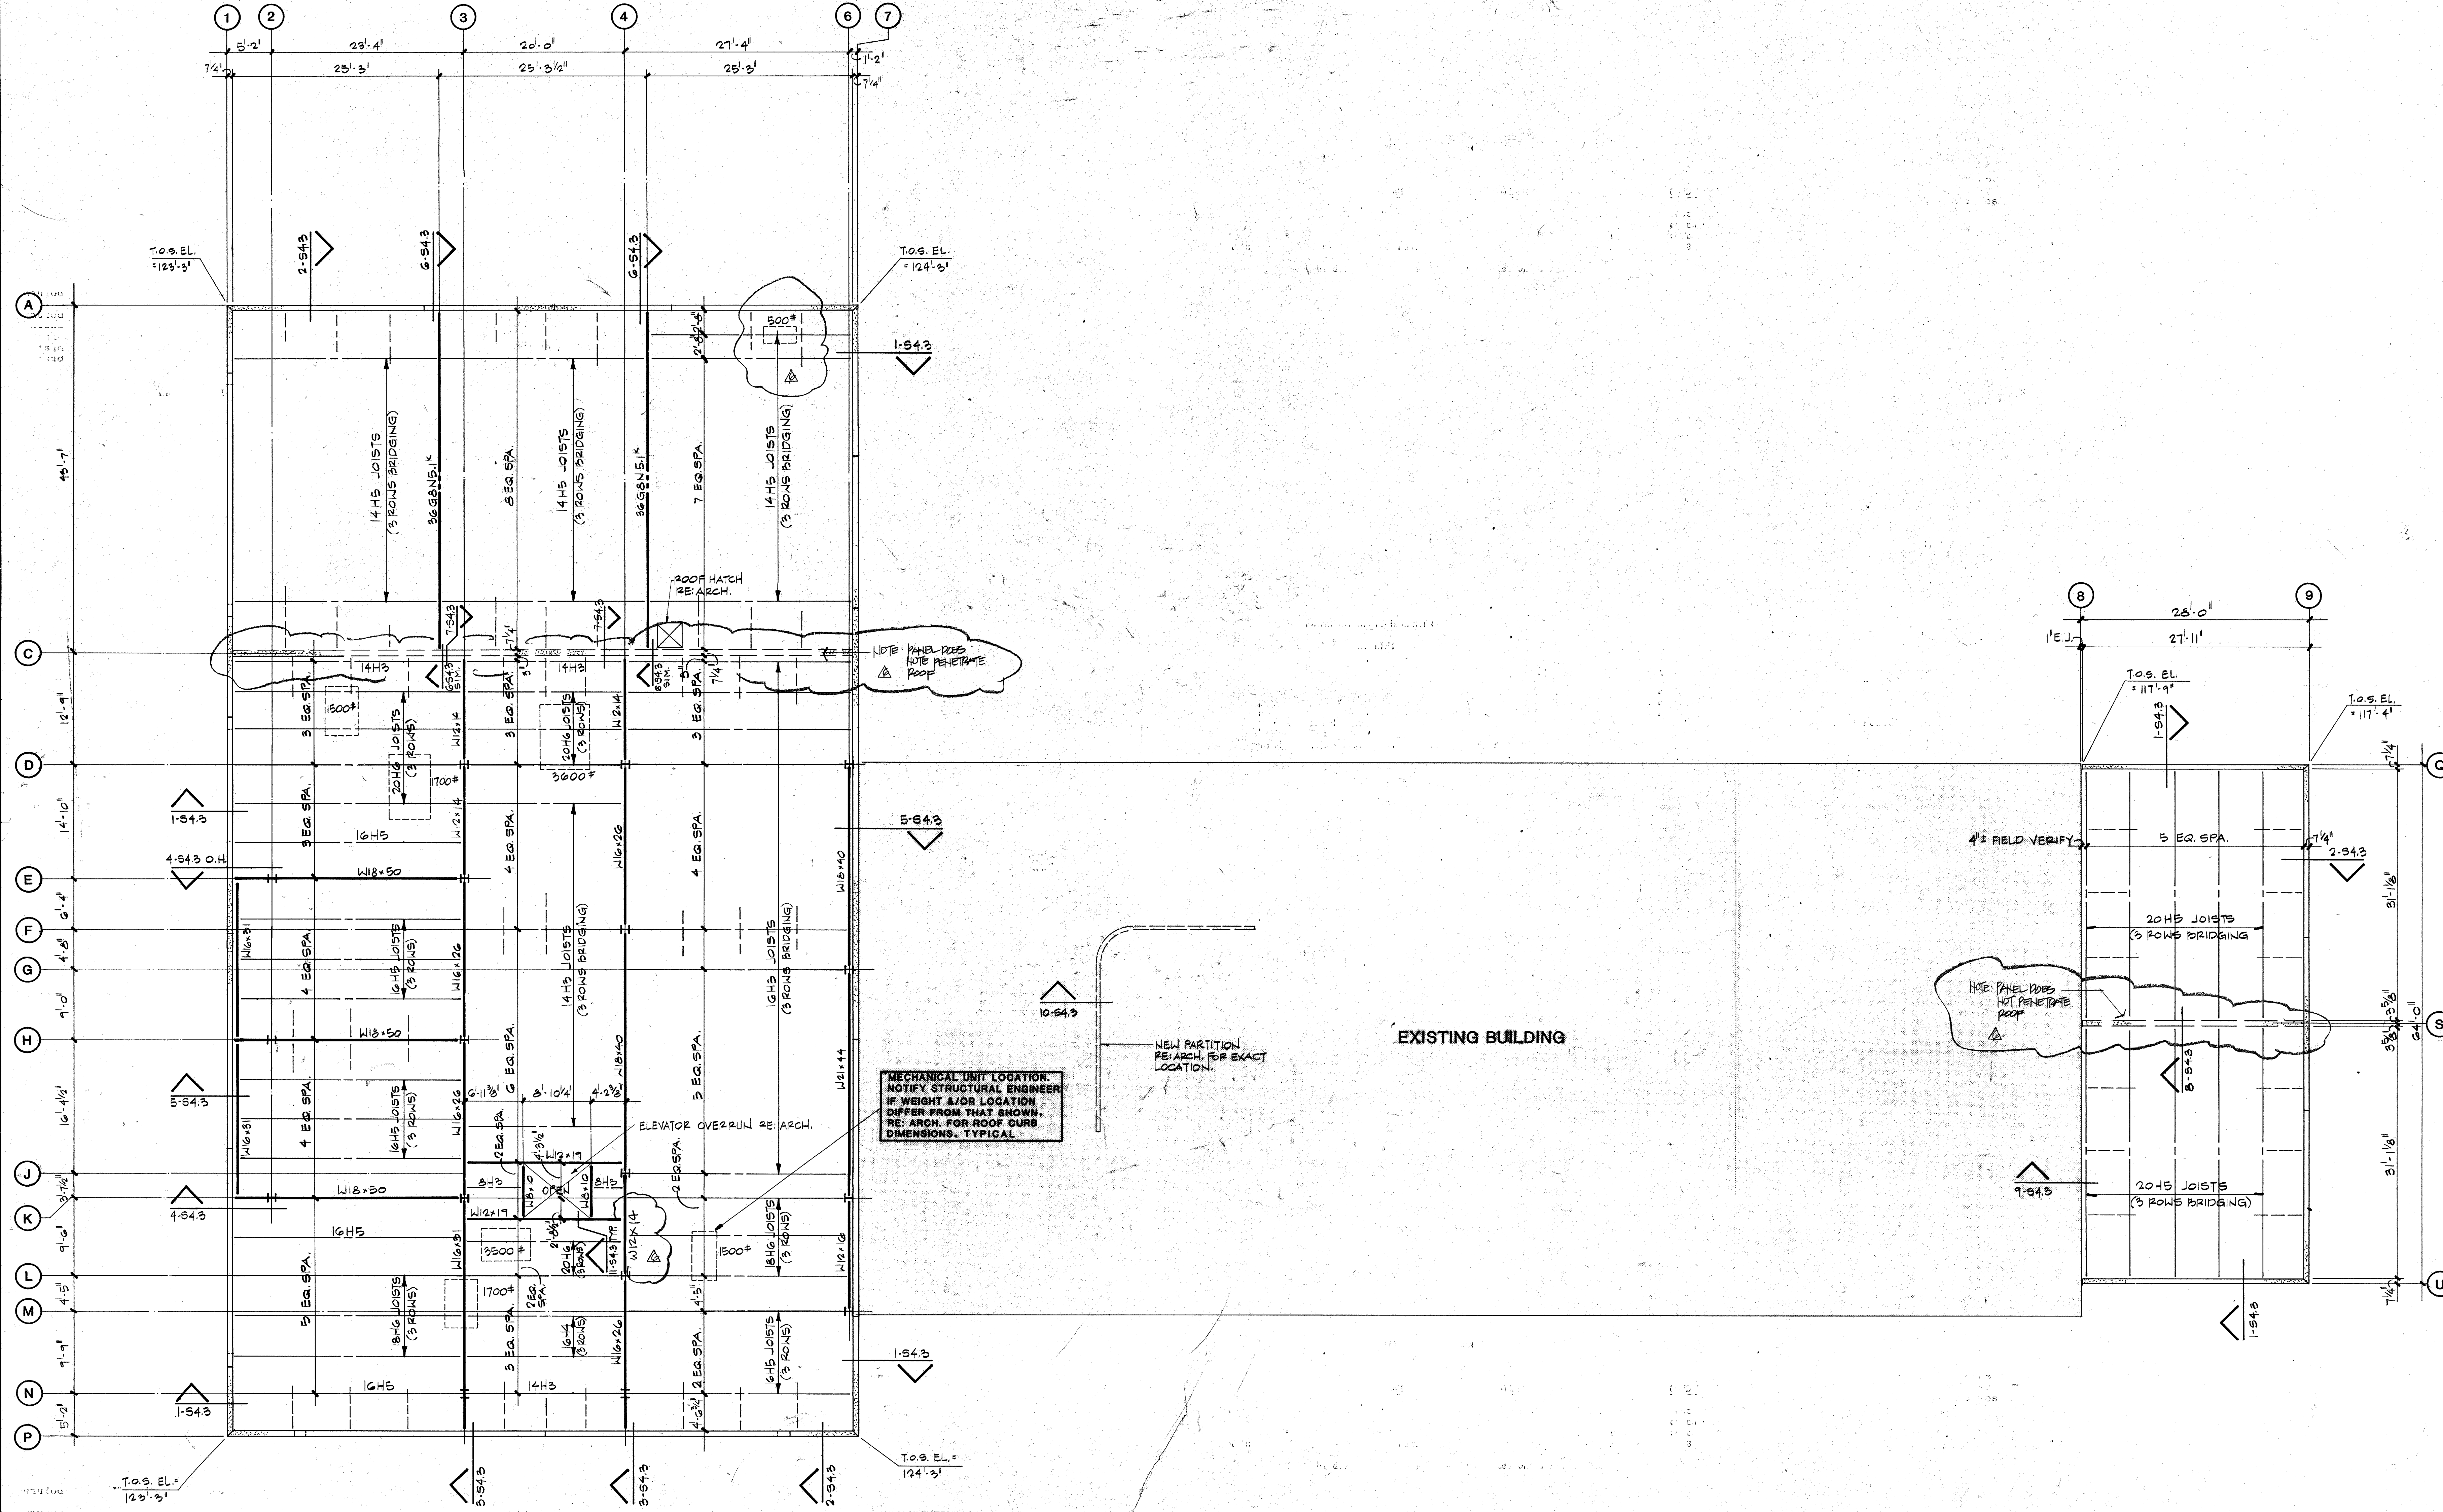

ROOF FRAMING PLAN
SCALE: 1/8" = 1'-0"

- PLAN NOTES:
1. REFERENCE ELEVATION 100'-0" EQUALS SITE ELEVATION 657.50'.
 2. REFERENCE SHEET S1.1 FOR GENERAL NOTES AND TYPICAL DETAILS.
 3. REFERENCE SHEET S4.2 & S4.3 FOR FRAMING DETAILS.
 4. T.O.S. ELEV. = xxx'-x" INDICATES BOTTOM OF ROOF DECK.
 5. R.D. INDICATES ROOF DRAIN. RE: ARCH. FOR EXACT LOCATION AND DETAILS.

DRAWING
TO BE USED FOR CONSTRUCTION

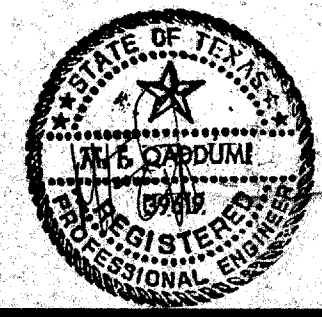

INTERFIELD ENGINEERING CO.
CONSULTING ENGINEERS
5401 N. CENTRAL EXPWY.
SUITE 340
DALLAS, TEXAS 75205
(214) 526-6854

PROPERTY OF
LANDSCAPE DEVELOPMENT
TOWN OF ADDISON
S2.3
OF SHEETS
JOB NO: 851-137

ADDITION TO
PUBLIC WORKS SERVICE CENTER
Westgrove Road
Addison Texas

TOWN OF
ADDISON

EDI ARCHITECTS, INC.
ARCHITECTURE PLANNING ENGINEERING INTERIOR DESIGN
8440 WALNUT HILL LANE
AMERICAN BANK TOWER
SUITE 100
DALLAS, TEXAS 75201
214 / 750-1848
518 / 488-6308

