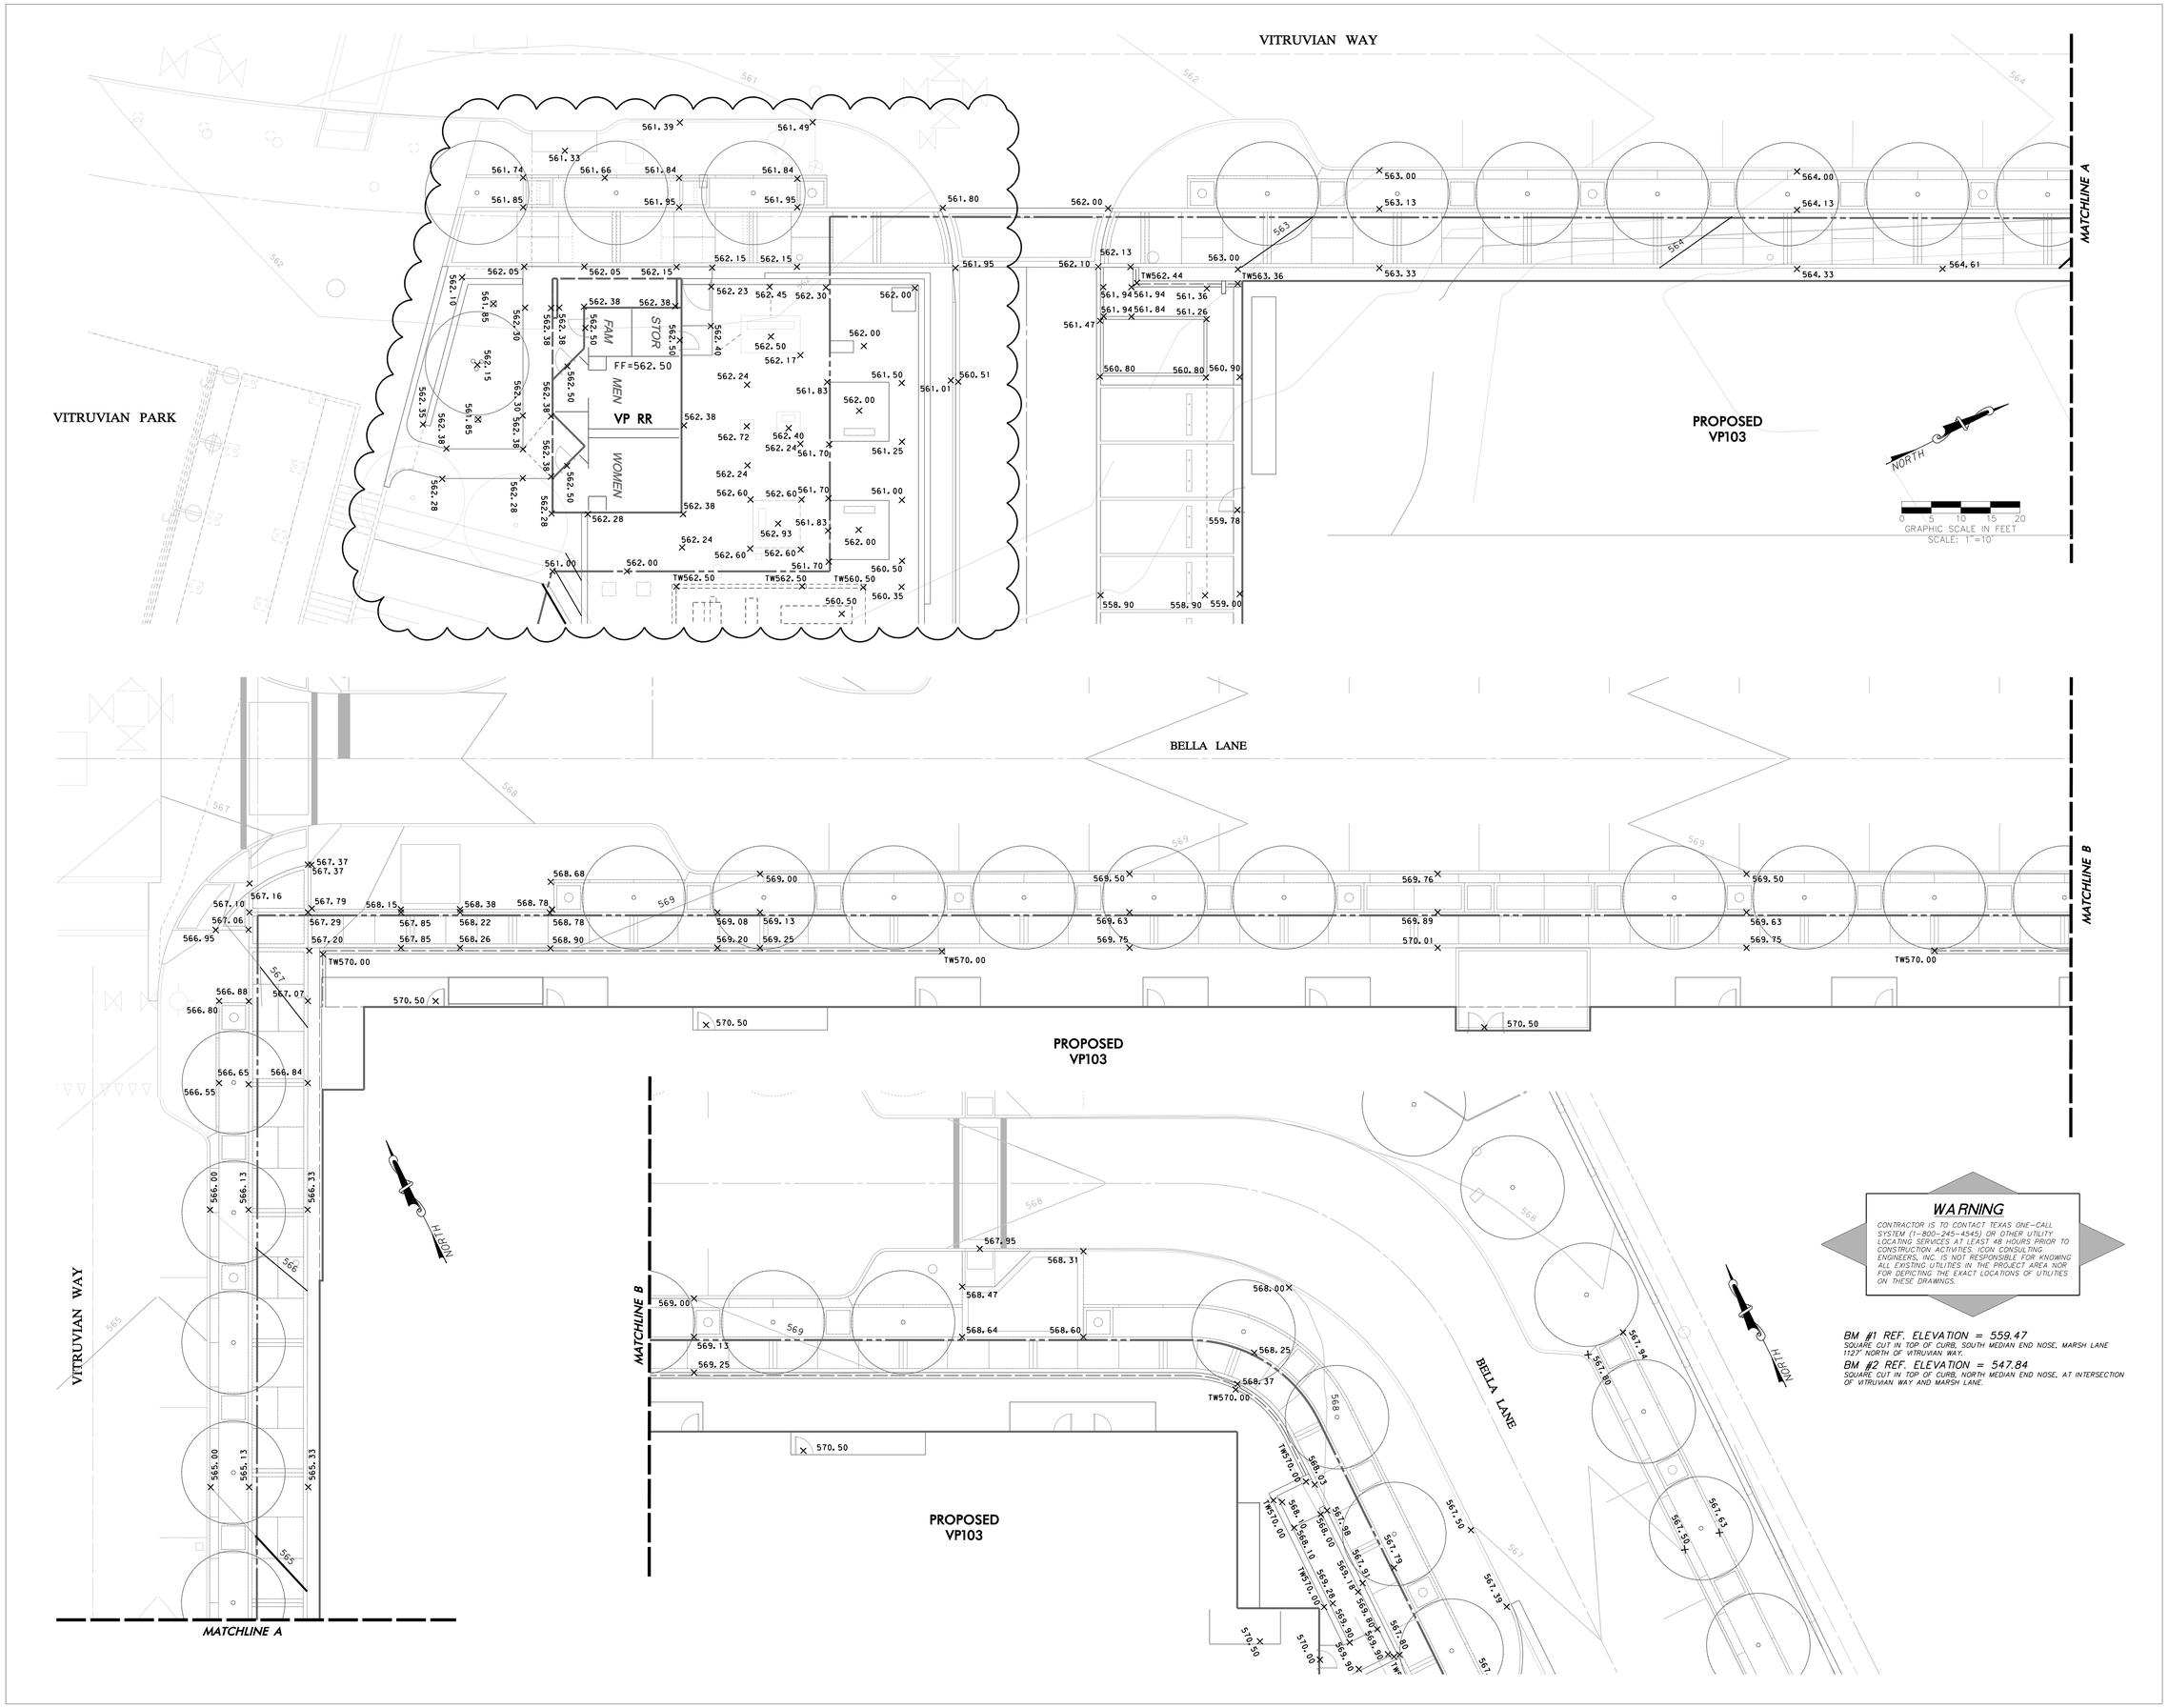

WARNING

CONTRACTOR IS TO CONTACT TEXAS ONE-CALL SYSTEM (1-800-245-4545) OR OTHER UTILITY LOCATING SERVICES AT LEAST 48 HOURS PRIOR TO CONSTRUCTION ACTIVITIES. ICON CONSULTING ENGINEERS, INC. IS NOT RESPONSIBLE FOR KNOWING ALL EXISTING UTILITIES IN THE PROJECT AREA NOR FOR DEPICTING THE EXACT LOCATIONS OF UTILITIES ON THESE DRAWINGS.

BM #1 REF. ELEVATION = 559.47
SQUARE CUT IN TOP OF CURB, SOUTH MEDIAN END NOSE, MARSH LANE 1127' NORTH OF VITRUVIAN WAY.

BM #2 REF. ELEVATION = 547.84
SQUARE CUT IN TOP OF CURB, NORTH MEDIAN END NOSE, AT INTERSECTION OF VITRUVIAN WAY AND MARSH LANE.

Good Fulton & Farrell Architects
2808 Fairmount Street
Suite 300
Dallas, Texas 75201
214.303.1500/Tel
214.303.1512/Fax
www.gff.com

icon
Consulting Engineers, Inc.
Civil Engineers - Designers - Planners
Bicentennial Financial Center
250 W. Southlake Blvd., Suite 117
Southlake, Tx 76092
Phone: (817) 552-6210
Fax: (817) 552-3126

UDR

VITRUVIAN PARK RESTROOM
VITRUVIAN WAY
ADDISON, TX 75001

No.	Date	Item

REVISIONS

ICE
Drawn
JAM
Checked
BFD
Approved

STATE OF TEXAS
BRUCE F. DUNNE
62654
LICENSED
PROFESSIONAL ENGINEER

STREETSCAPE GRADING PLAN

Project No.	10061.10
Date	06.28.12
Last Revision	

C3.02