

EX BUILDING

END & PLUG  
2" WTR (DOMESTIC)  
5' FROM BUILDING  
(REF MEP FOR CONT)

INSTALL:  
1-2" 45° BEND


INSTALL:  
1-2" 90° BEND

2" WATER  
(DOMESTIC)

PROPOSED  
GENERATOR

INSTALL:  
1-1/2" DOMESTIC METER & METER  
BOX PER CITY OF ADDISON  
STANDARDS. WATER METER BOX  
TO BE LOCATED NO CLOSER THAN  
4' FROM EX FIRE HYDRANT

INSTALL:  
1-2" TAPPING SADDLE  
ON EXIST 8" WATER LINE

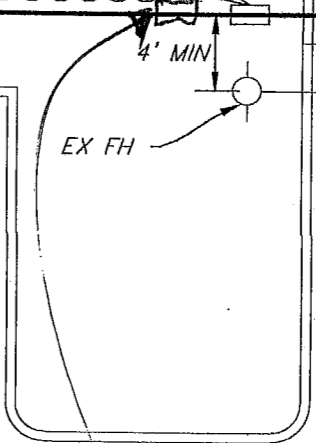

Backflow  
Preventer -  
Appropriate to  
Potential Degree of Hazard.  
Contact Phil Kayaric or  
Robert Trevino, Addison Utilities  
RZLW 9/24/13