


SHEET INDEX

- C0-0 SHEET INDEX
- C0-1 EXISTING CONDITIONS PLAN
- C0-2 EXISTING CONTOURS
- C1-1 SITE PREPARATION/DEMOLITION/EROSION CONTROL PLAN
- C1-2 SITE PREPARATION/DEMOLITION/EROSION CONTROL PLAN
- C1-3 SITE PREPARATION/DEMOLITION/EROSION CONTROL PLAN
- C2-1 MATERIALS PLAN
- C2-2 MATERIALS PLAN
- C2-3 LAYOUT PLAN
- C2-4 LAYOUT PLAN
- C3-1 GRADING & DRAINAGE PLAN
- C3-2 GRADING & DRAINAGE PLAN
- C4-1 UTILITIES PLAN
- C4-2 UTILITIES PLAN
- C4-3 UTILITIES PLAN
- C5-1 MATERIALS PLAN DETAIL
- C5-2 MATERIALS PLAN DETAIL
- C5-3 PAVING & LAYOUT PLAN DETAIL
- C5-4 PAVING & LAYOUT PLAN DETAIL
- C5-5 GRADING PLAN DETAIL
- C5-6 GRADING PLAN DETAIL
- C6-1 PERGOLA PLAN & DETAILS
- C6-2 PERGOLA ELEVATIONS
- C7-1 SITE DETAILS
- C7-2 SITE DETAILS
- C7-3 SITE DETAILS - LIGHTING
- C7-4 SITE DETAILS - COTTON BELT ROUTE
- C7-5 SITE DETAILS - FENCES
- C7-6 SITE DETAILS - UPPER CHANNEL & RAILING
- C7-7 SITE DETAILS - FOUNTAIN WALL
- C7-8 SITE DETAILS - PLAZA FOUNTAIN STEPS
- C7-9 SITE DETAILS - FOUNTAIN PYLON
- C7-10 SITE DETAILS - FOUNTAIN
- C7-11 SITE DETAILS - STAIRS
- C7-12 SITE DETAILS - STAIRS
- C7-13 SITE DETAILS - STAIRS
- △ C7-14 SITE DETAILS - ELECTRICAL ROOM
- C8-1 FESTIVAL WAY PROFILES
- C8-2 SEWER PROFILE
- C8-3 SITE DETAILS - ROADWAY PAVING
- C8-4 SITE DETAILS - WATER
- C8-5 SITE DETAILS - WATER
- C8-6 SITE DETAILS - SANITARY SEWER
- C8-7 SITE DETAILS - DRAINAGE
- C8-8 SITE DETAILS - DRAINAGE
- C8-9 LAYOUT COORDINATE SYSTEM REFERENCE
- S1-1 STRUCTURAL DETAILS
- S1-2 STRUCTURAL DETAILS
- S1-3 STRUCTURAL DETAILS
- S1-4 ELECTRICAL ROOM STRUCTURAL DETAILS
- L1-1 PLANTING PLAN
- L1-2 PLANTING PLAN
- L2-1 PLANTING DETAILS AND PLANT LIST
- L3-1 IRRIGATION PLAN
- △ L3-2 IRRIGATION PLAN
- L5-1 IRRIGATION DETAILS & LEGEND
- E0-0 ELECTRICAL ABBREVIATIONS & SYMBOL LEGEND
- E1-1 ELECTRICAL PLAN - WEST
- E1-2 ELECTRICAL PLAN - EAST
- E2-1 SINGLE LINE DIAGRAMS AND DETAILS
- E2-2 ELECTRICAL LARGE SCALE PLANS
- E3-1 ELECTRICAL PANELBOARD SCHEDULES
- M1-1 MECHANICAL PLAN
- F0-0 FOUNTAIN LEGEND AND ABBREVIATIONS
- F1-1 WATER GARDEN DISCHARGE, FILL & FILTER RETURN PLAN
- F1-2 WATER GARDEN SUCTION AND DRAIN PLAN
- F1-3 WATER GARDEN ELECTRICAL PLAN
- F1-4 WATER GARDEN FOUNTAIN DETAILS
- F2-1 PLAZA FOUNTAIN DISCHARGE, FILL & FILTER RETURN PLAN
- F2-2 PLAZA FOUNTAIN DRAINAGE & AIR VENT PLAN
- F2-3 PLAZA FOUNTAIN PUMP SUCTIONS PLAN
- F2-4 PLAZA FOUNTAIN ELECTRICAL PLAN
- F2-5 PLAZA FOUNTAIN FOUNTAIN DETAILS
- FE1-1 WATER GARDEN & PLAZA FOUNTAIN ELECTRICAL DIAGRAM

△	ADDENDUM #2	10-21-02
	ISSUED FOR CONSTRUCTION	09-30-02
No.	Description	Date

DWG ISSUE & REVISION HISTORY

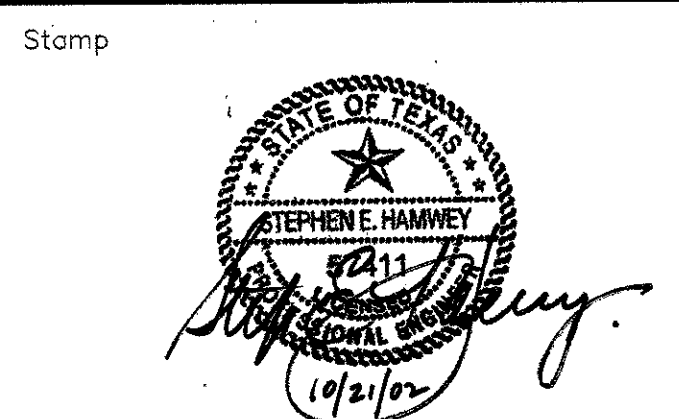

Project Title:
ADDISON ARTS & EVENTS DISTRICT
 ADDISON, TEXAS

Drawing Title:
SHEET INDEX

Project No. 14516.00 Scale:
 Drawn By:
 Checked By:
 Approved By:
 Date: September 30, 2002

Drawing No. **C0-0**