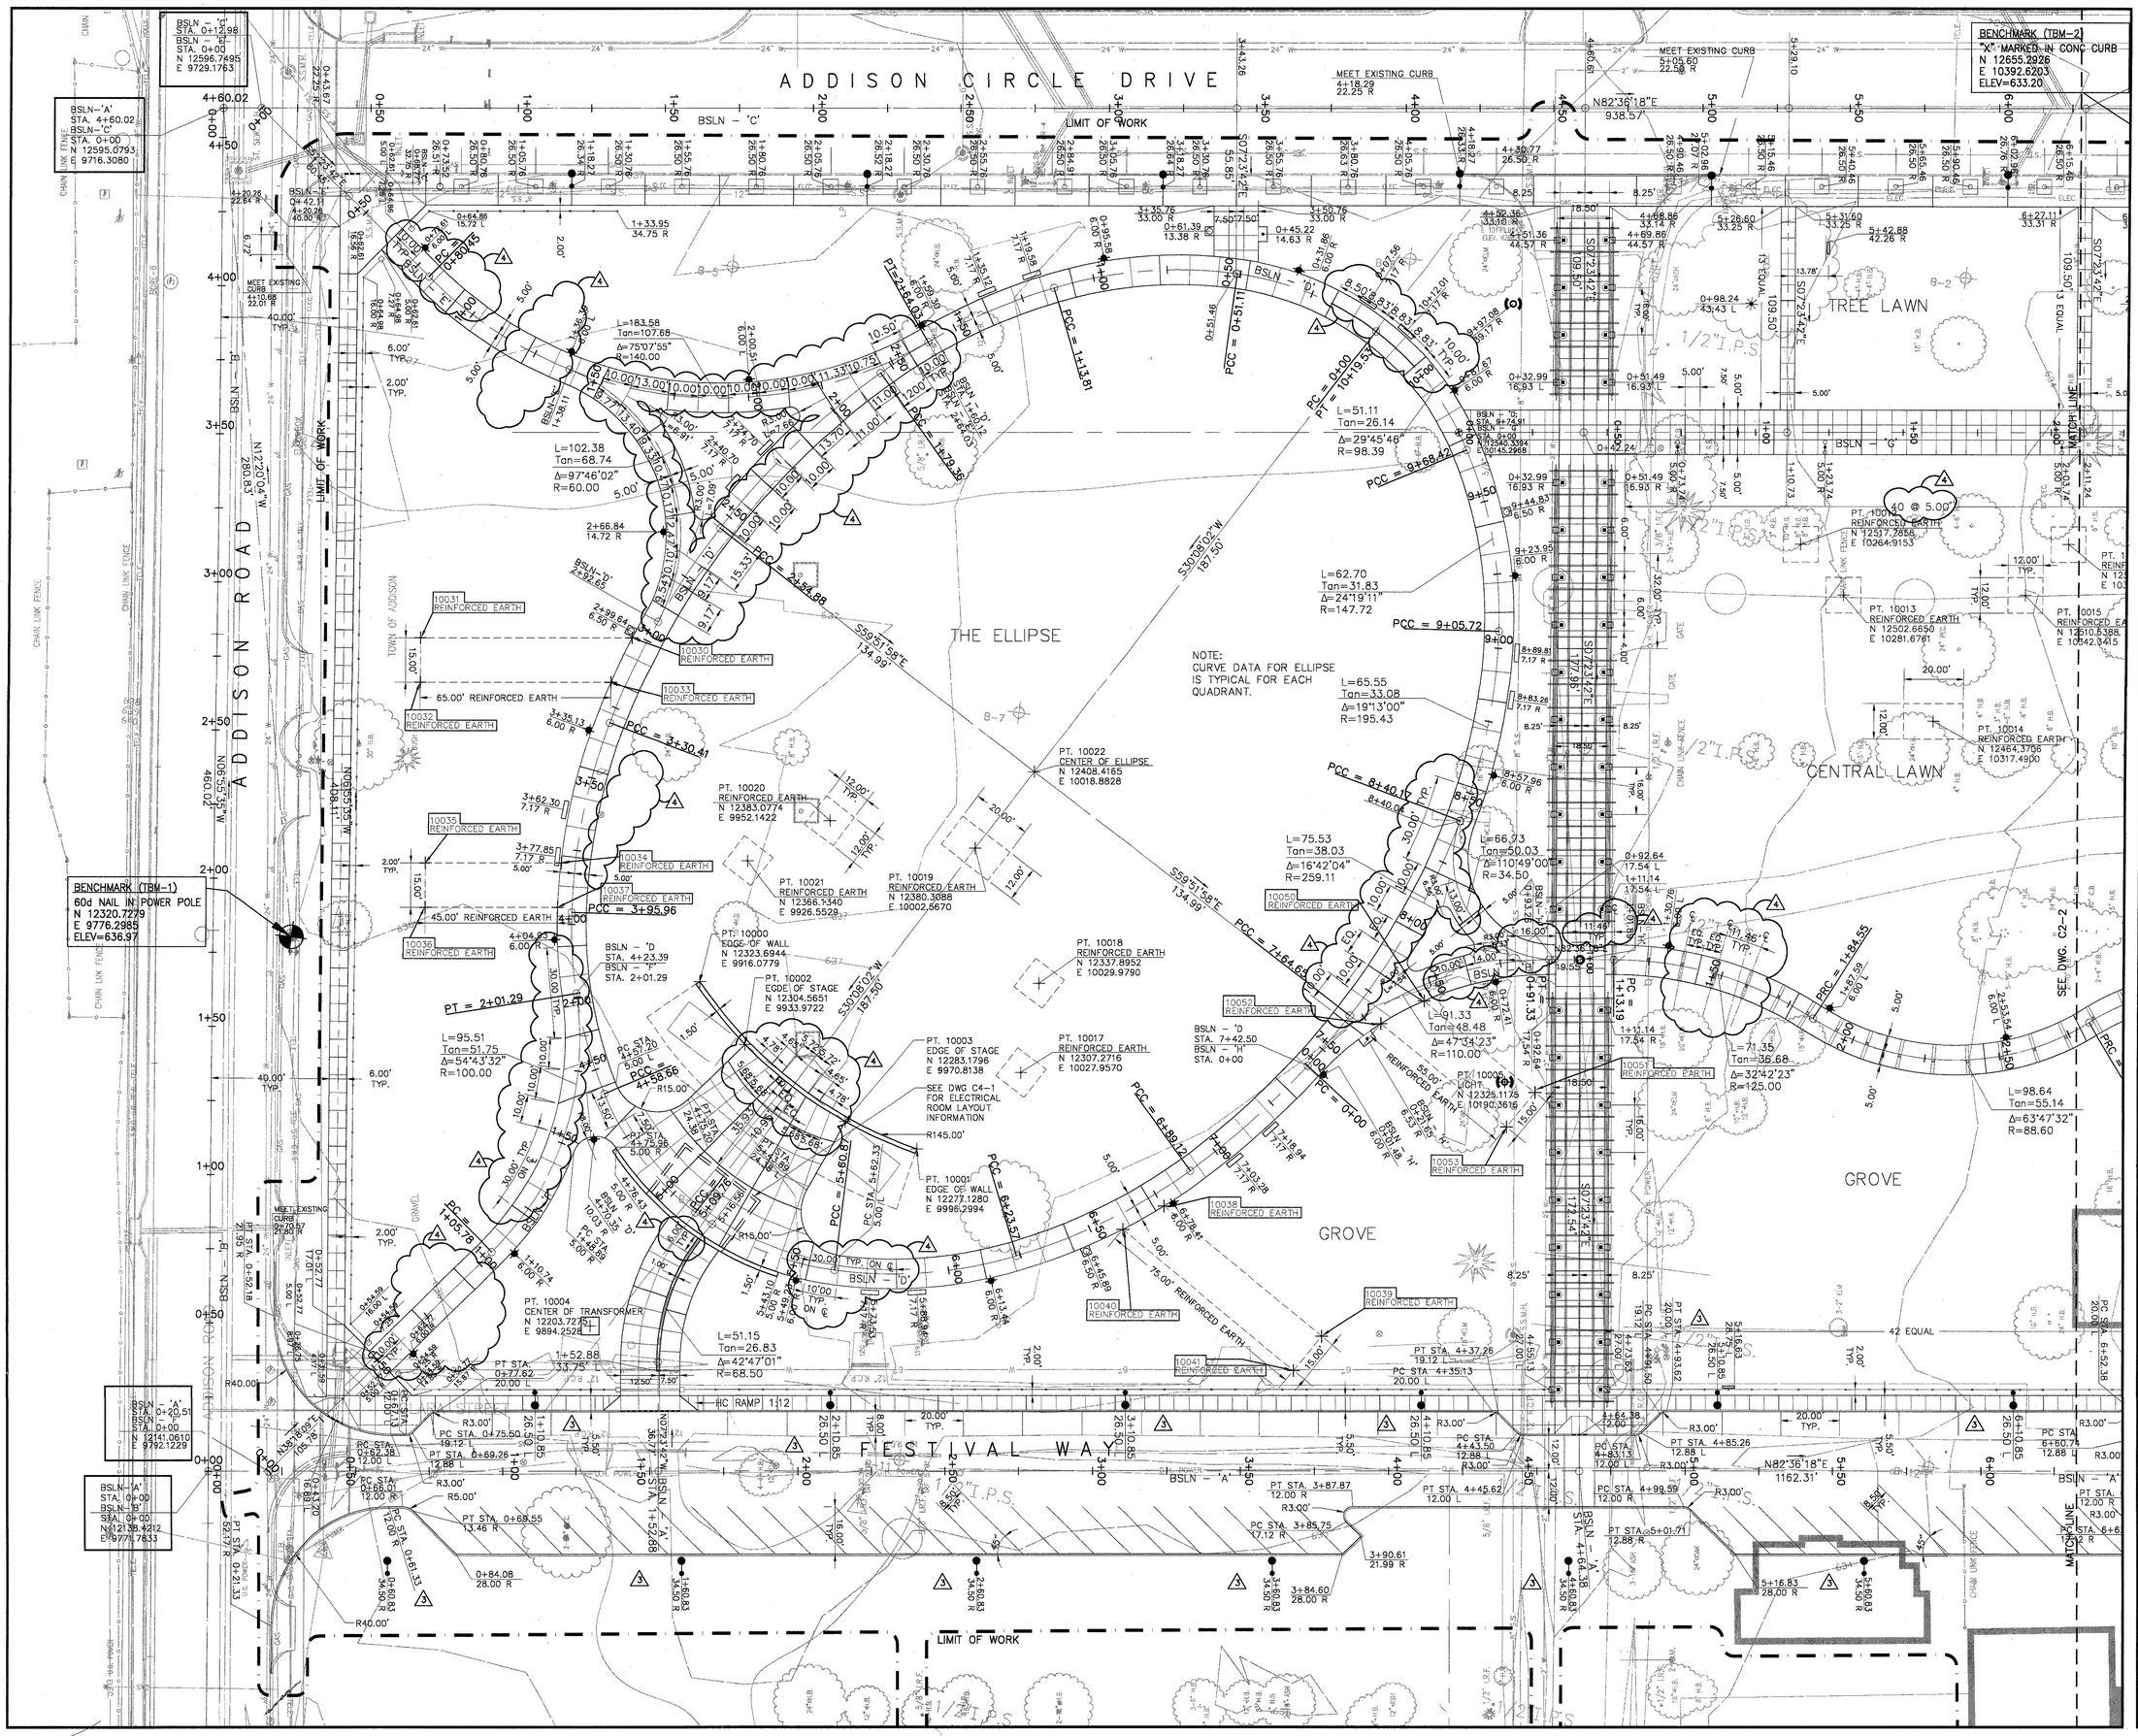

SASAKI

Interdisciplinary Design

64 Pleasant Street, Watertown, Massachusetts 02472 USA
t 617 926 3300 f 617 924 2748 w www.sasaki.com

LEGEND

- STREET LIGHT
- PEDESTRIAN POLE FIXTURE
- GARDEN LIGHT
- DOUBLE LIGHT POLE W/ BANNERS
- WATER GARDEN POLE FIXTURE
- FOUNTAIN AND FENCE PYLON
- WATER GARDEN POOL LIGHT
- WATER GARDEN CHANNEL LIGHT
- PLAZA FOUNTAIN UPLIGHT
- STEP LIGHT
- TRELLIS LIGHTING-2 PER COLUMN
- (o) 30' POLE W/(8) 1000W FIXTURES
- B7 BORING LOCATION

NOTE:
1.) STREET LIGHT LAYOUT INFORMATION IS TO CENTER OF POLE.

No.	Description	Date
4	BULLETIN #5	04-22-03
3	BULLETIN #2	03-10-03
	ISSUED FOR CONSTRUCTION	11-26-02
1	ADDENDUM #2	10-21-02
	ISSUED FOR CONSTRUCTION	09-30-02

DWG ISSUE & REVISION HISTORY

Stamp

STATE OF TEXAS
STEPHEN E. HAMMEY
57411
LICENSED
PROFESSIONAL ENGINEER

N

0 10' 20' 40'

Project Title:

ADDISON ARTS & EVENTS DISTRICT

ADDISON, TEXAS

Drawing Title:

LAYOUT PLAN

Project No. 14516.00 Scale: 1"=20'-0"
Drawn By: CB
Checked By: DC
Approved By: SEH
Date: September 30, 2002

Drawing No. C2-3