


LEGEND

- ⊙ DRAINAGE MANHOLE
- ⊙ STORM DRAIN MANHOLE
- ⊙ CATCH BASIN
- ⊙ AREA DRAIN
- ⊙ CURB INLET
- D — STORM DRAIN PIPE
- UD — SOLID UNDERDRAIN PIPE (4" PVC)
- UD — PERFORATED UNDERDRAIN PIPE (4" PVC)
- 635 — PROPOSED CONTOUR (5)
- x635 SPOT GRADE
- HP HIGH POINT
- LP LOW POINT
- TR TOP OF RAMP
- BR BOTTOM OF RAMP
- TS TOP OF STEPS
- BS BOTTOM OF STEPS
- TC TOP OF CURB
- BC BOTTOM OF CURB
- TW TOP OF WALL
- BW BOTTOM OF WALL
- WE WATER ELEVATION
- FI FLOW LINE
- I INVERT ELEVATION
- ⊙ KIOSK UTILITY BOX
- 10000 POINT FOR COORDINATE SYSTEM

ADDISON CIRCLE DRIVE

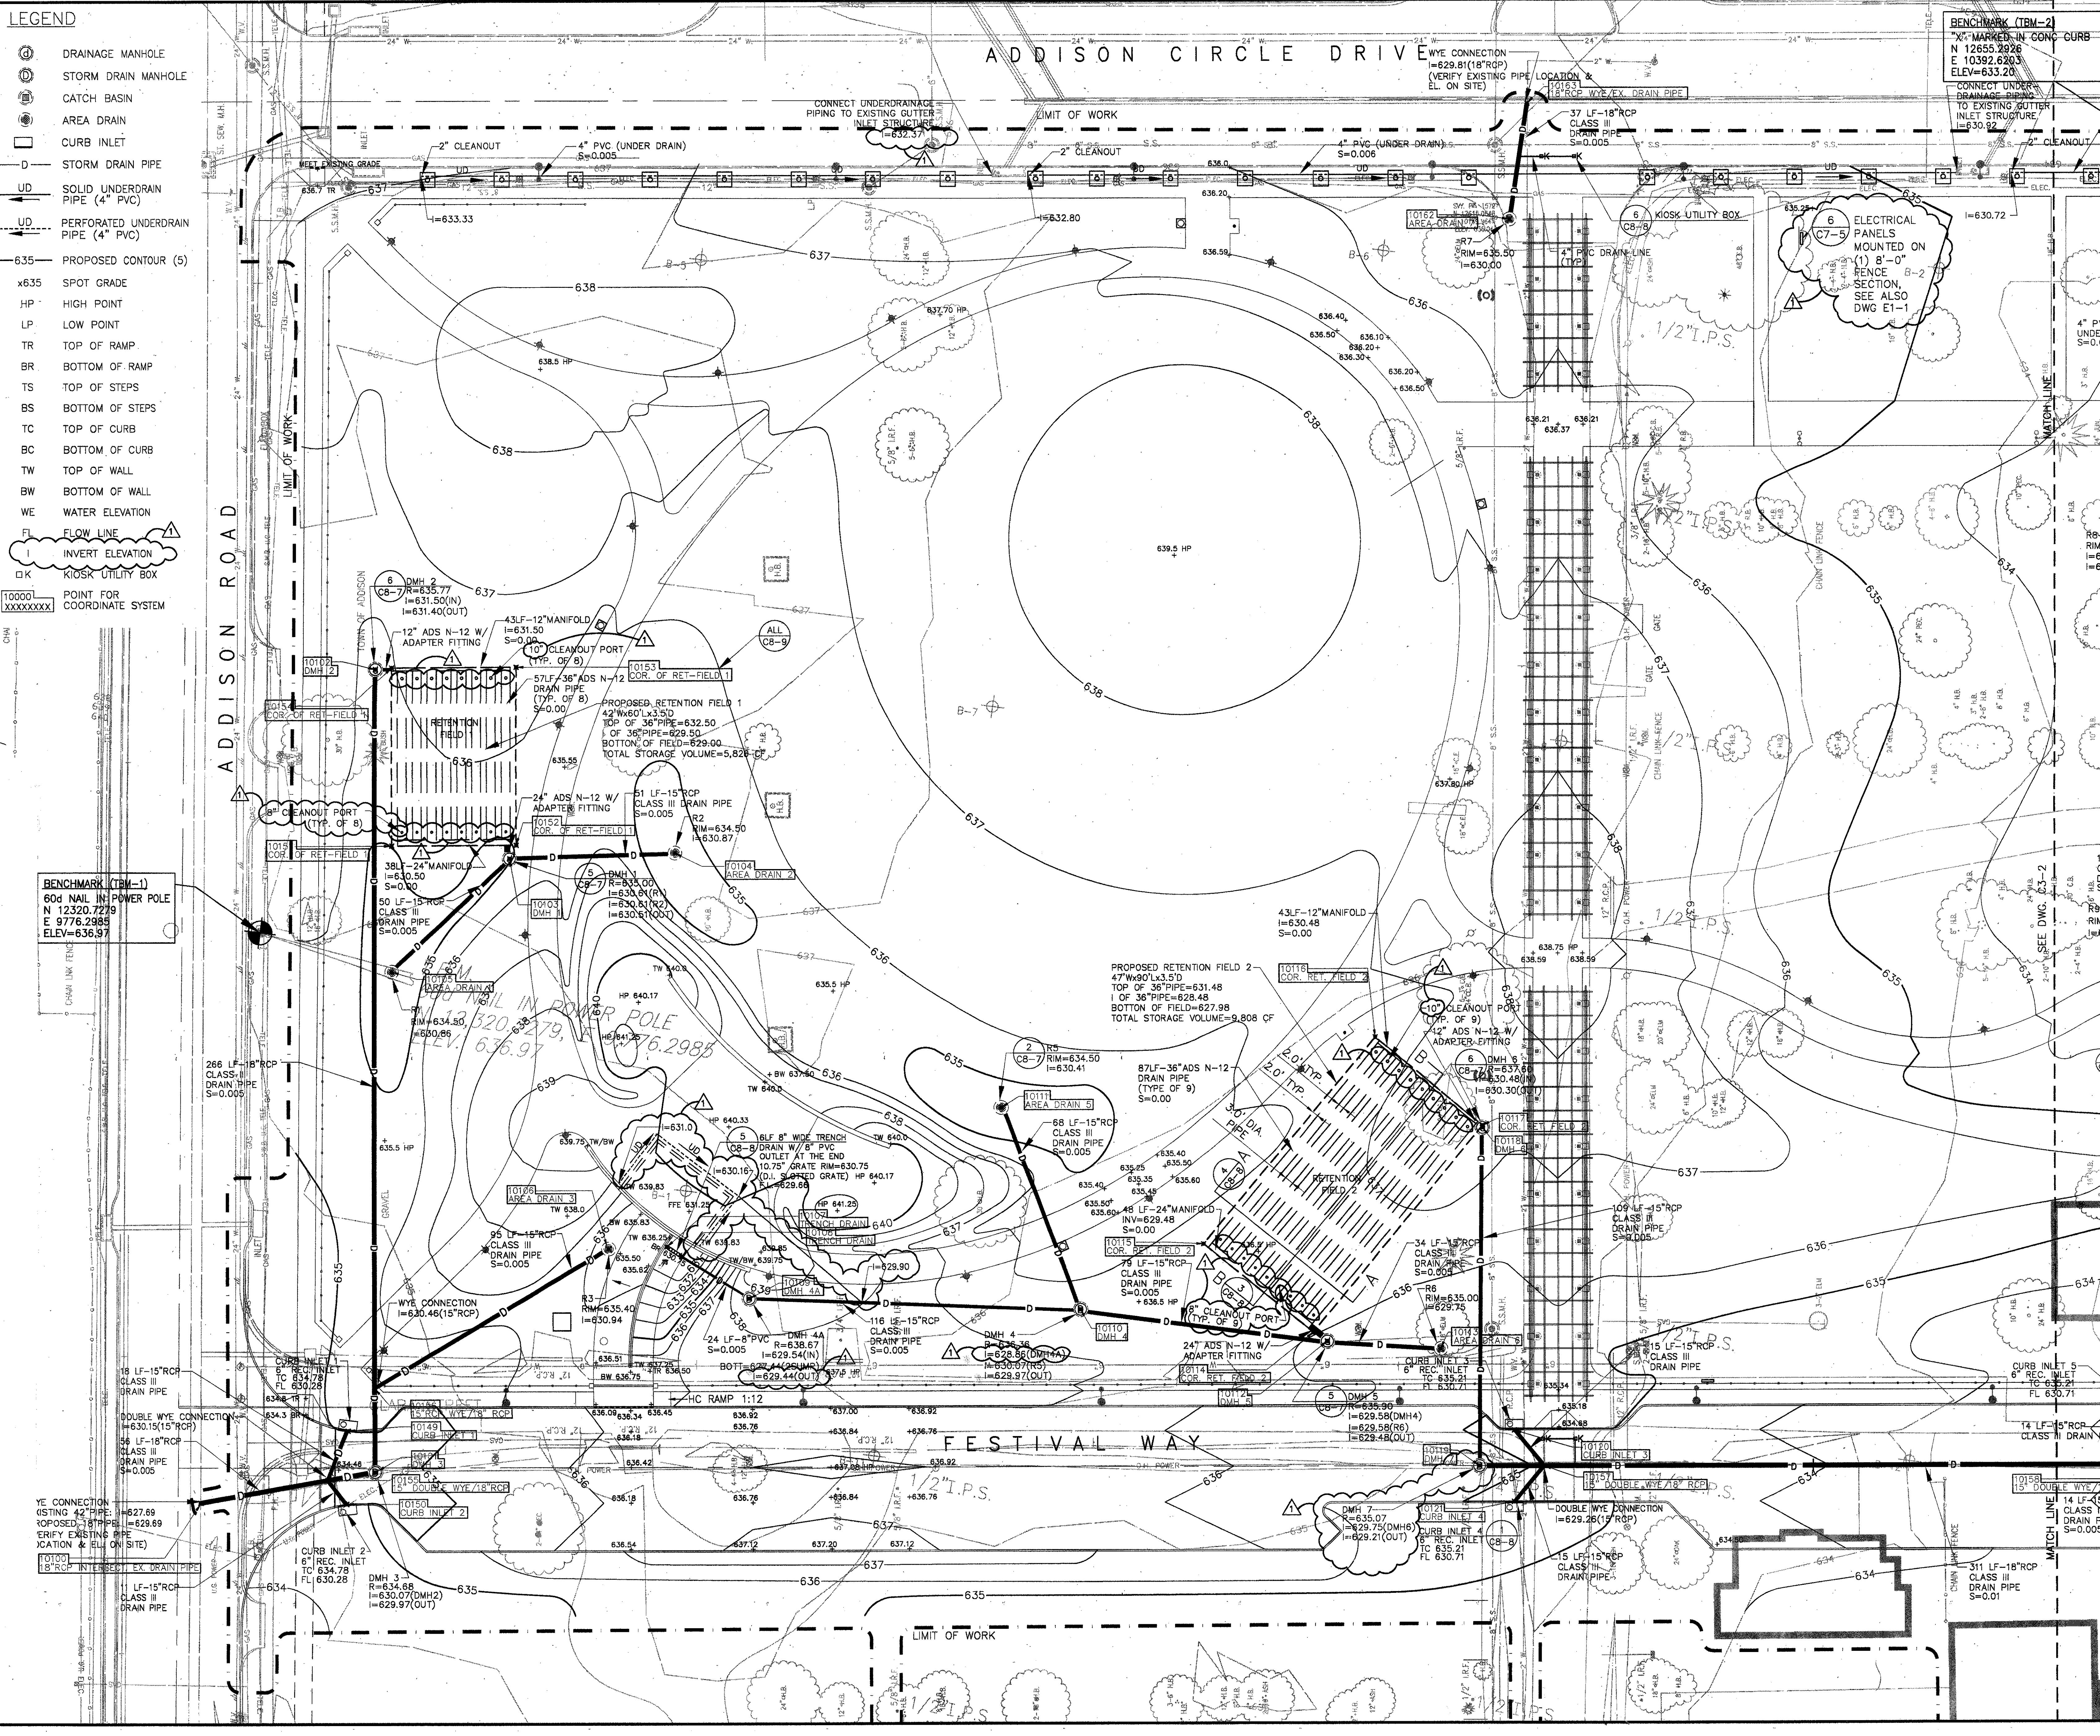

SASAKI
Interdisciplinary Design
 66 Pleasant Street, Watertown, Massachusetts 02472 USA
 F 617 926 3300 F 617 924 2745 W www.sasaki.com

ADDENDUM #2	10-21-02
ISSUED FOR CONSTRUCTION	09-30-02
No. Description	Date
DWG ISSUE & REVISION HISTORY	

Stamp

North Arrow
 0 10' 20' 40'

Project Title:
ADDISON ARTS & EVENTS DISTRICT
 ADDISON, TEXAS

Drawing Title:
GRADING & DRAINAGE PLAN

Project No. 14516.00 Scale: 1"=20'-0"
 Drawn By: SM
 Checked By: TC
 Approved By: SEH
 Date: September 30, 2002

Drawing No. **C3-1**