




8 SECTION THROUGH HANDICAP RAMP AND WALLS
 SCALE: 1/2" = 1'-0"

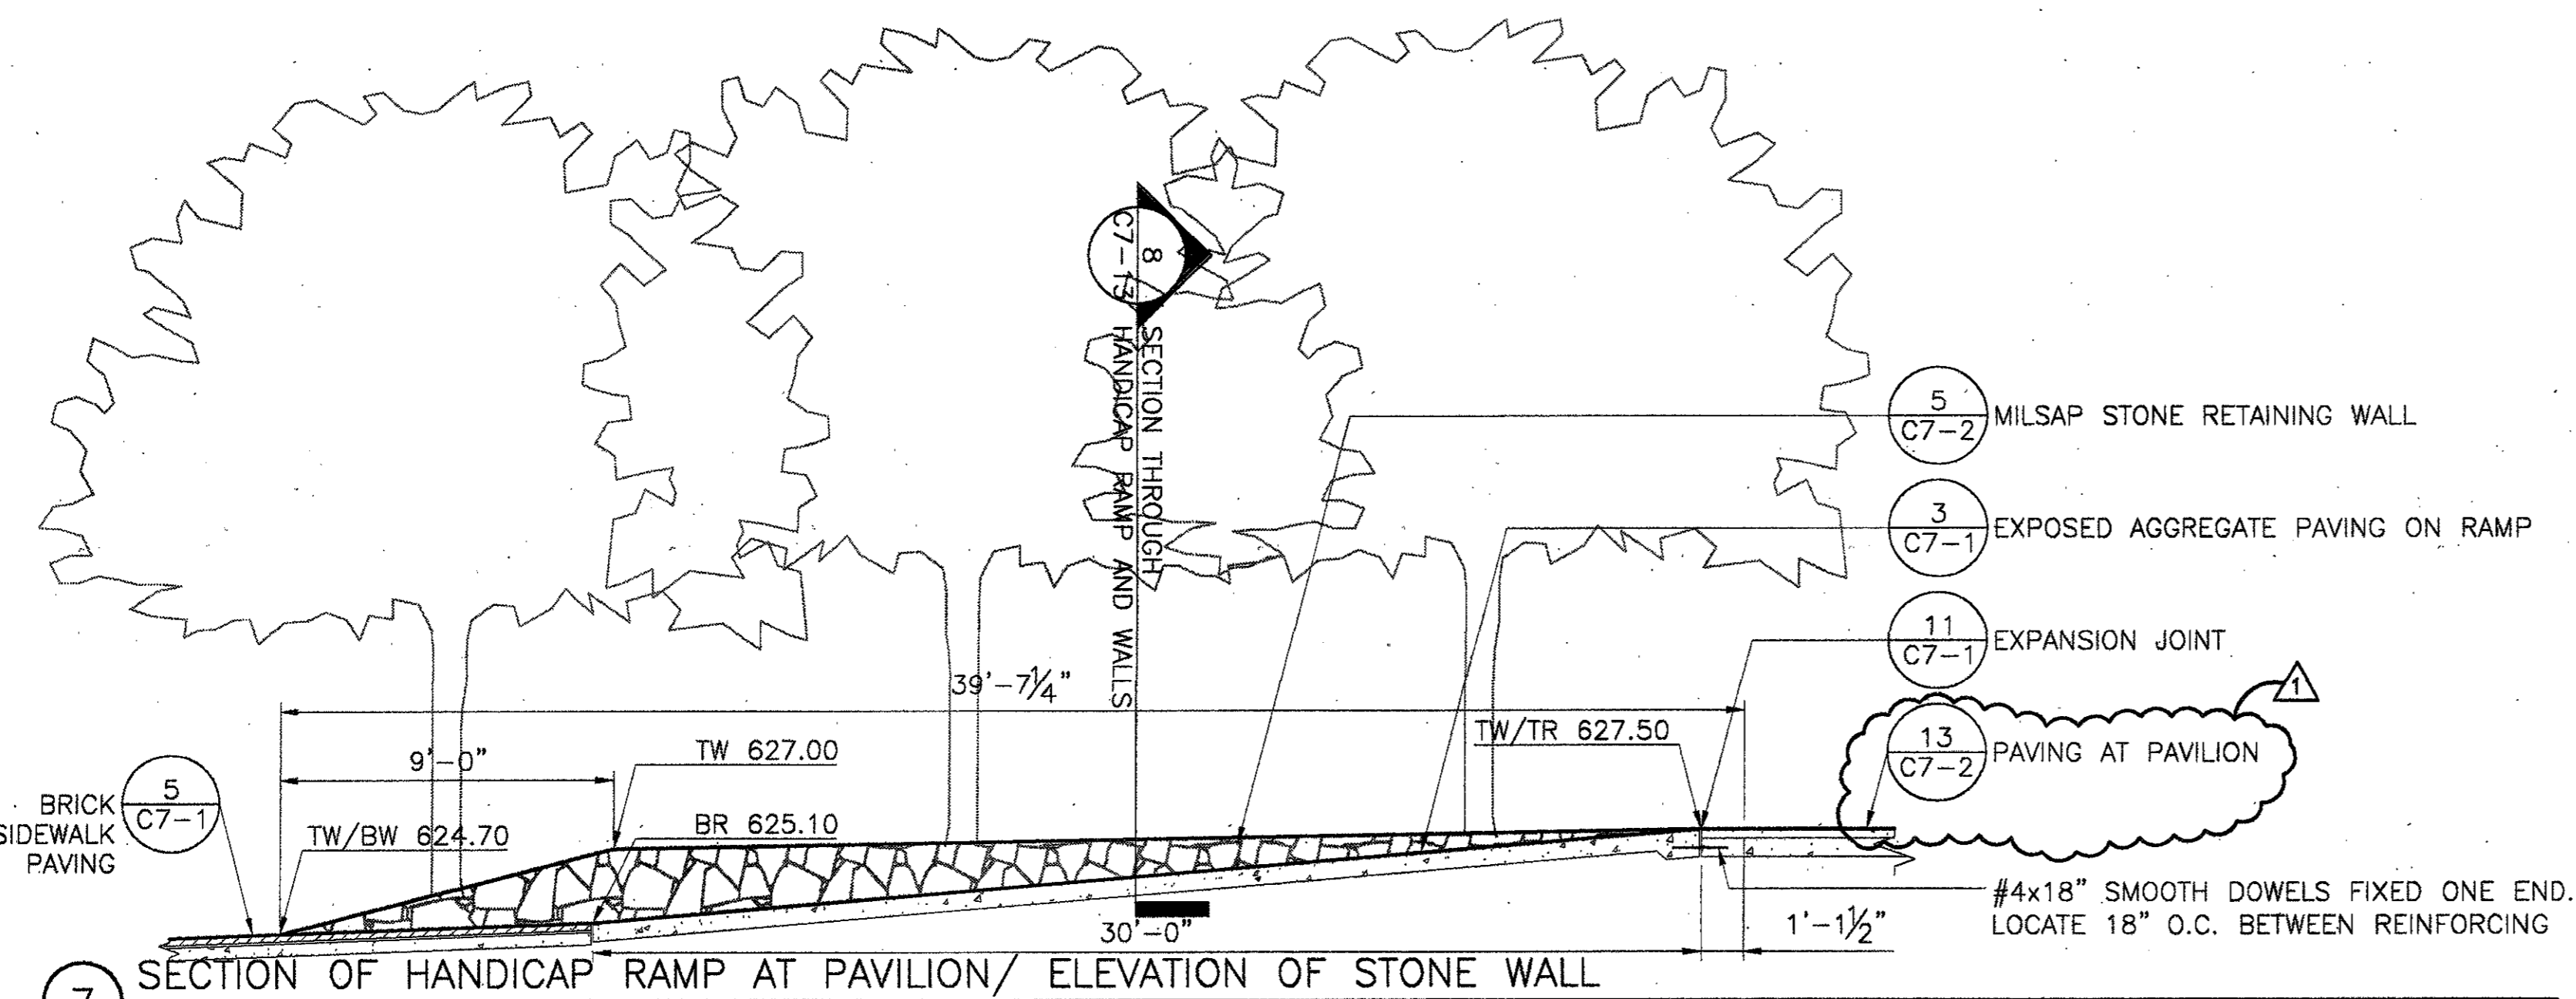


7 SECTION OF HANDICAP RAMP AT PAVILION/ ELEVATION OF STONE WALL
 SCALE: 1/4" = 1'-0"

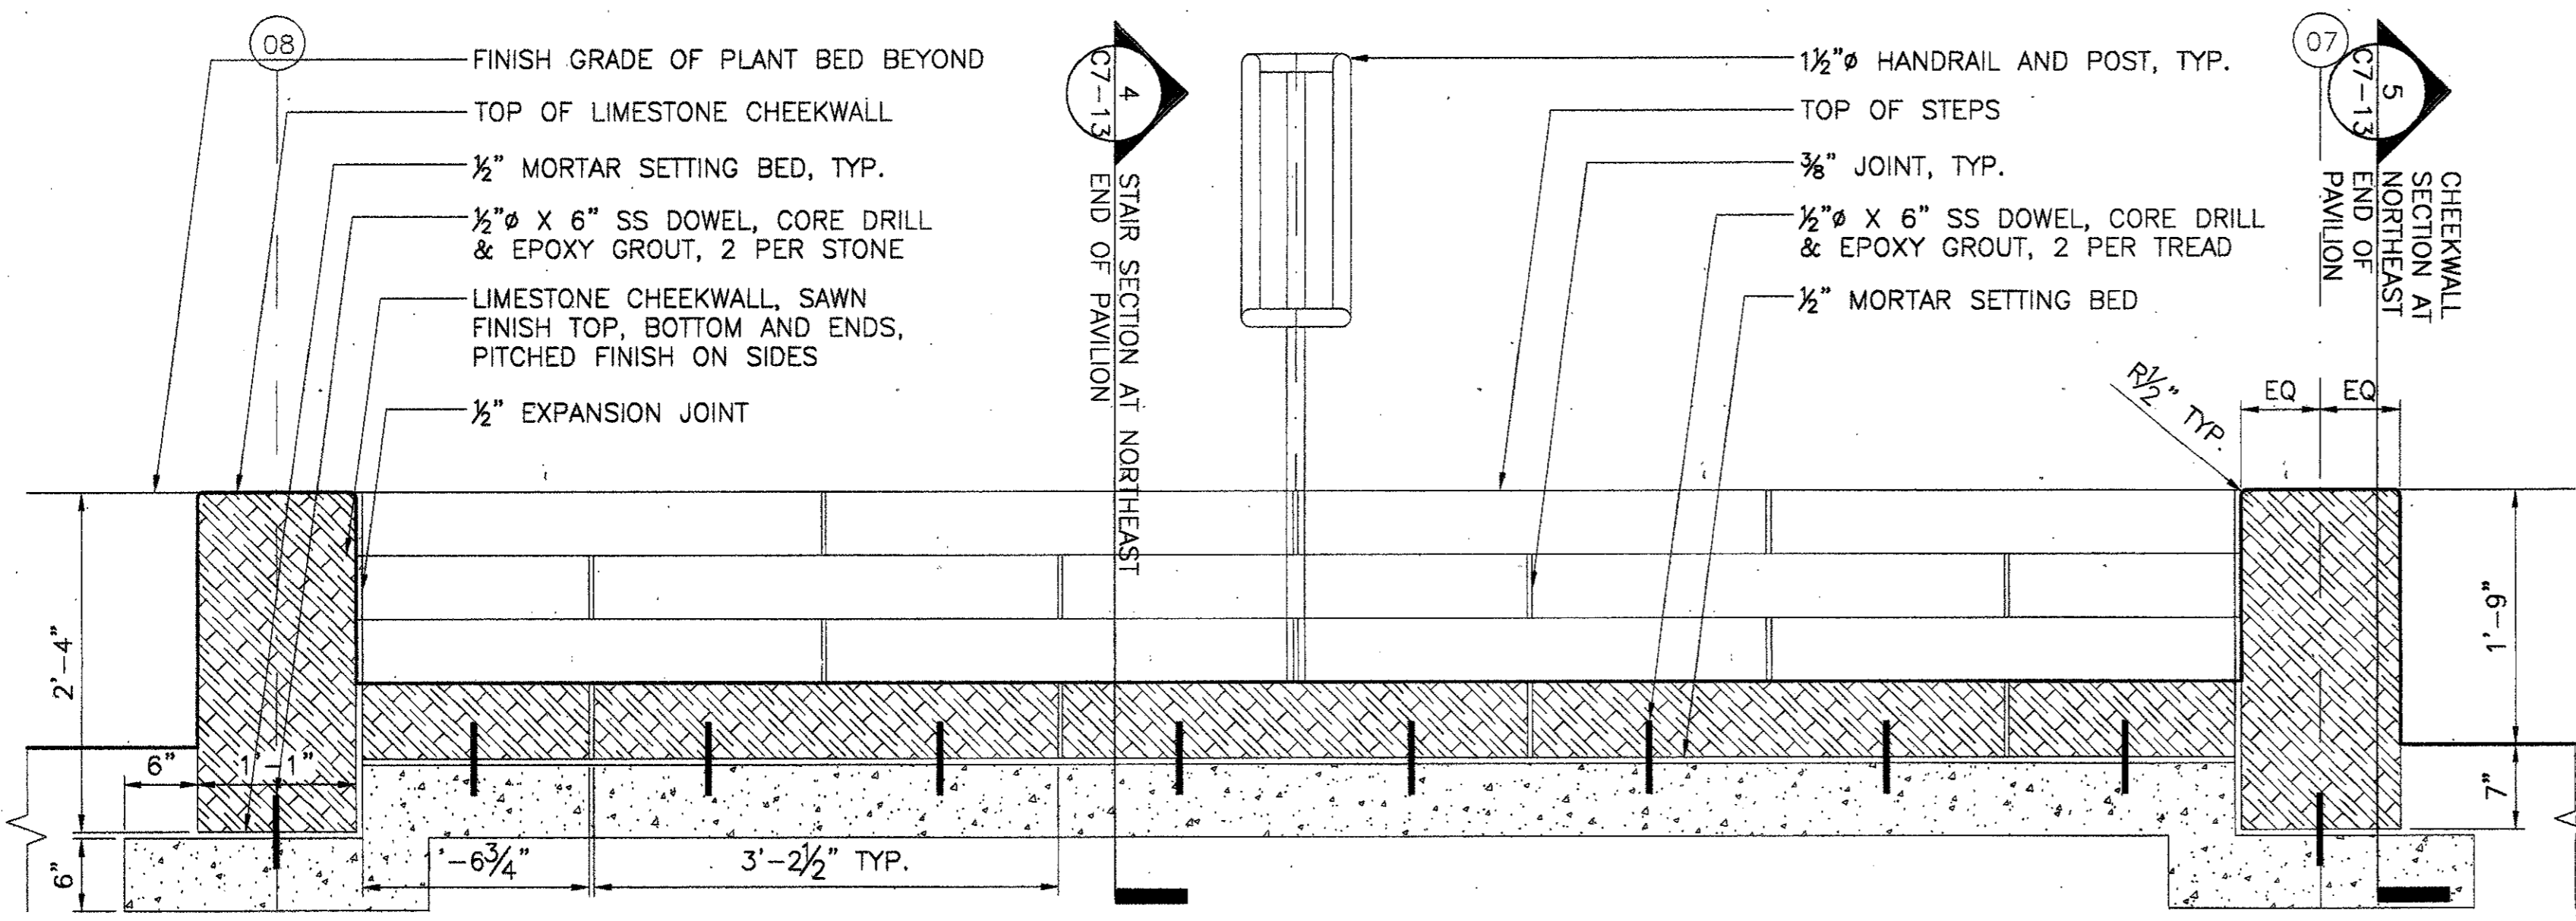


6 ELEVATION OF STAIRS AND CHEEKWALL AT NORTHEAST END OF PAVILION
 SCALE: 1" = 1'-0"

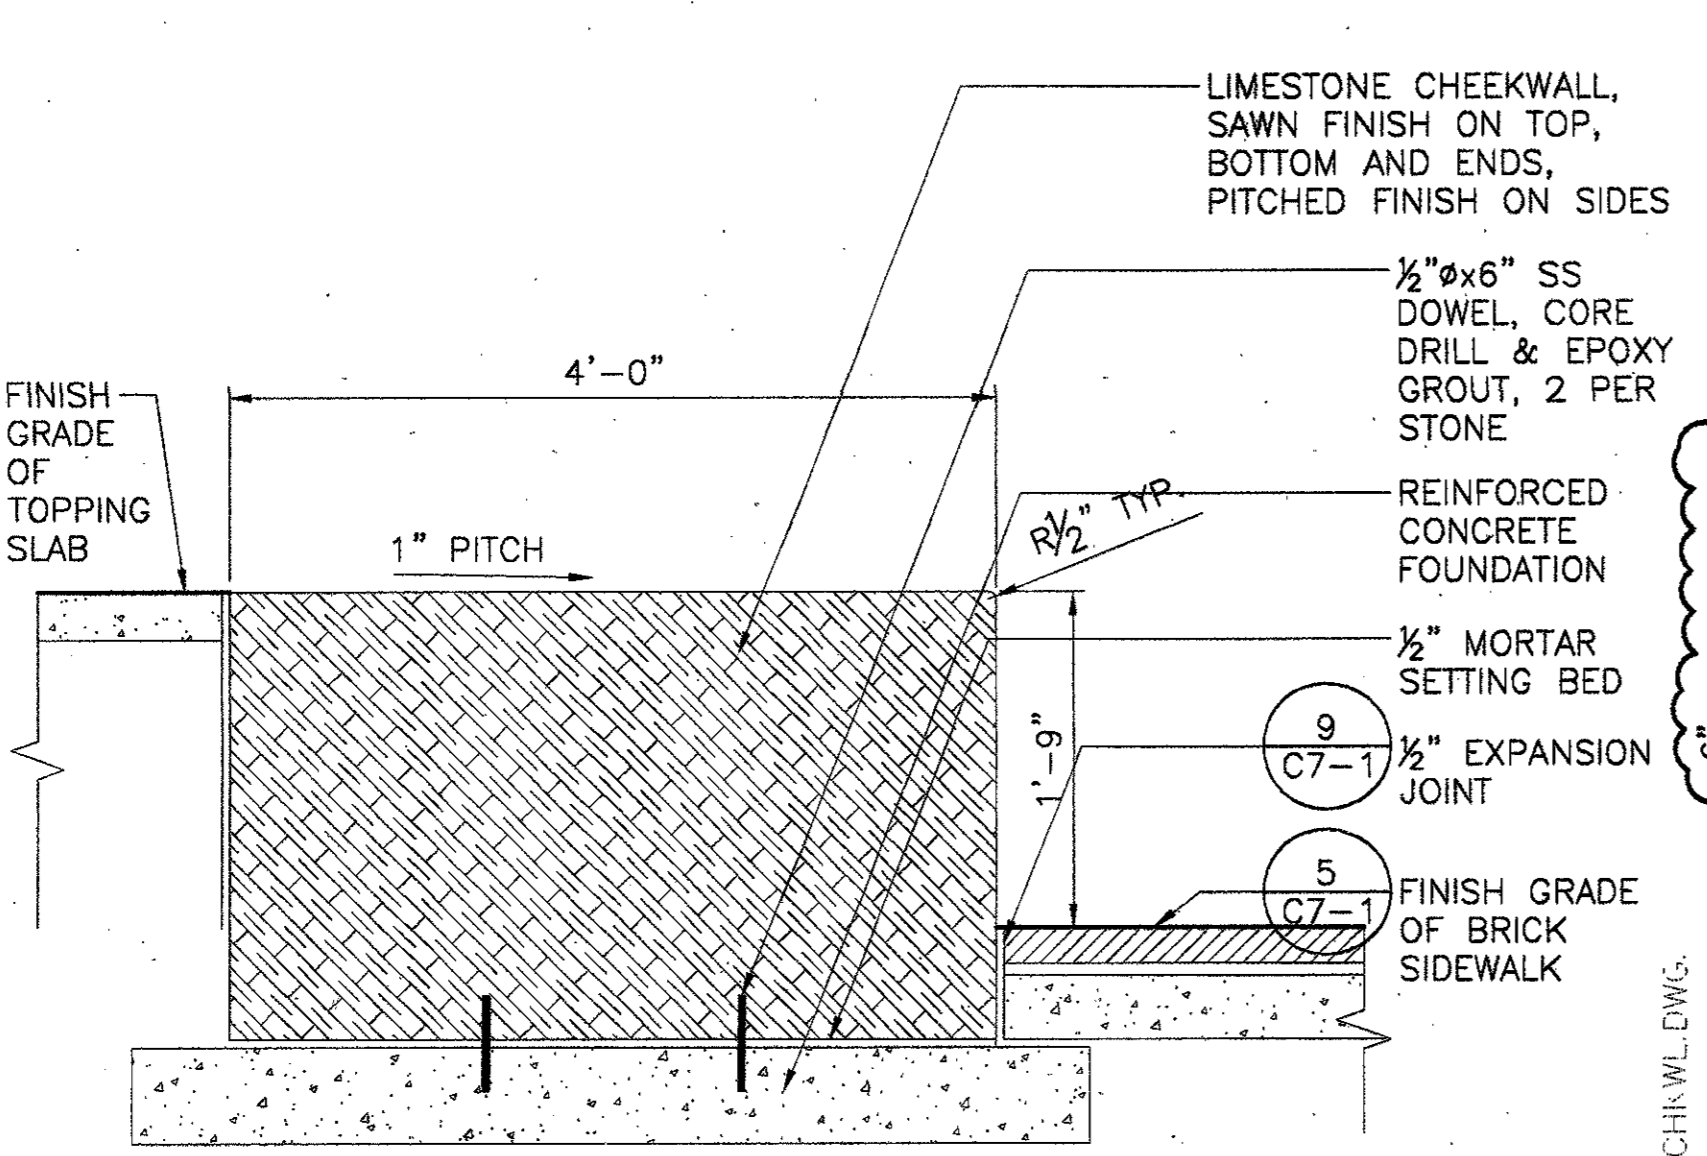


5 CHEEKWALL SECTION AT NORTHEAST END OF PAVILION
 SCALE: 1" = 1'-0"

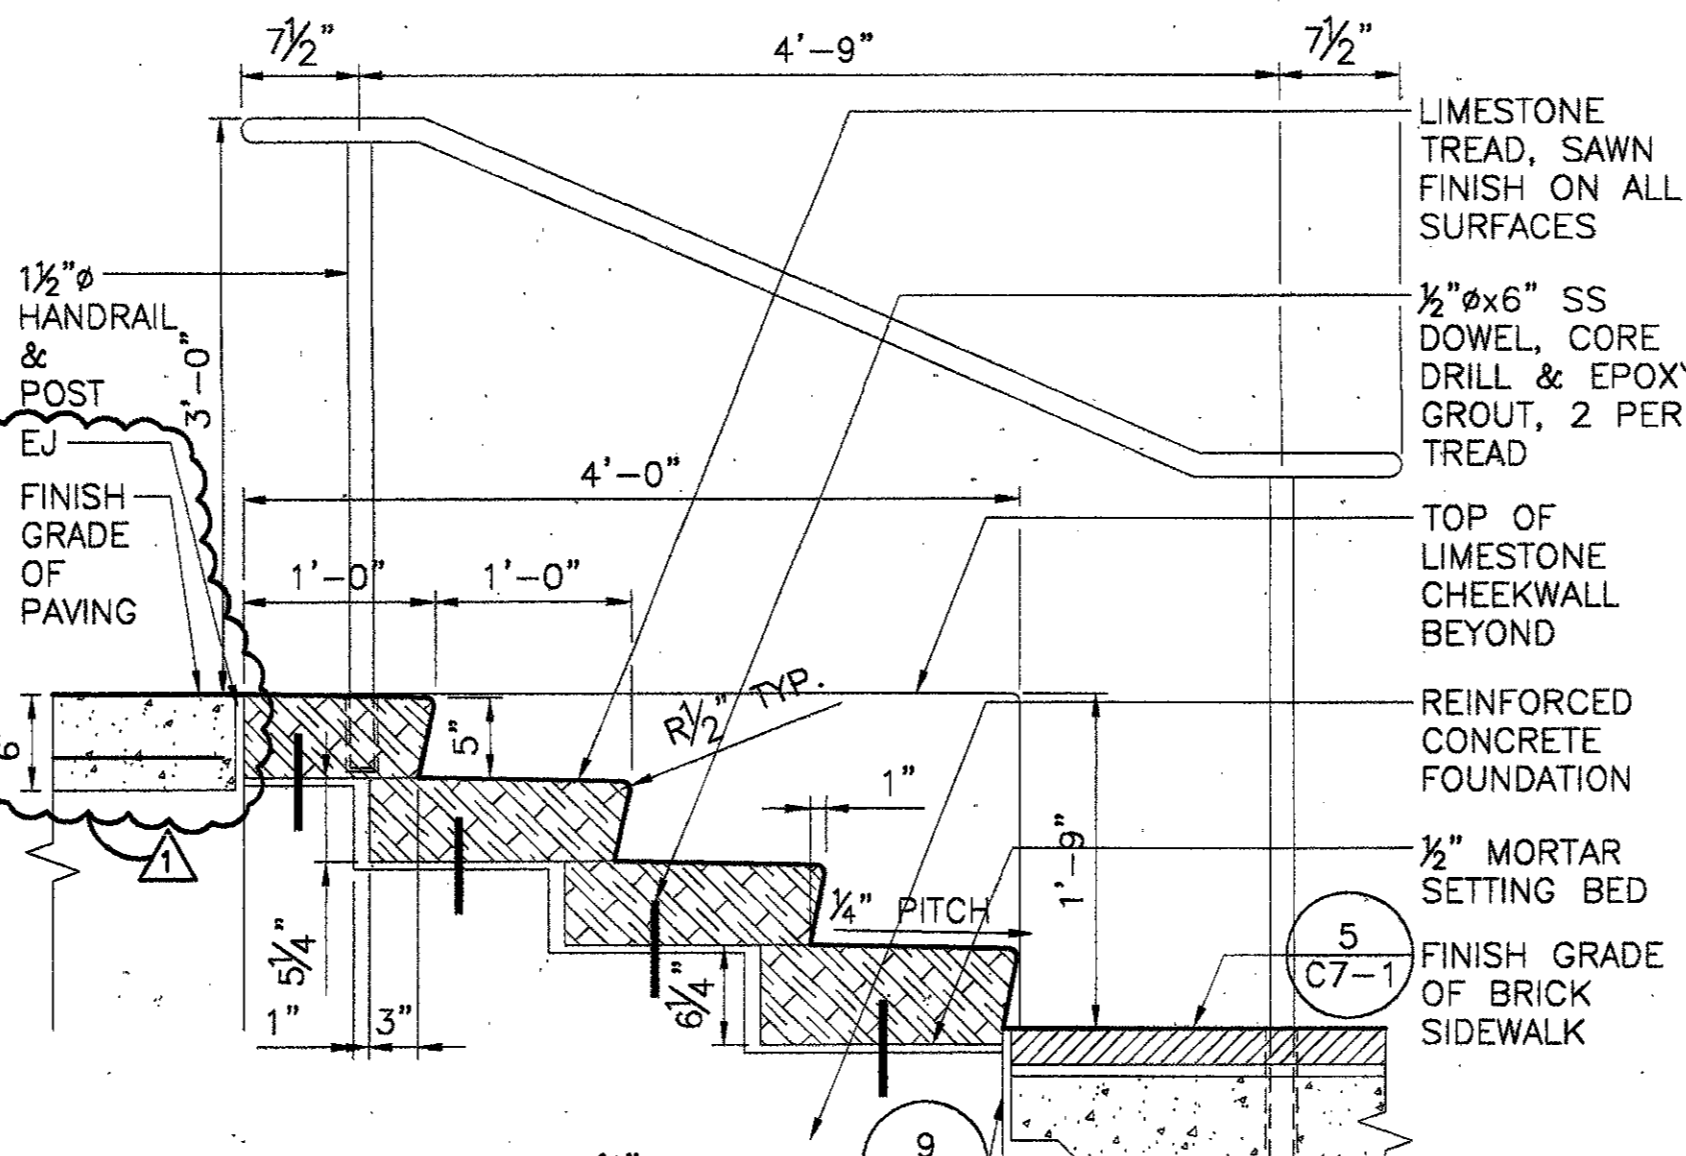


4 STAIR SECTION AT NORTHEAST END OF PAVILION
 SCALE: 1" = 1'-0"

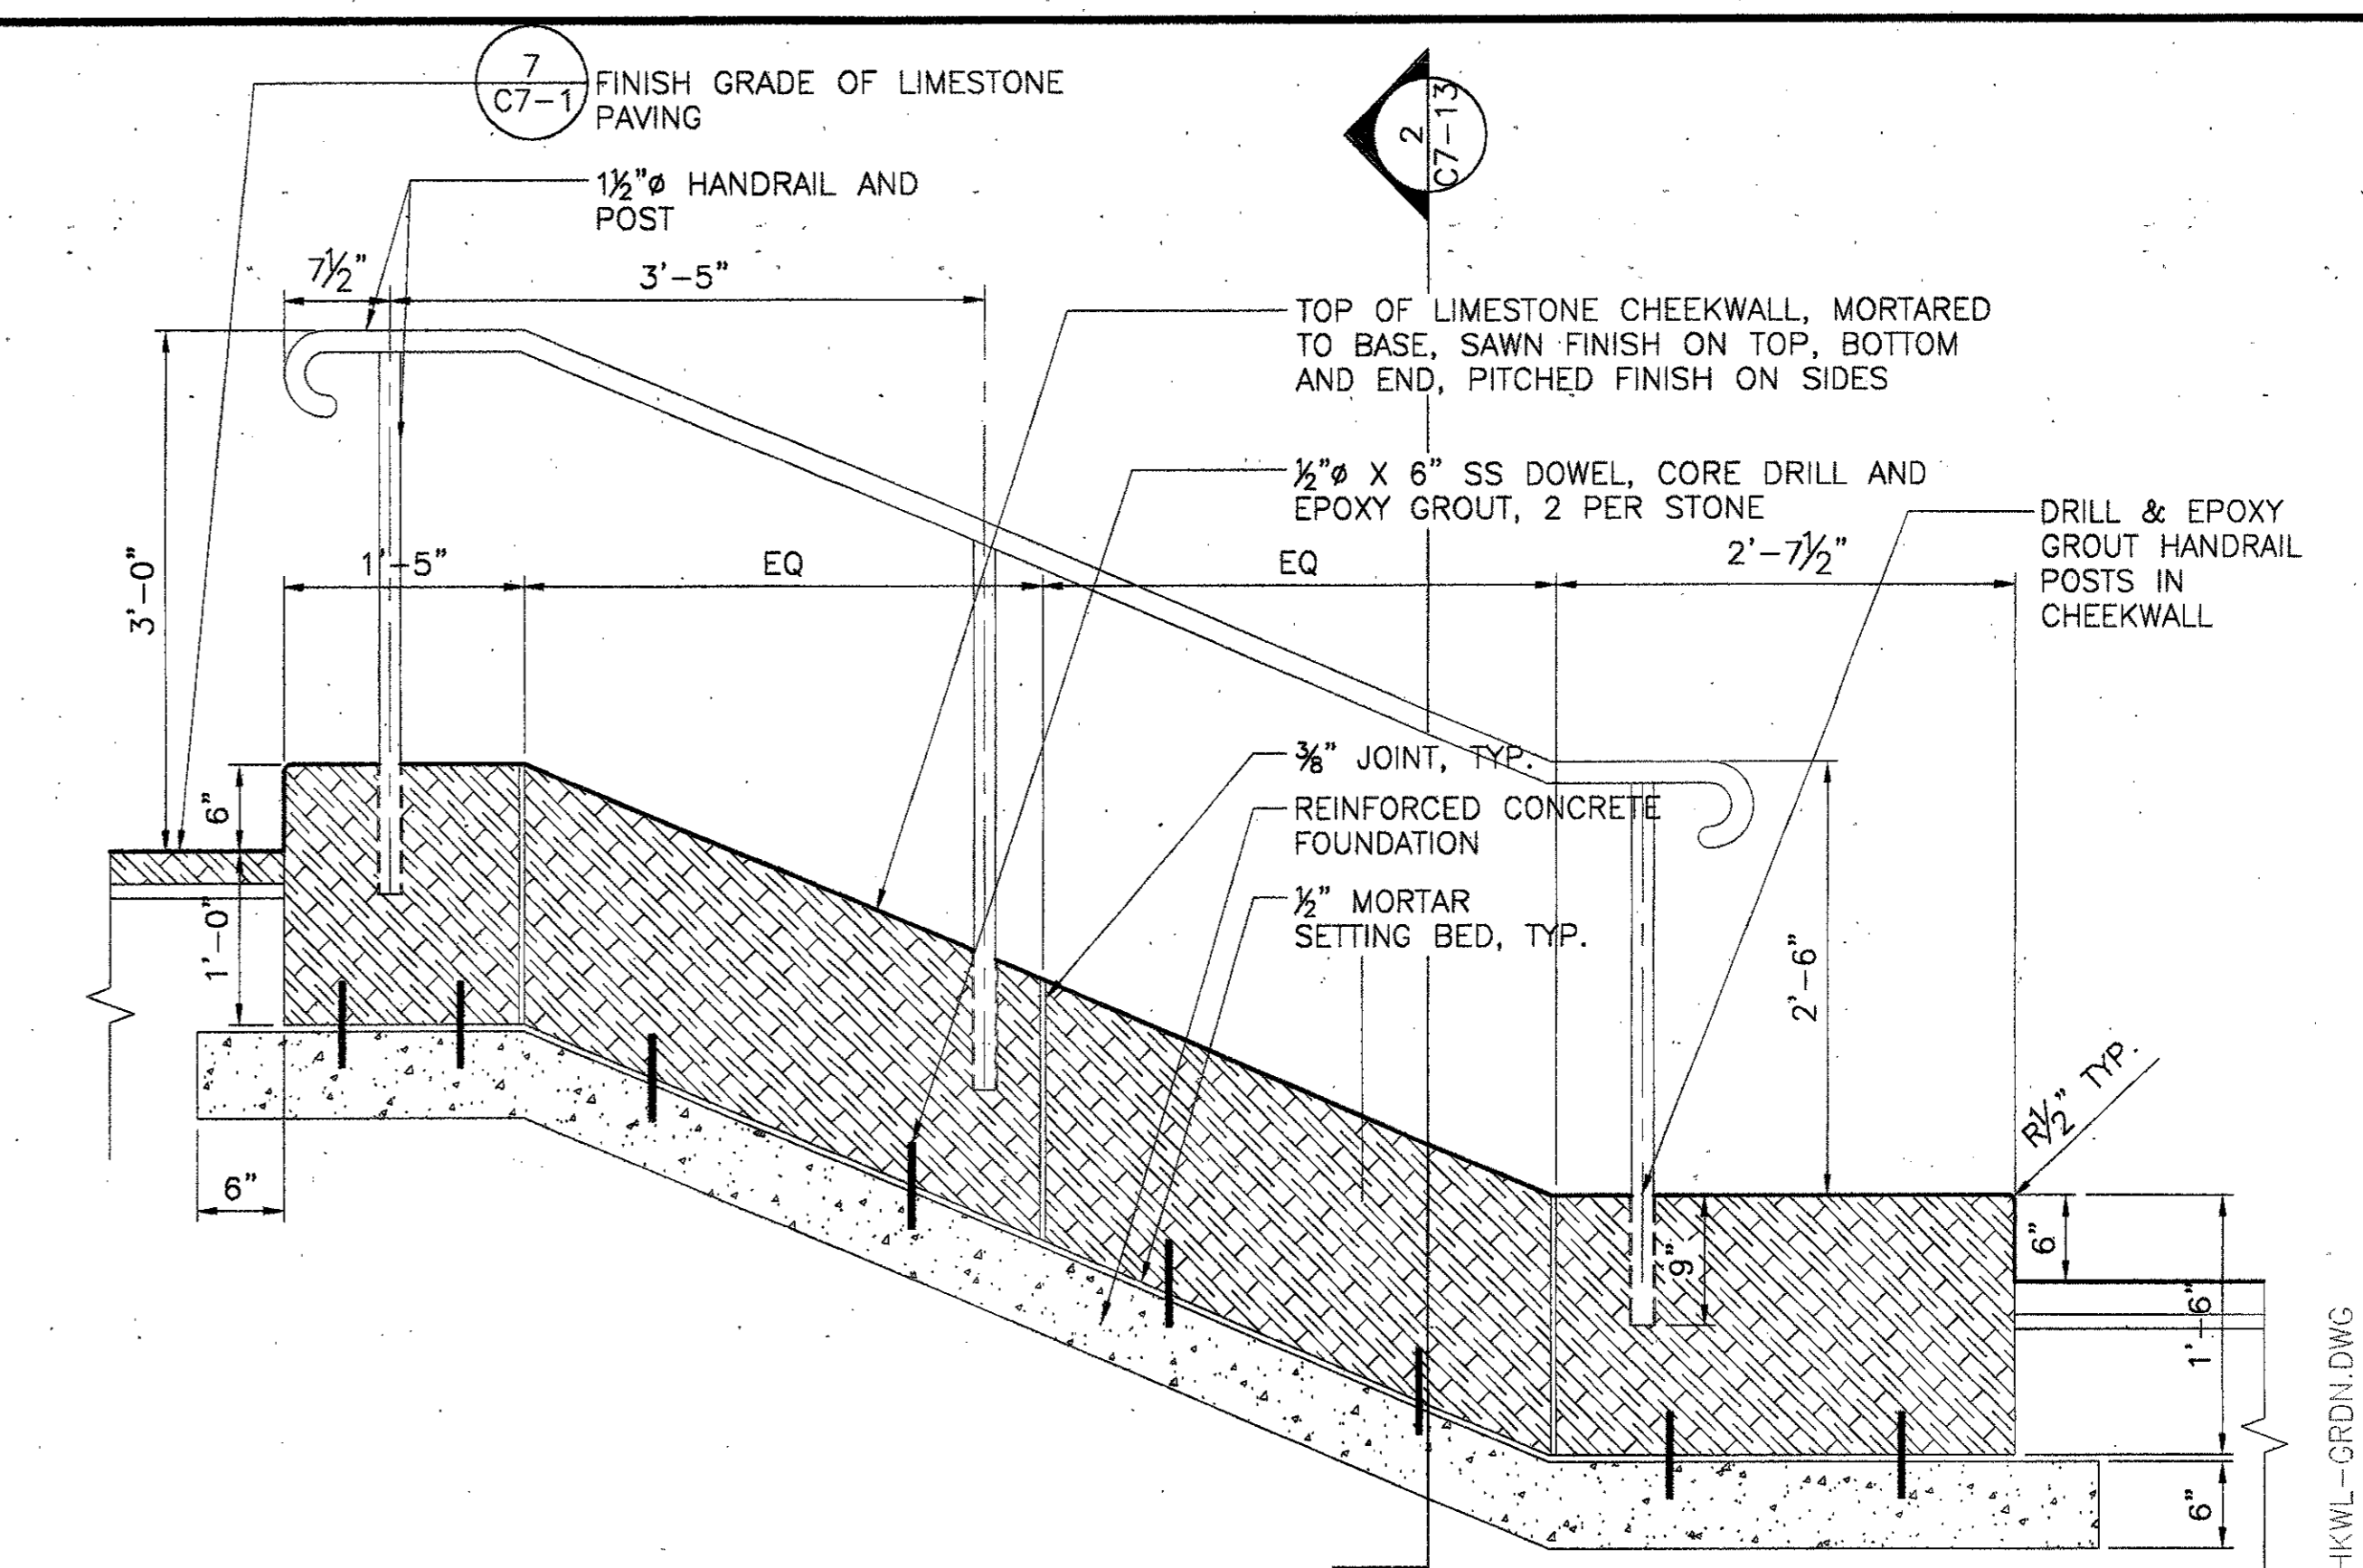

3 GARDEN STAIR: LONGITUDINAL SECTION THROUGH CHEEKWALL (TYPICAL FOR STAIRS A & B)
 SCALE: 1" = 1'-0"

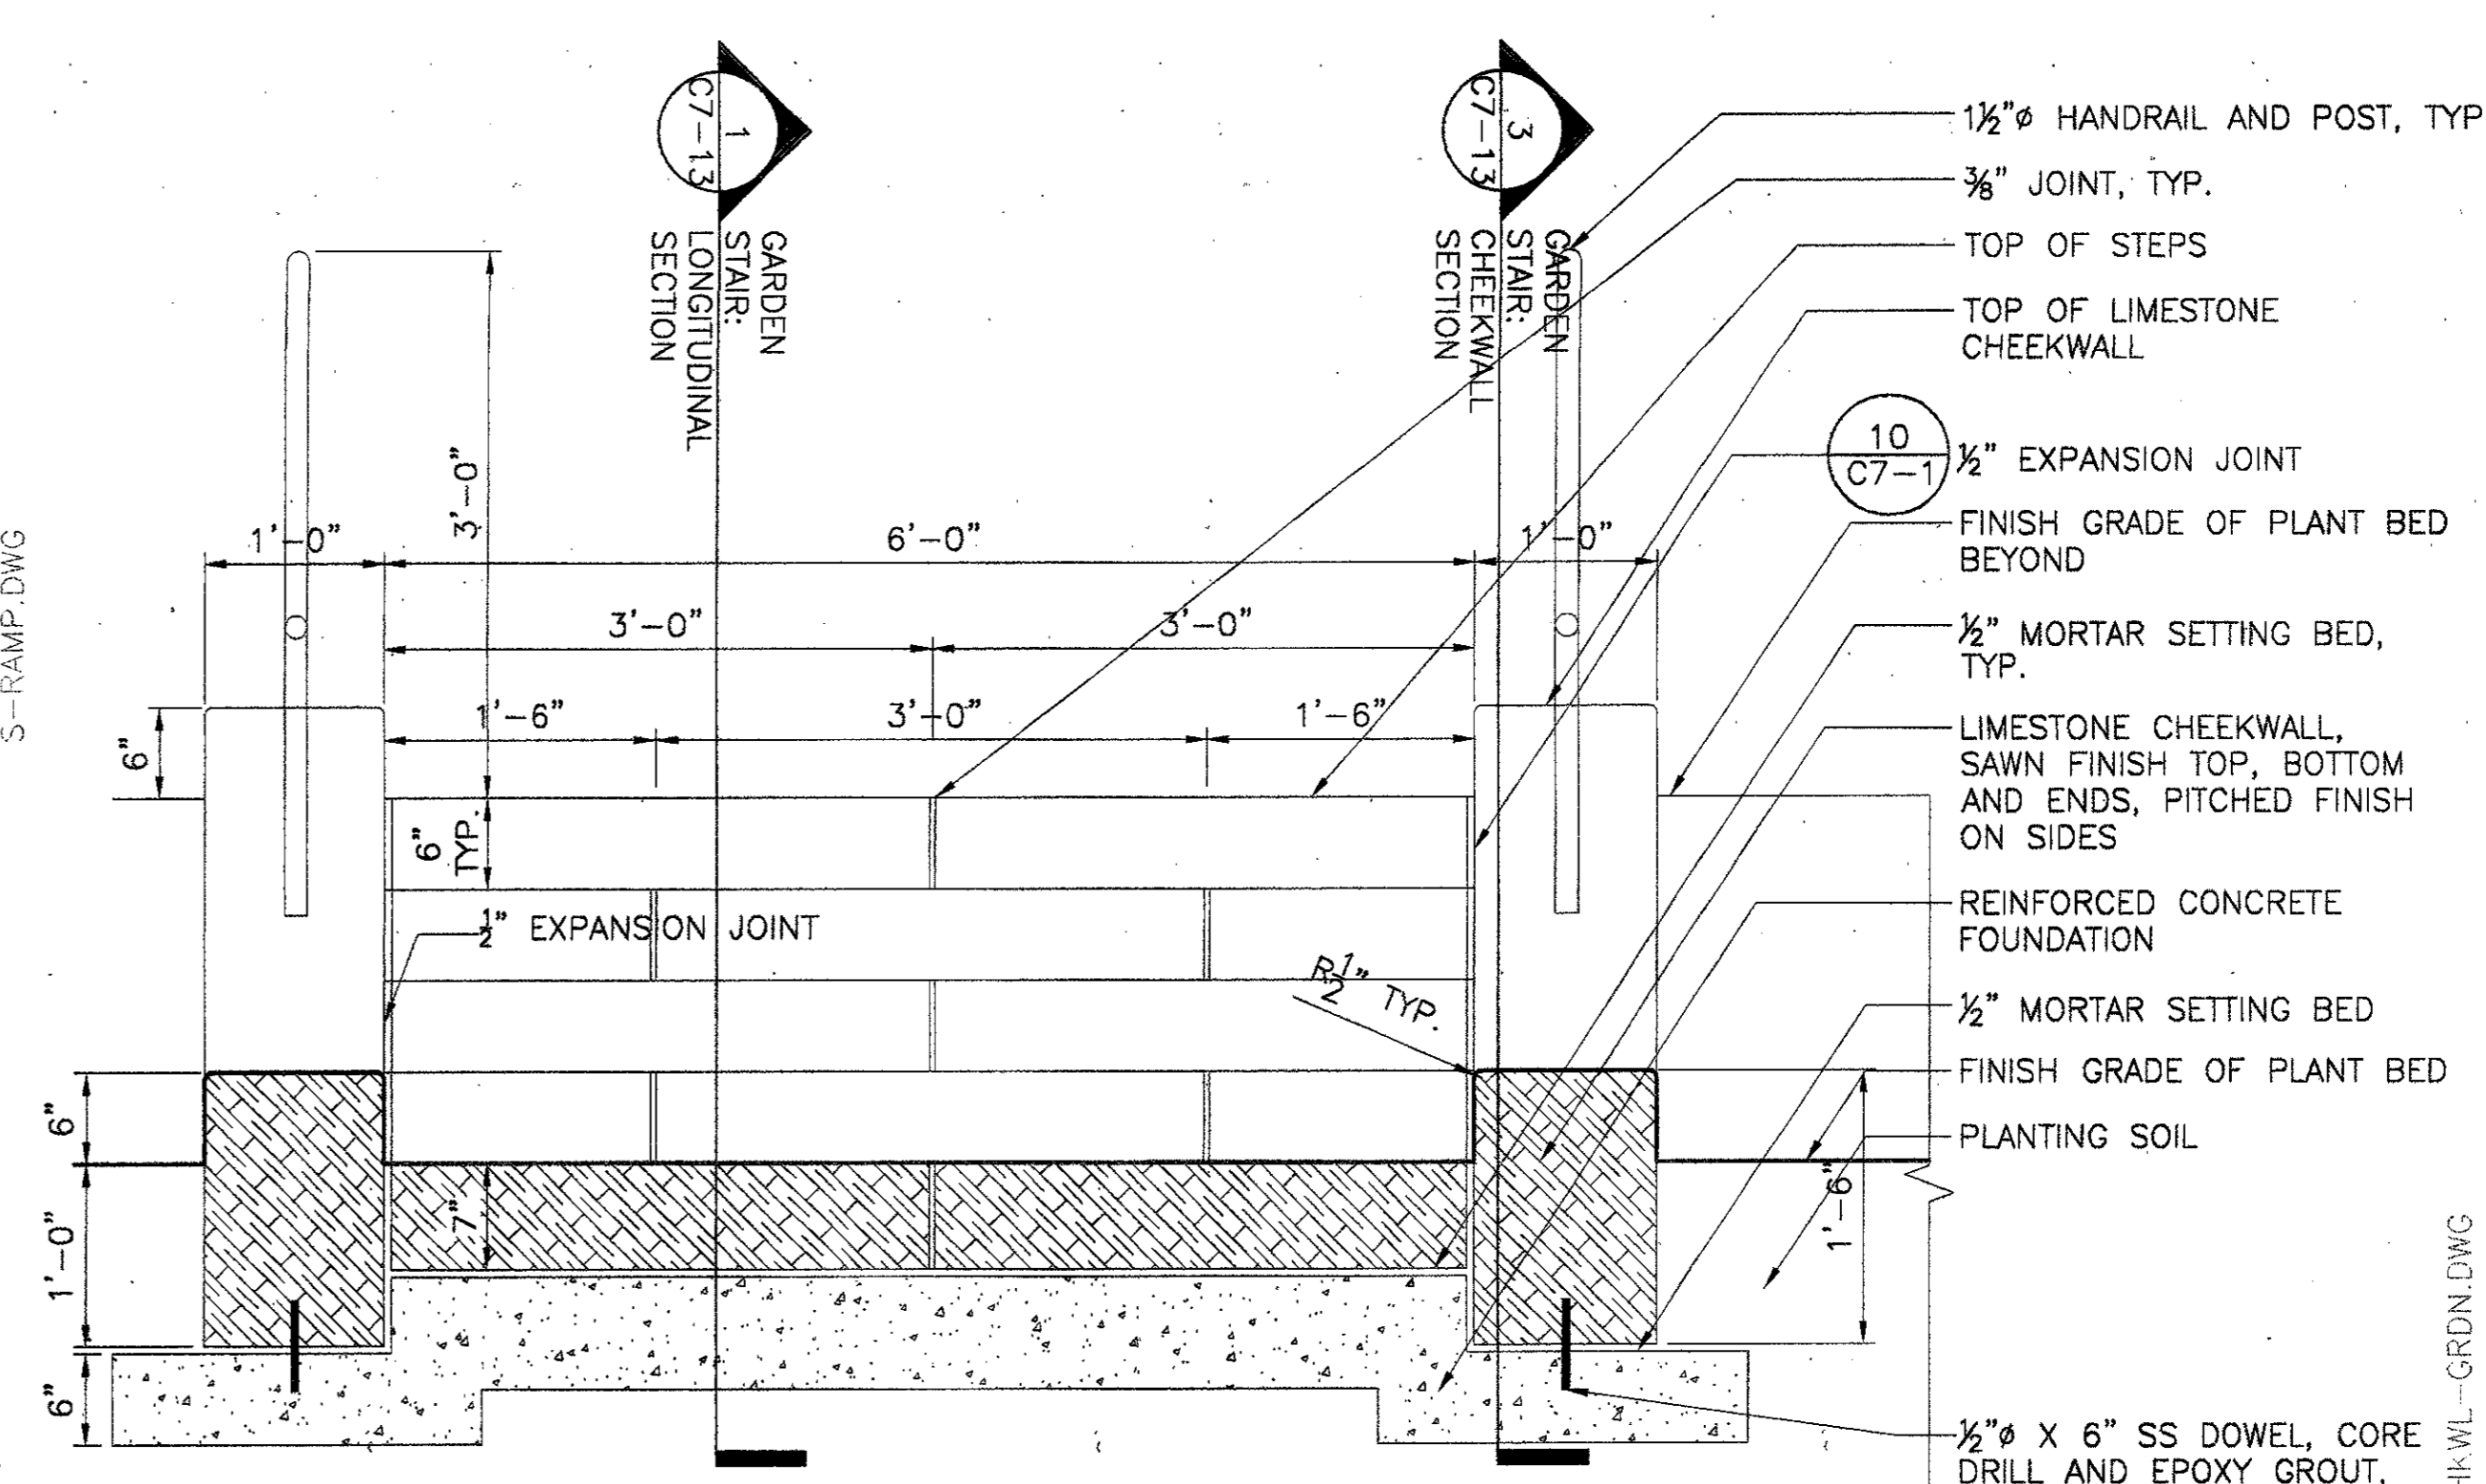


2 TYPICAL GARDEN STAIR CROSS SECTION
 SCALE: 1" = 1'-0"

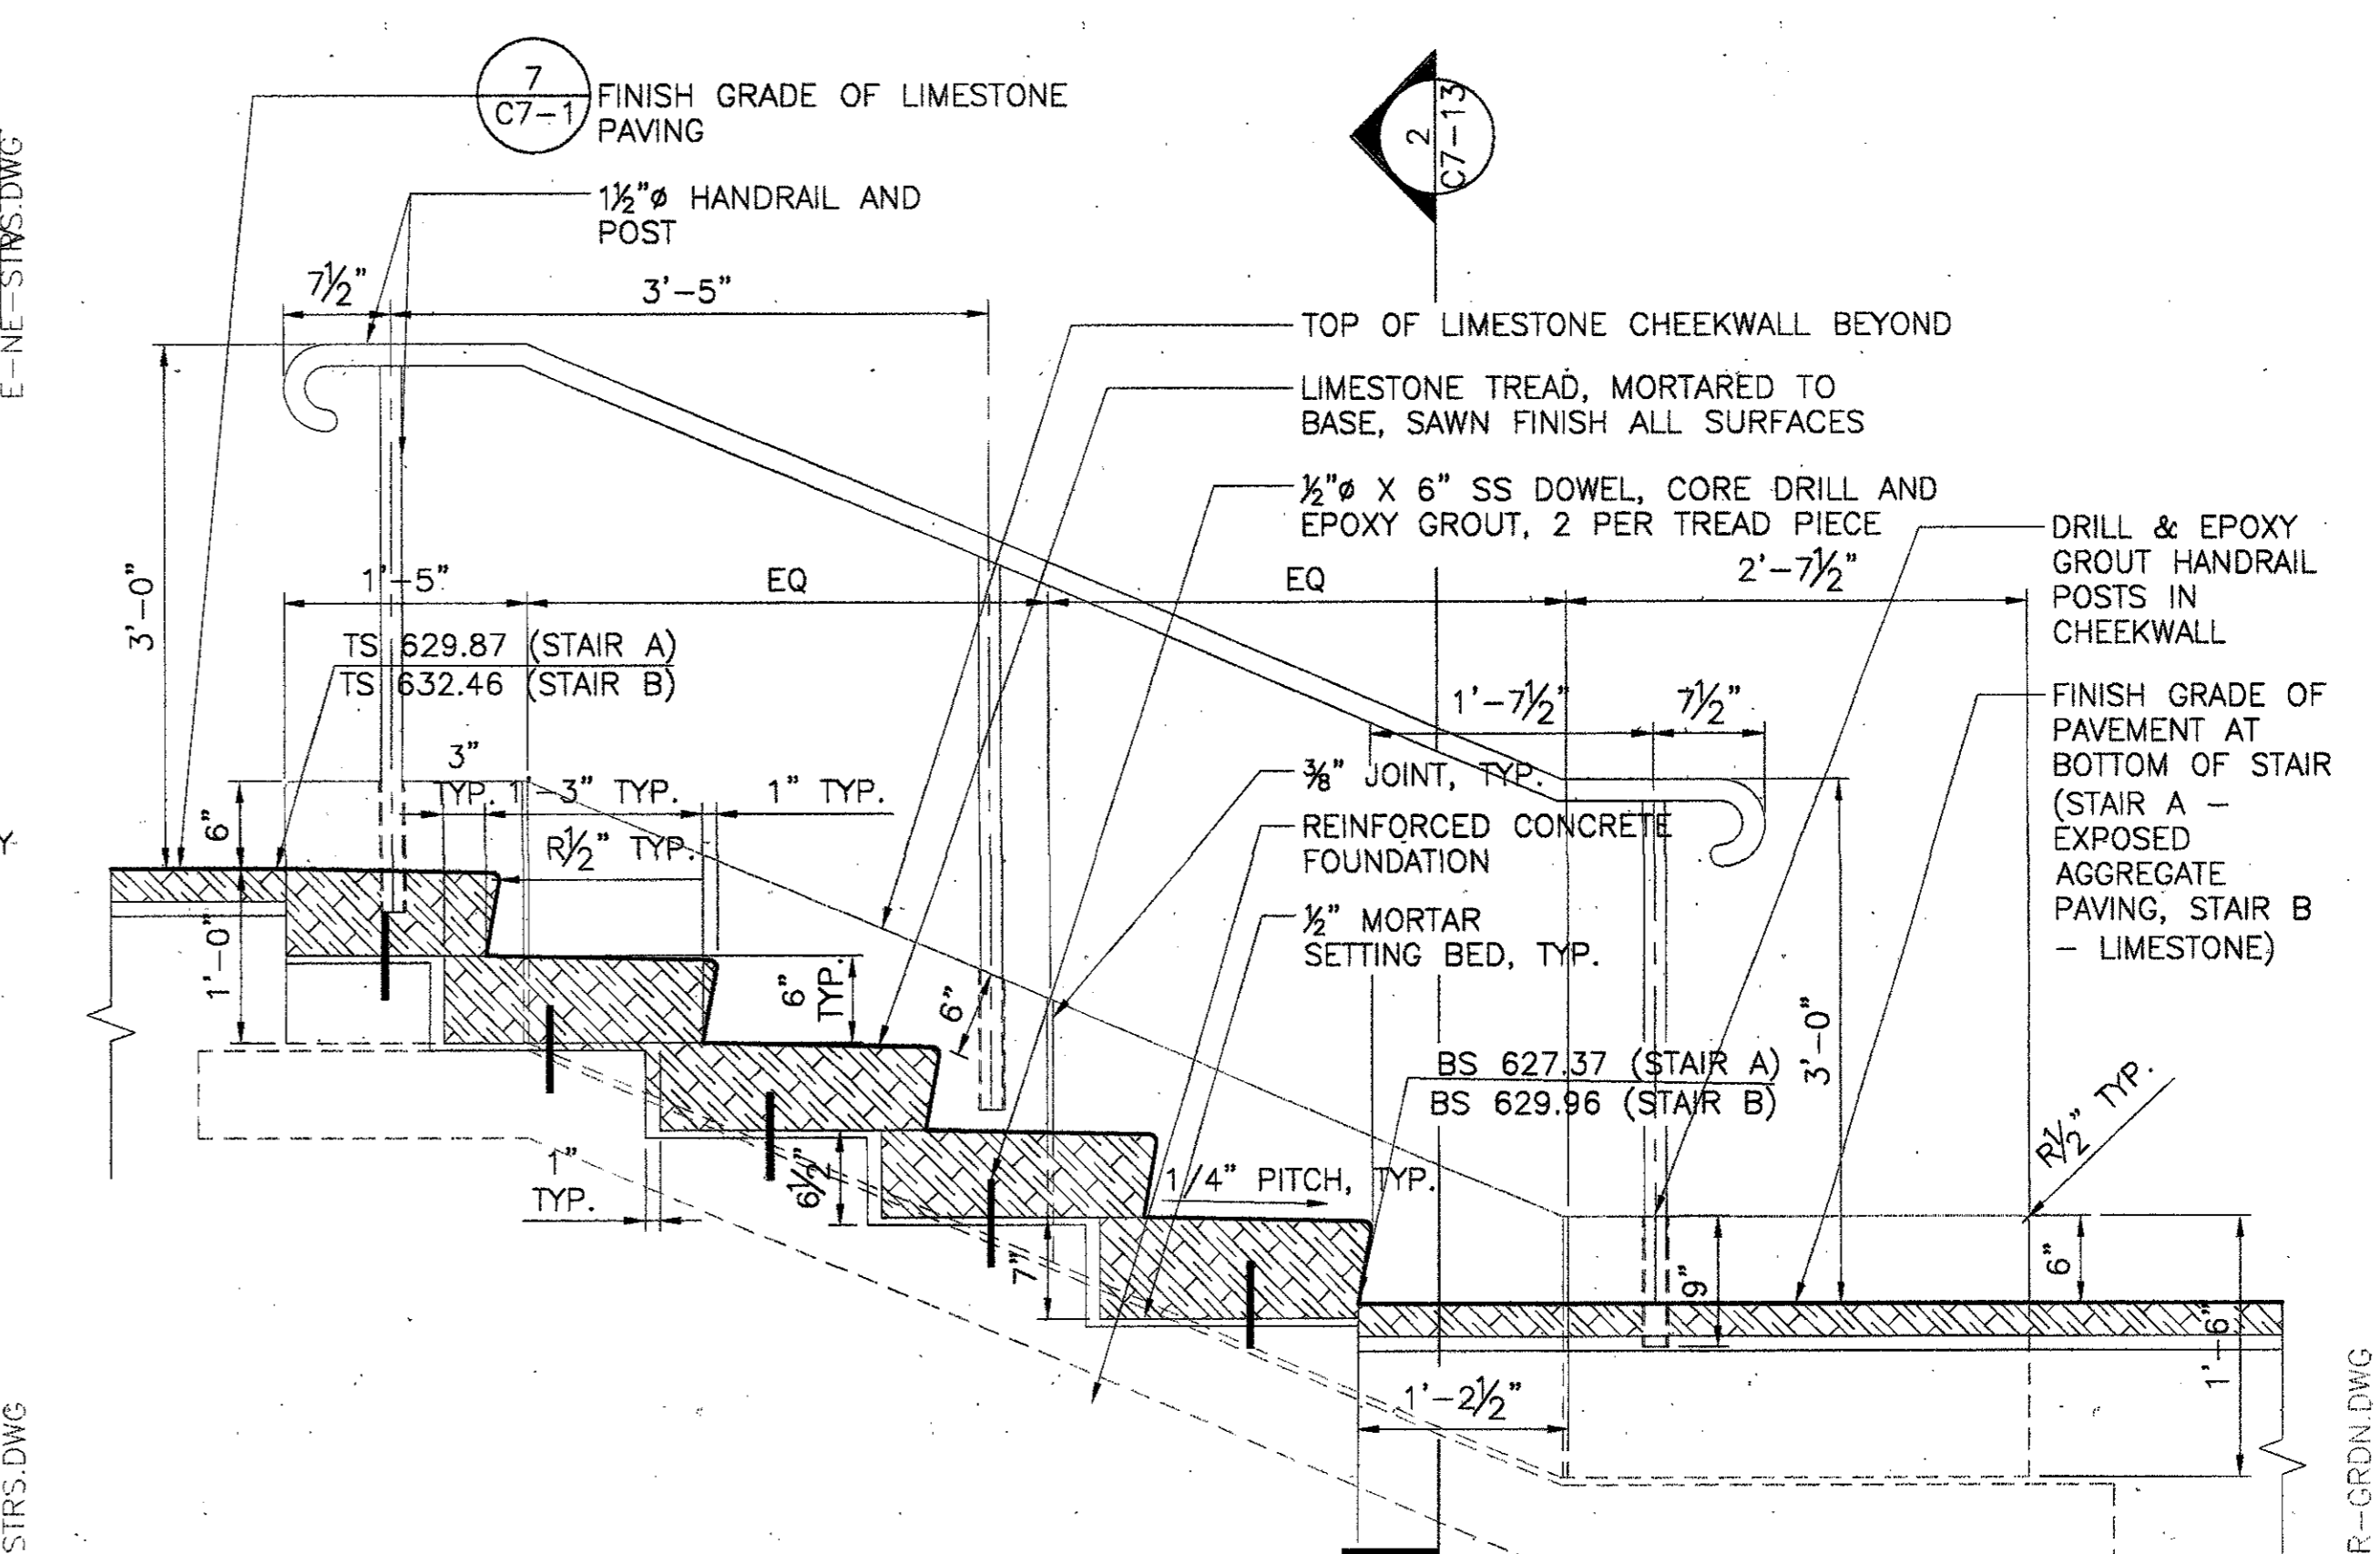

1 GARDEN STAIR: LONGITUDINAL SECTION (TYPICAL FOR STAIRS A & B)
 SCALE: 1" = 1'-0"

ADDENDUM #2	10-21-02	
ISSUED FOR CONSTRUCTION	09-30-02	
No.	Description	Date

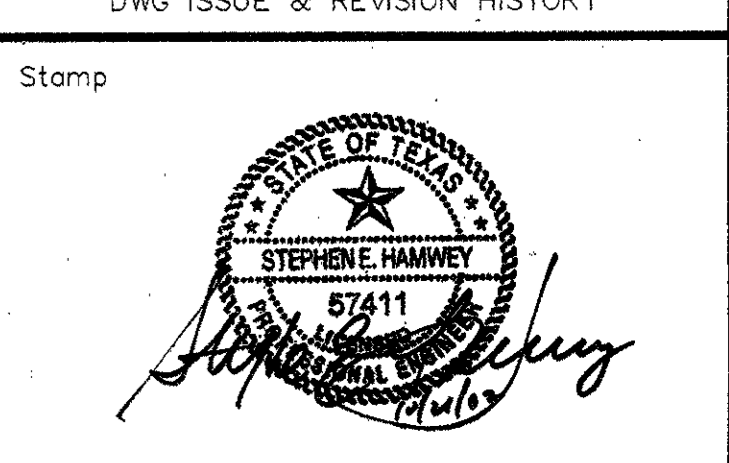

Project Title:
ADDISON ARTS & EVENTS DISTRICT
 ADDISON, TEXAS

Drawing Title:
SITE DETAILS - STAIRS

Project No. 14516.00 Scale: AS NOTED
 Drawn By: CB
 Checked By: DC
 Approved By: SEH
 Date: September 30, 2002

Drawing No. **C7-13**