




SECTION AT ELECTRICAL ROOM ACCESS DOOR
 SCALE: 1" = 1'-0"

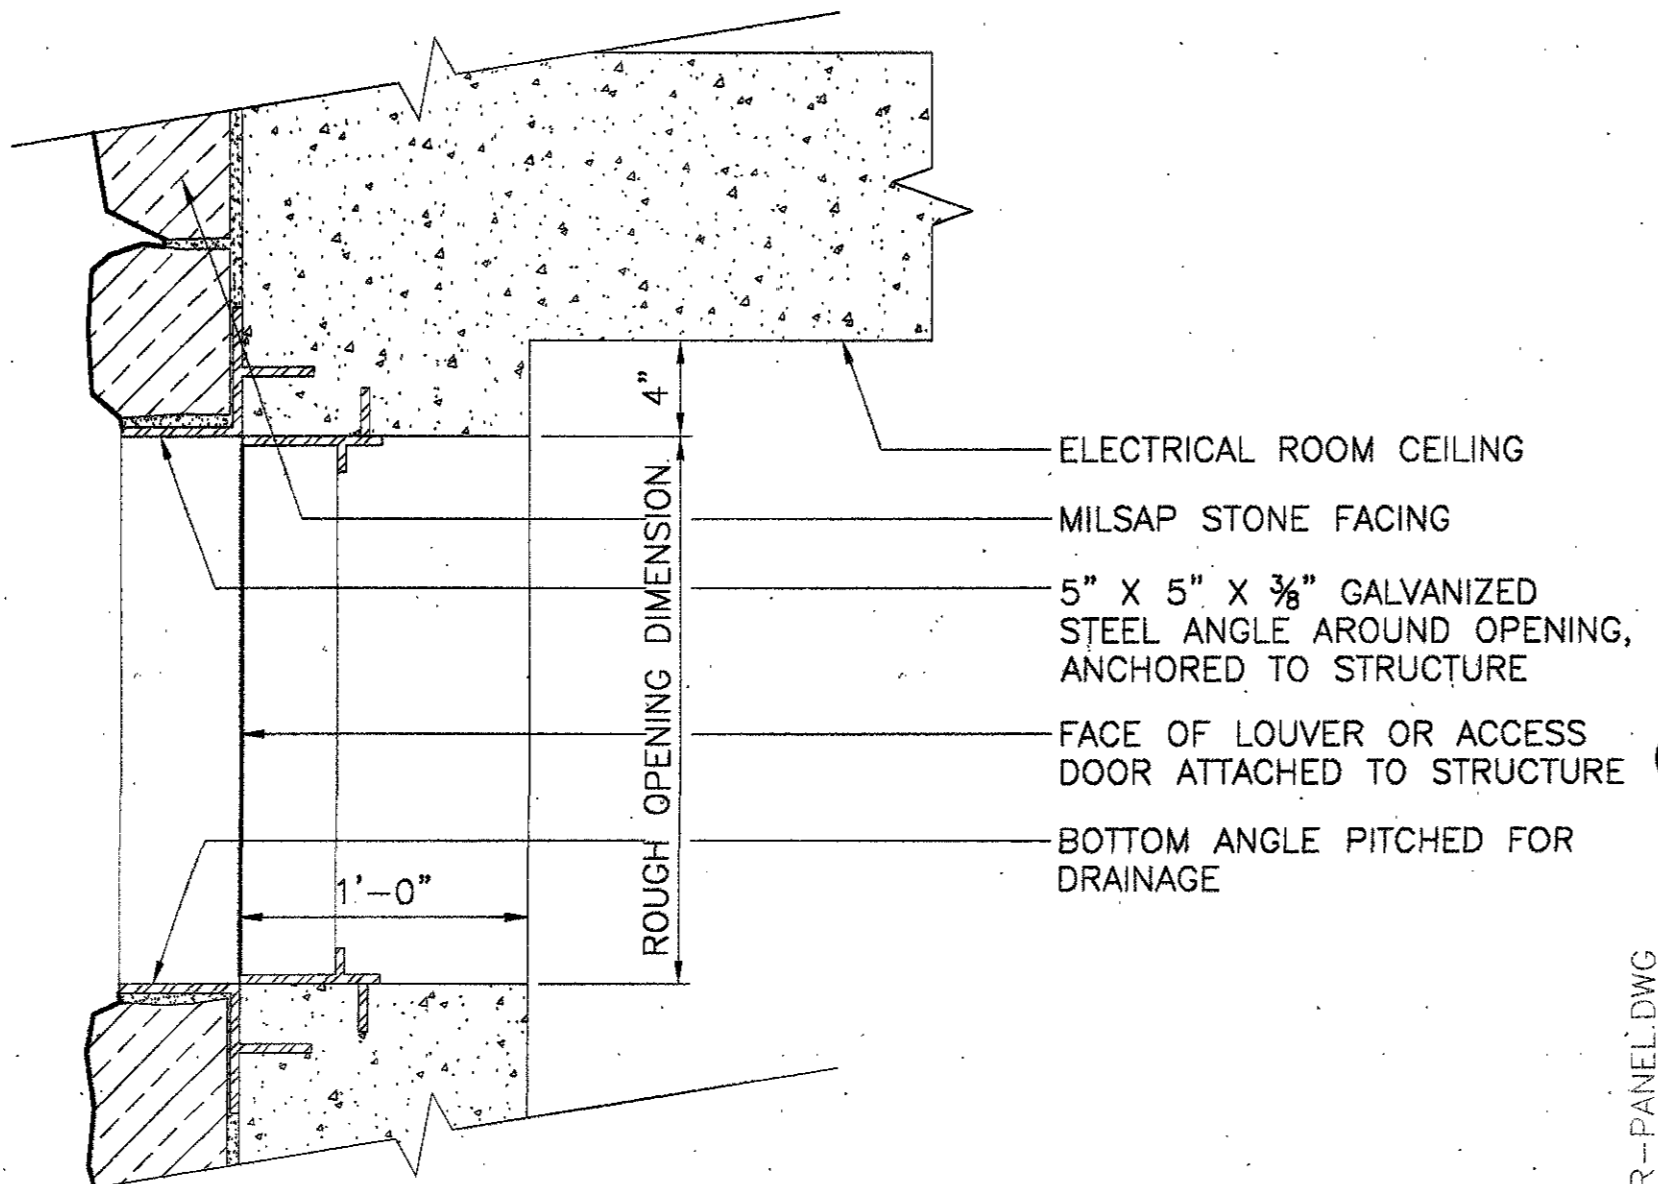


ELECTRICAL ROOM LOUVER & ACCESS PANEL SECTION
 SCALE: 1 1/2" = 1'-0"

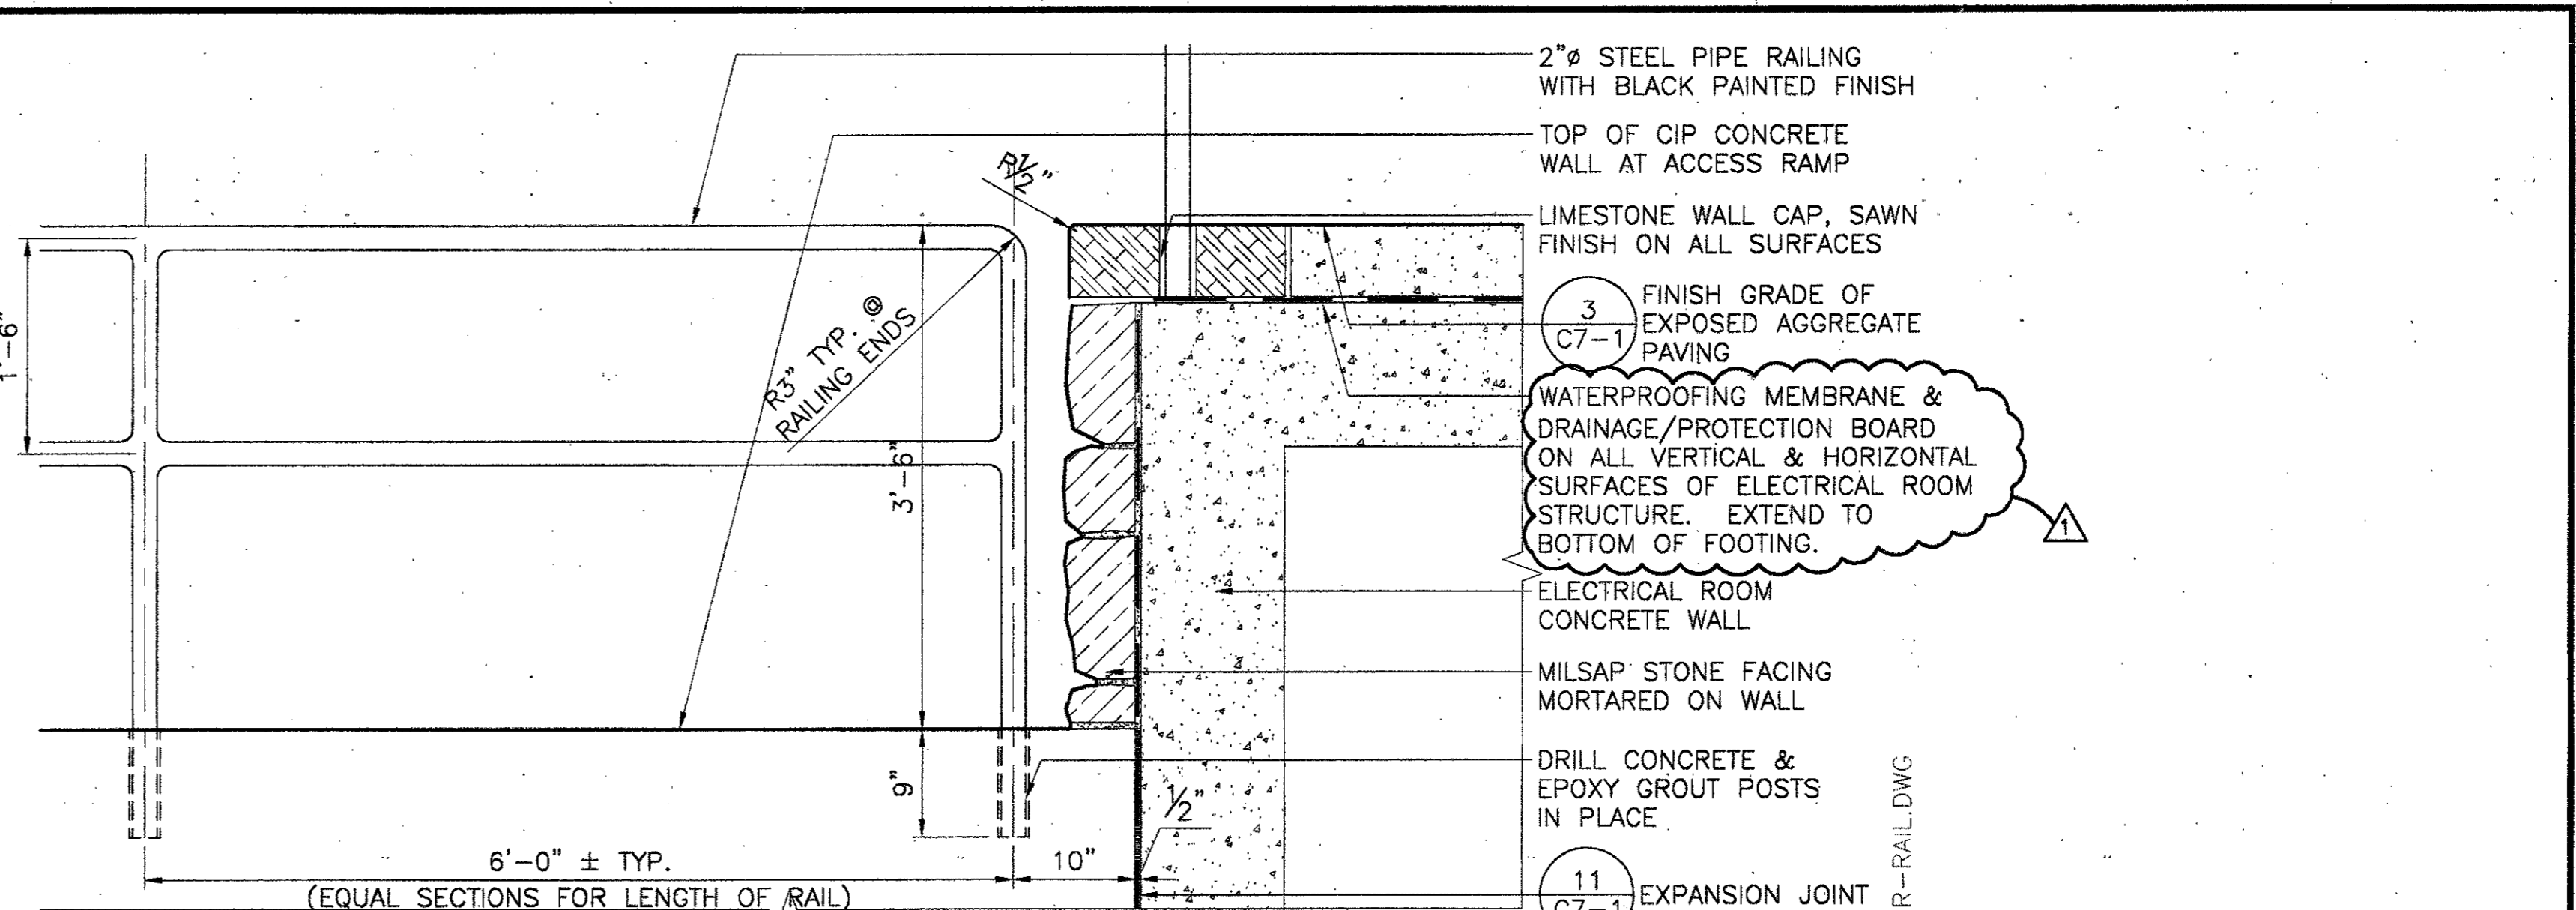


ACCESS RAMP WALL & RAILING ELEVATION @ ELECTRICAL ROOM
 SCALE: 1" = 1'-0"

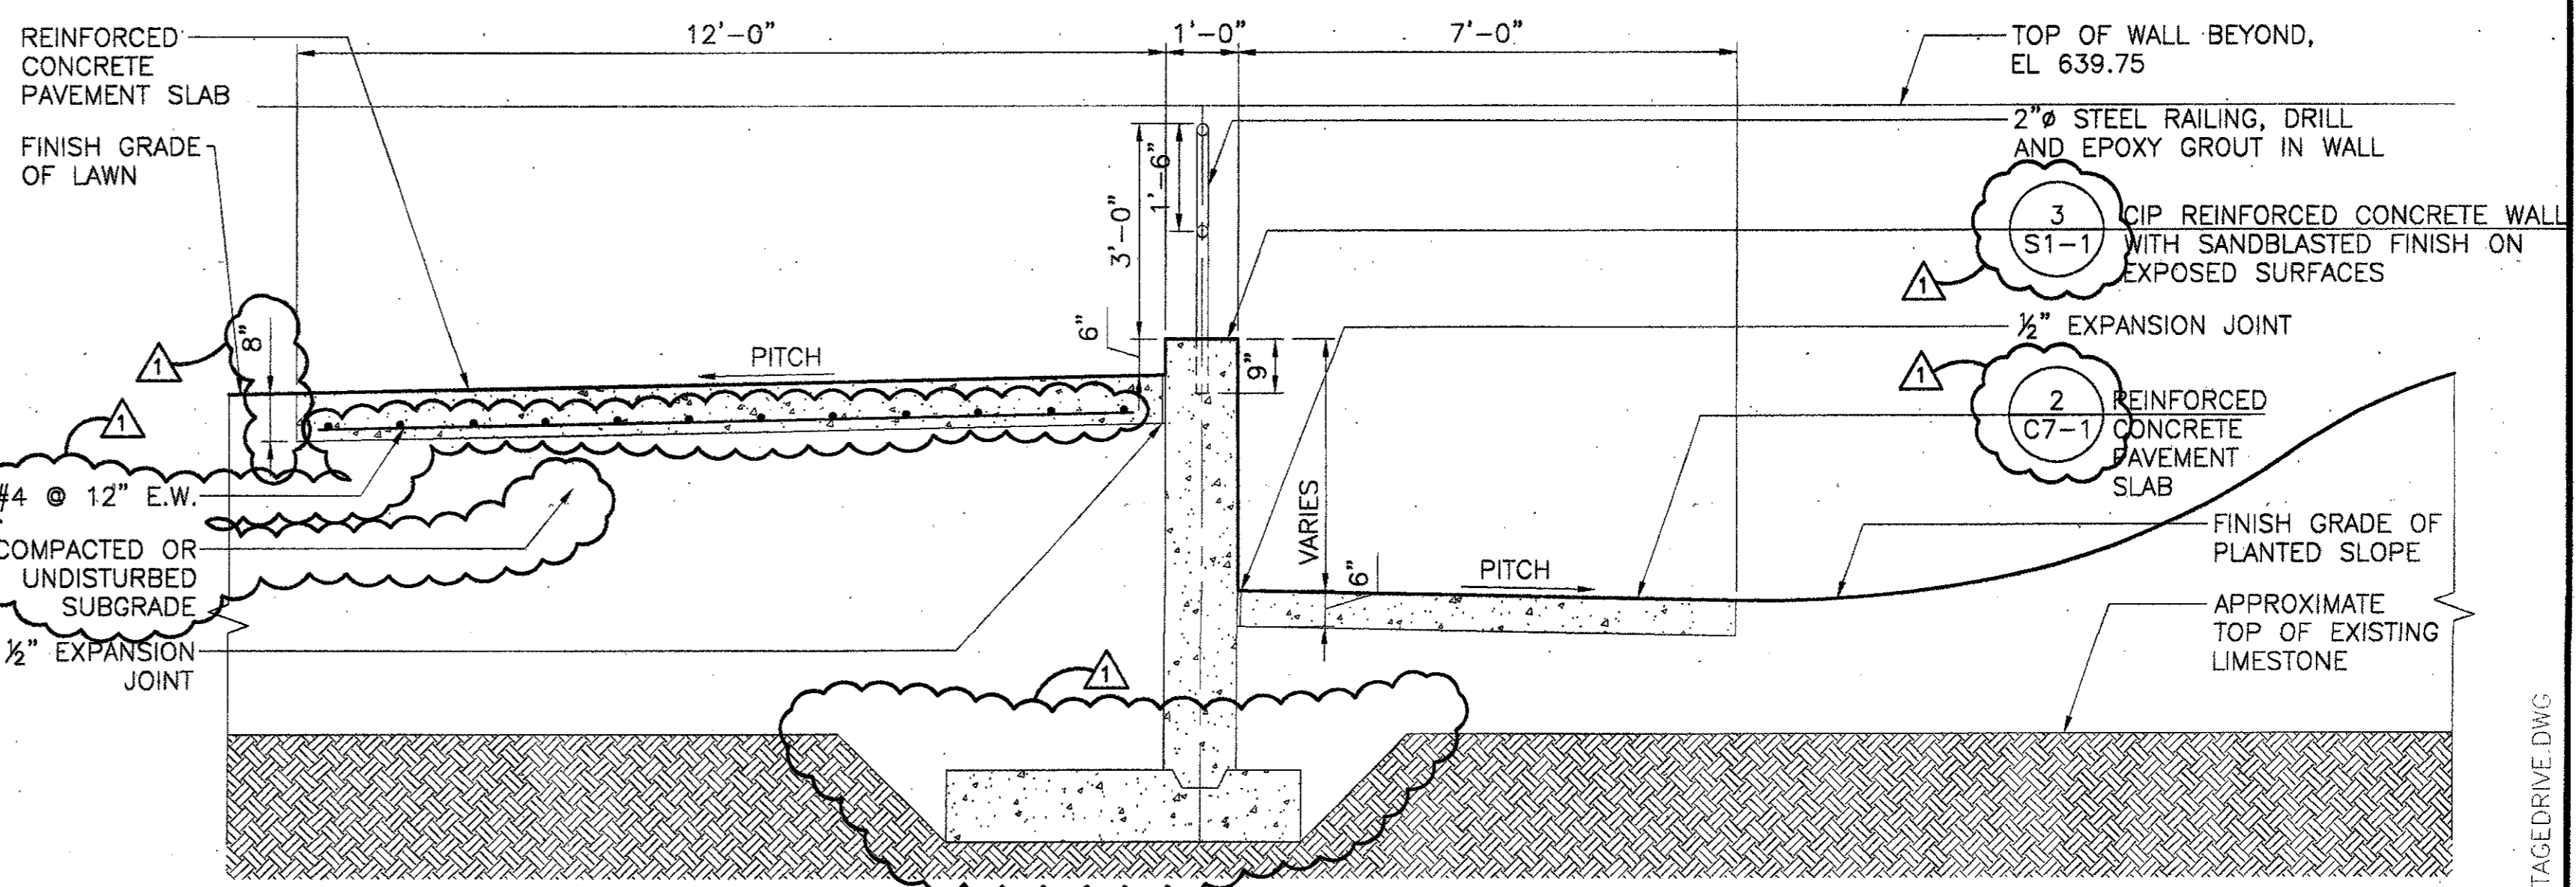

SERVICE DRIVE/RAMP SECTION AT MAIN STAGE
 SCALE: 1/2" = 1'-0"

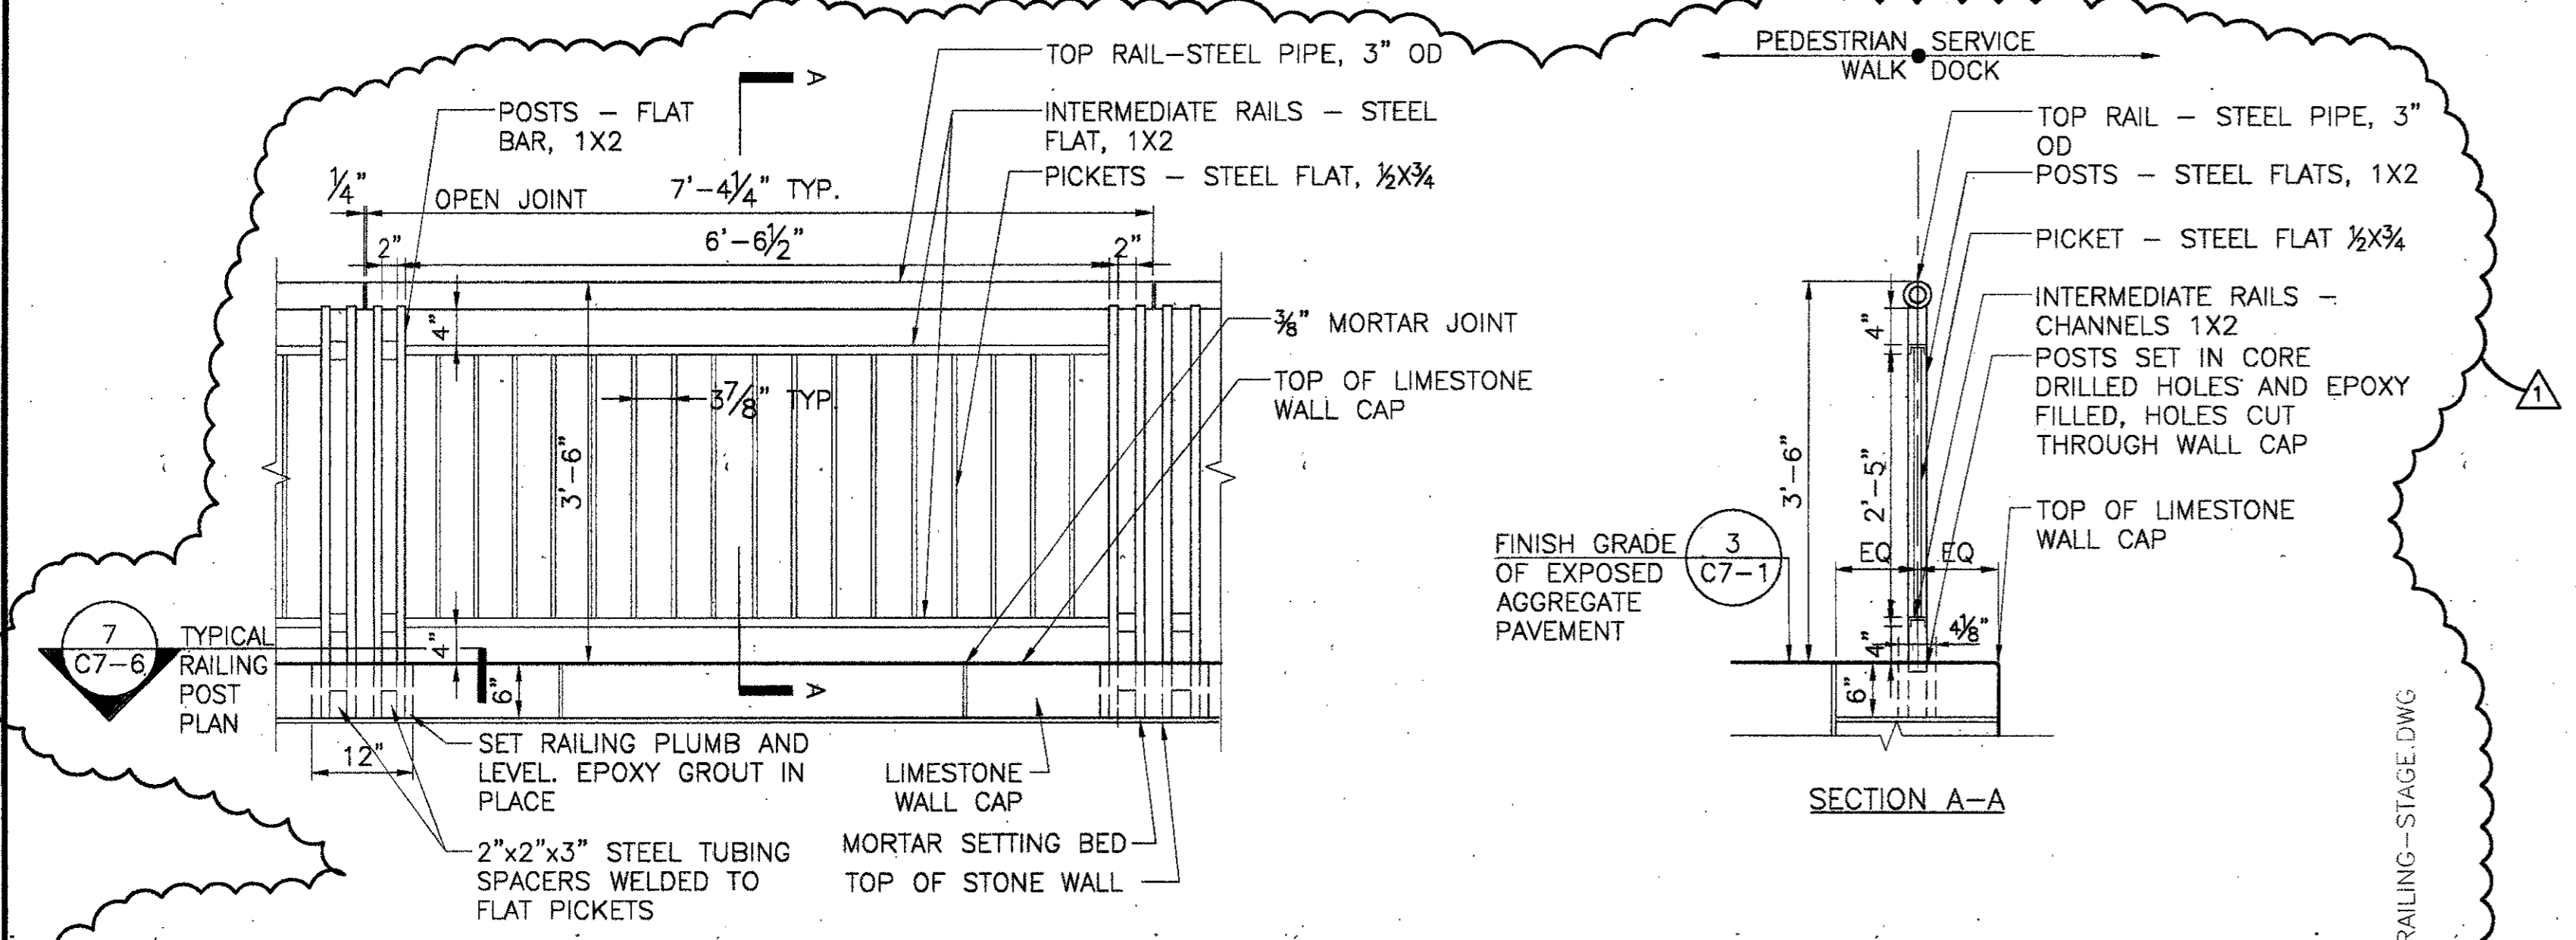

TYPICAL RAILING ELEVATION AT WEST SIDE OF STAGE
 SCALE: 3/4" = 1'-0"

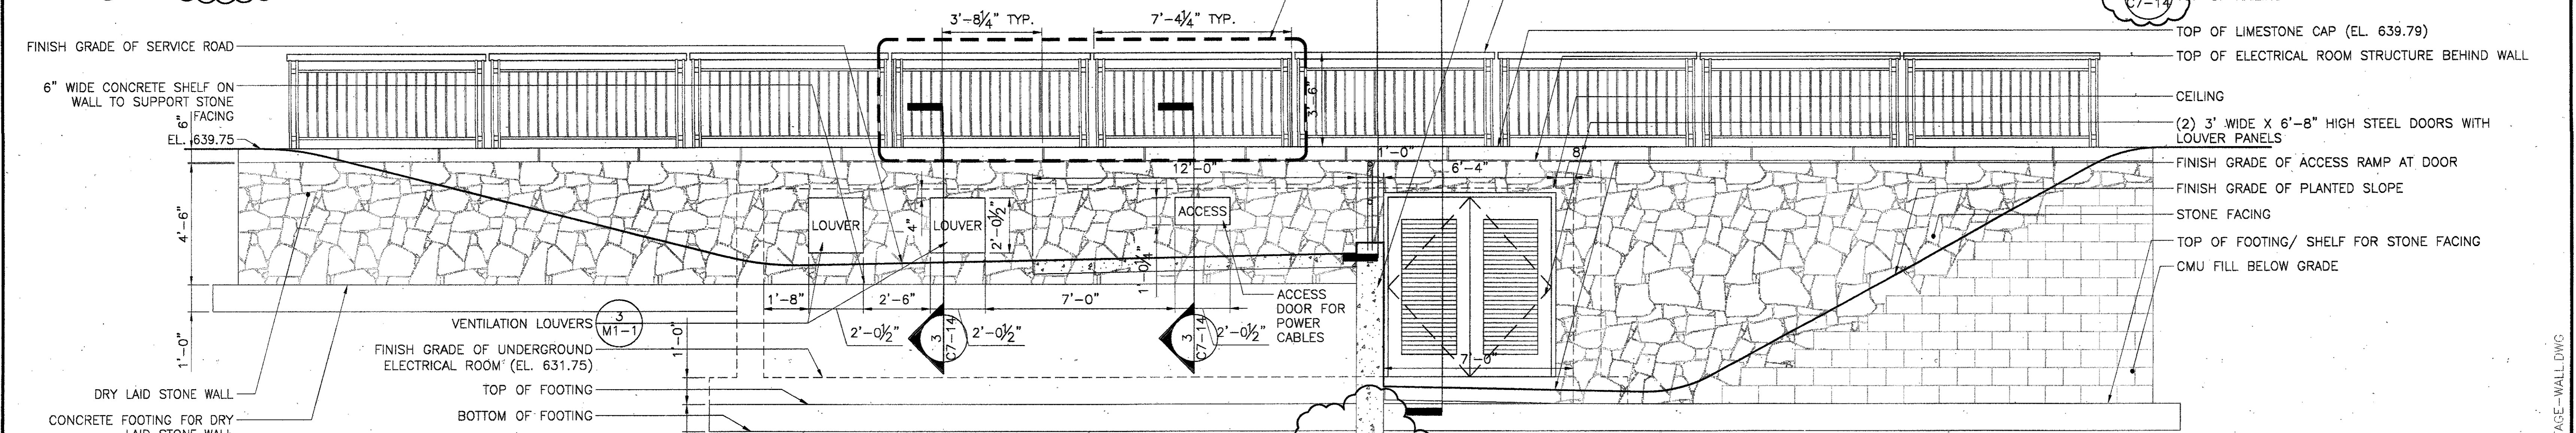

WALL ELEVATION MAIN STAGE, WEST END
 SCALE: 3/8" = 1'-0"

ADDENDUM #2	10-21-02
ISSUED FOR CONSTRUCTION	09-30-02
No. Description	Date

DWG ISSUE & REVISION HISTORY

Stamp

Project Title:
ADDISON ARTS & EVENTS DISTRICT
 ADDISON, TEXAS

Drawing Title:
SITE DETAILS - ELECTRICAL ROOM

Project No. 14516.00 Scale: AS NOTED
 Drawn By: CB
 Checked By: DC
 Approved By: SEH
 Date: September 30, 2002

Drawing No. **C7-14**