




③ Trash Receptacle Mounting  
Scale: 3/4"=1'-0"

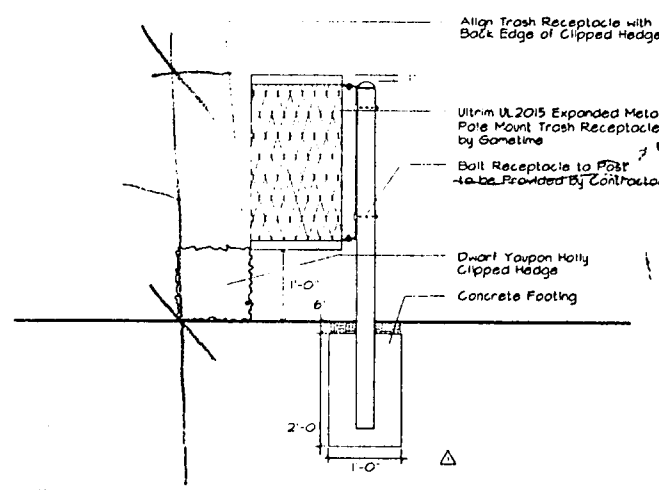


② Trash Receptacle Mounting  
Scale: 3/4"=1'-0"

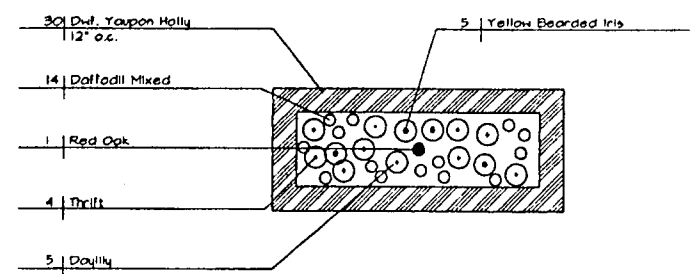


⑨ Tree Well Planting 'A3'  
Scale: 1/4"=1'-0"

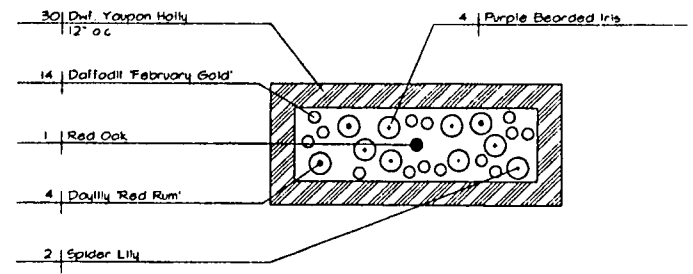


⑧ Tree Well Planting 'A2'  
Scale: 1/4"=1'-0"

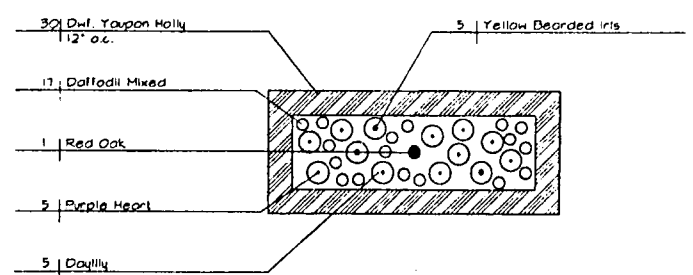


⑦ Tree Well Planting 'A1'  
Scale: 1/4"=1'-0"

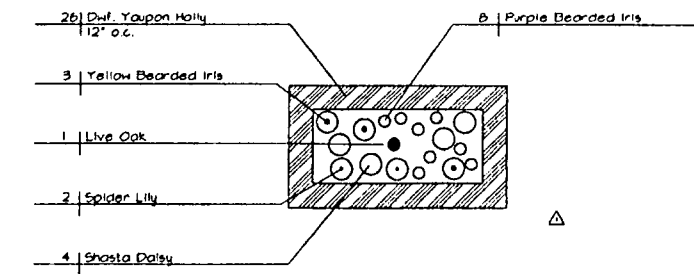


⑥ Tree Well Planting 'B3'  
Scale: 1/4"=1'-0"

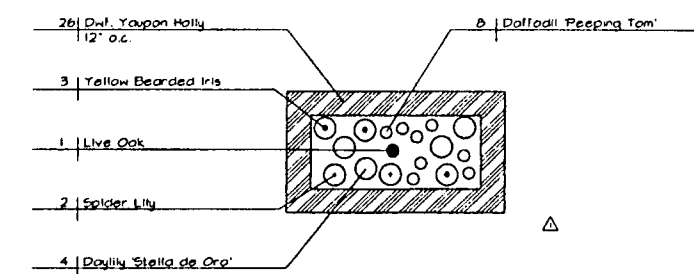


⑤ Tree Well Planting 'B2'  
Scale: 1/4"=1'-0"

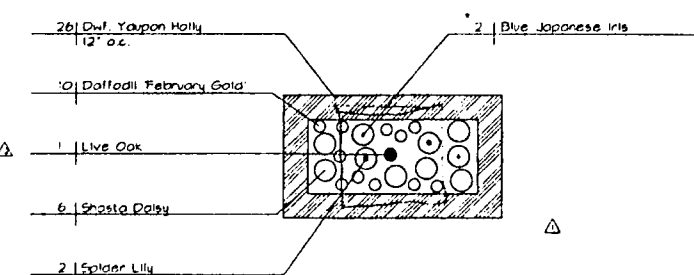


④ Tree Well Planting 'B1'  
Scale: 1/4"=1'-0"

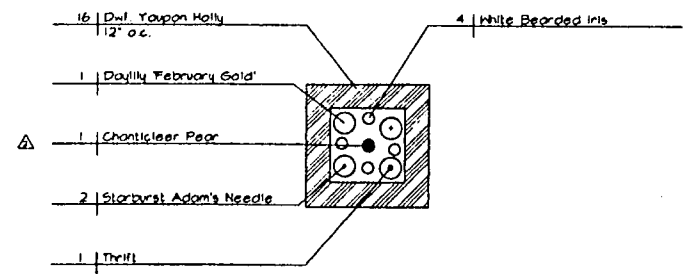


③ Tree Well Planting 'C3'  
Scale: 1/4"=1'-0"

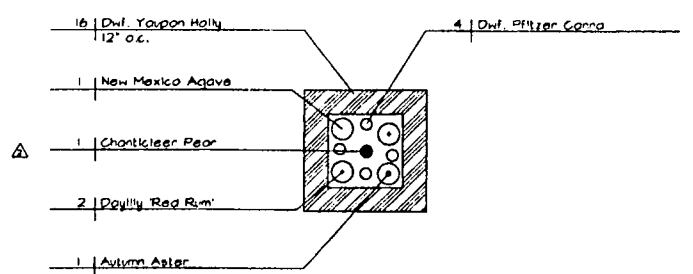


② Tree Well Planting 'C2'  
Scale: 1/4"=1'-0"

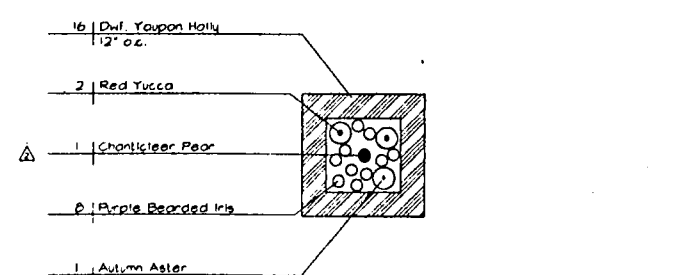

① Tree Well Planting 'C1'  
Scale: 1/4"=1'-0"

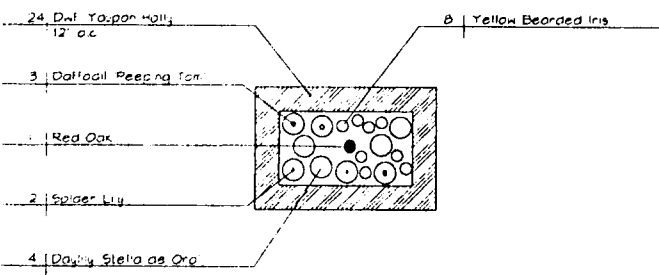

⑪ Tree Well Planting 'A5'  
Scale: 1/4"=1'-0"

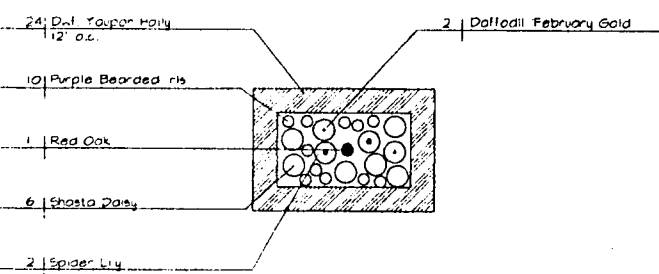

⑩ Tree Well Planting 'A4'  
Scale: 1/4"=1'-0"

- Revisions:
- △ 1-10-96 Change to size of planters
  - △ 1-22-96 Change to plant quantity
- Revisions:
- △ 1-22-96 Addendum #2
- Revisions:
- △ 1-26-96 Addendum #3

*[Handwritten Signature]*

**Newman, Jackson, Bieberstein, Inc.**  
Landscape Architecture Urban and Development Planning  
12710 Colt Road, Suite 210 Dallas, Texas (214) 295-2095 Fax (214) 295-2022

Details					
ADDISON CIRCLE					
PHASE 1					
TOWN OF ADDISON, TEXAS					
Newman, Jackson, Bieberstein, Inc. Engineering/Architecture Dallas Fort Worth Houston El Paso Phoenix Tulsa Ontario San Clemente					
DESIGN	DRAWN	APPR.	SCALE	DATE	PROJECT NO.
PS	TS	GN		12-4-95	0030-95
					129 137

Issued for Construction  
March 28, 1996