

- ELECTRICAL TREE CONDUIT GENERAL NOTES**
- 1 PULL BOXES SHALL BE AS SPECIFIED IN ADDENDUM #2, EXHIBIT "Q" OF THE CONSTRUCTION SPECIFICATIONS AND CONTRACT DOCUMENTS FOR THE PROJECT.
 - 2 ALL CONNECTIONS TO PULL BOXES SHALL BE MADE USING THREADED WATERTIGHT FITTINGS TO INSURE WATER TIGHT PULL BOX INSTALLATION.
 - 3 ALL MAIN RUN CONDUITS SHALL BE SCHEDULE 40 2" PVC INSTALLED A MINIMUM OF 24" BELOW GRADE. CONDUIT BENDS SHALL BE 30-DEGREE, 36" RADIUS MINIMUM. SLEEVES CROSSING STREETS SHALL BE 3" SCHEDULE 40 PVC.
 - 4 ALL BRANCH RUN CONDUITS FROM PULL BOXES TO TREE WELLS SHALL BE SCHEDULE 40 1" PVC INSTALLED A MINIMUM OF 24" BELOW GRADE. SEE TYPICAL DETAIL, SHEET 54B.
 - 5 INSTALL PULL CORD IN ALL 2" CONDUITS WITH 24" SLACK.
 - 6 THIS PLAN IS A SCHEMATIC REPRESENTATION OF CONDUIT SIZES AND LOCATIONS. SEE SHEET 57 FOR HORIZONTAL LOCATIONS OF CONDUIT IN TREE PITS. CONDUITS AND PULL BOXES MAY BE ADJUSTED HORIZONTALLY AND VERTICALLY TO AVOID CONFLICT WITH OTHER UTILITIES AT THE DIRECTION OF THE ENGINEER.
 - 7 SEE TREE LIGHTING POWER PLANS (SEE SEPARATE CONTRACT) FOR WIRING, OUTLETS AT EACH TREE AND DETAILED DESIGN OF SYSTEM TO THE APPROXIMATE SERVICE POINTS SHOWN ON THIS PLAN.


- LEGEND:**
- △ △
 - PULL BOX
 - 2" SCH. 40 PVC TREE LIGHTING CONDUIT
 - 1" SCH. 40 PVC TREE LIGHTING CONDUIT
 - 3" SCH. 40 PVC TREE LIGHTING CONDUIT

DELETED CONDUIT ON OUTER RING ON EAST SIDE OF CIRCLE, MORRIS AVENUE AND WITT MEWS. REVISED LEGEND TO CHANGE 3" CONDUIT TO 1" CONDUIT. 5/5/97

REVISED LEGEND TO CHANGE 1" TO 3/4", CHANGE 3" TO 2", AND ADD A NEW SYMBOLOLOGY FOR 3" CONDUIT. 9/25/96

ISSUED FOR CONSTRUCTION
JULY 2, 1996

THE SEAL APPEARING ON THIS DOCUMENT WAS AUTHORIZED BY KENNETH A. ROBERTS, P.E. 55446 ON JULY 2, 1996.

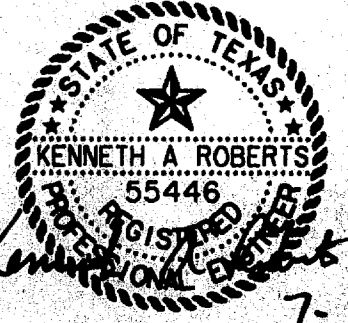

TREE LIGHTING CONDUIT PLAN							
ADDISON CIRCLE							
PHASE I PUBLIC INFRASTRUCTURE							
TOWN OF ADDISON, TEXAS							
Huitt-Zollars, Inc./Engineering/Architecture Dallas, Fort Worth, Houston, El Paso, Phoenix, Tustin, Ontario, San Clemente							
DESIGN	DRAWN	APPR.	SCALE	DATE	PROJECT NO.	NO.	
HZI	HZI	KAR	1"=30'	JUL 96	1822-04	54A	


