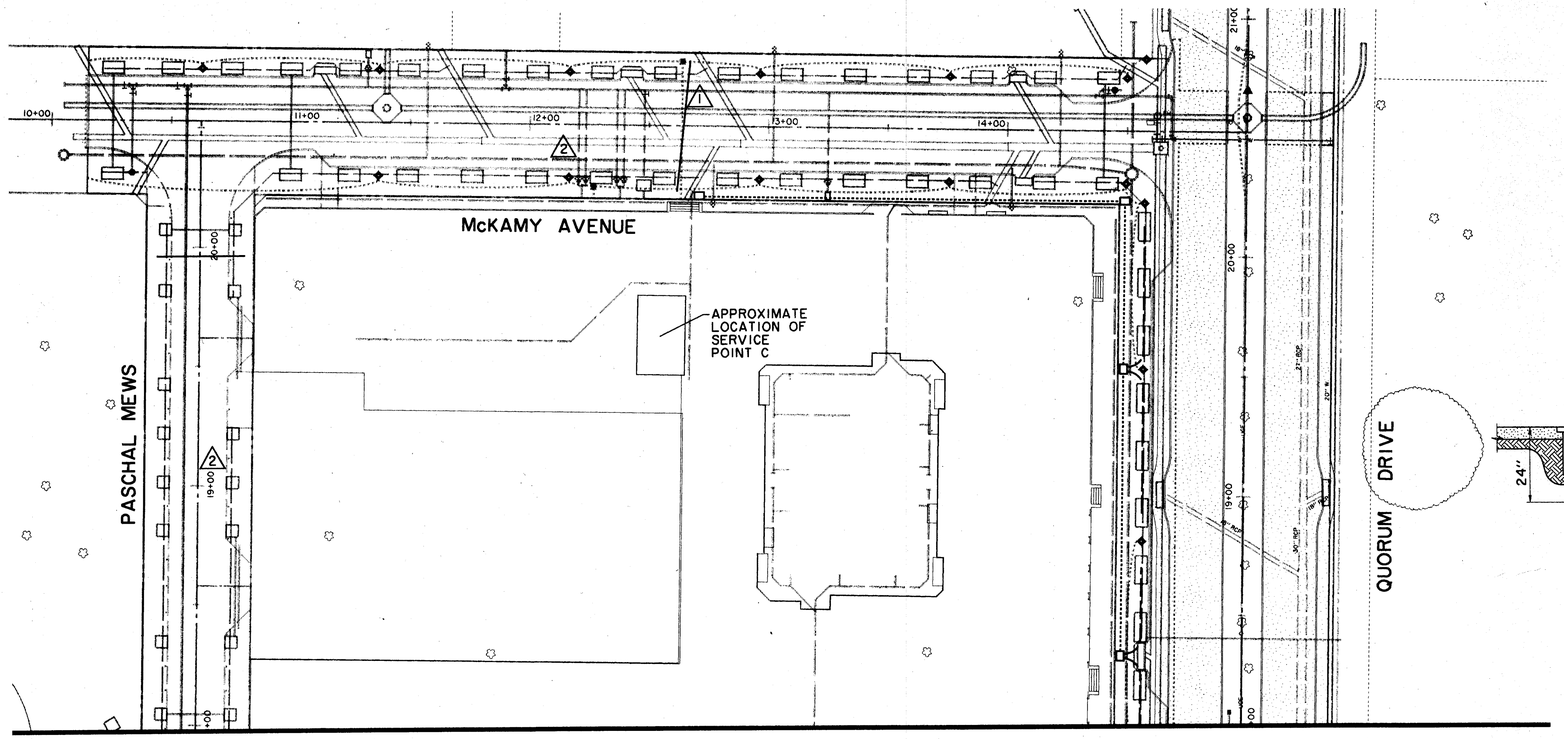

MATCH LINE A SEE SHEET 54A

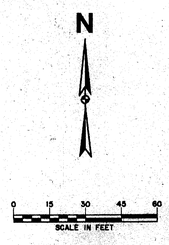

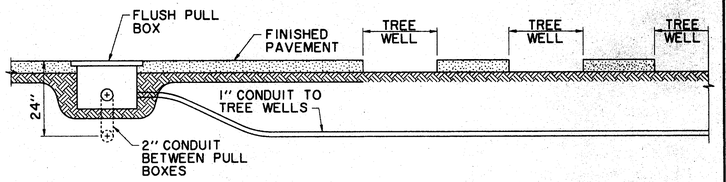

TYPICAL TREE CIRCUIT CONDUIT INSTALLATION (2)
N.T.S.

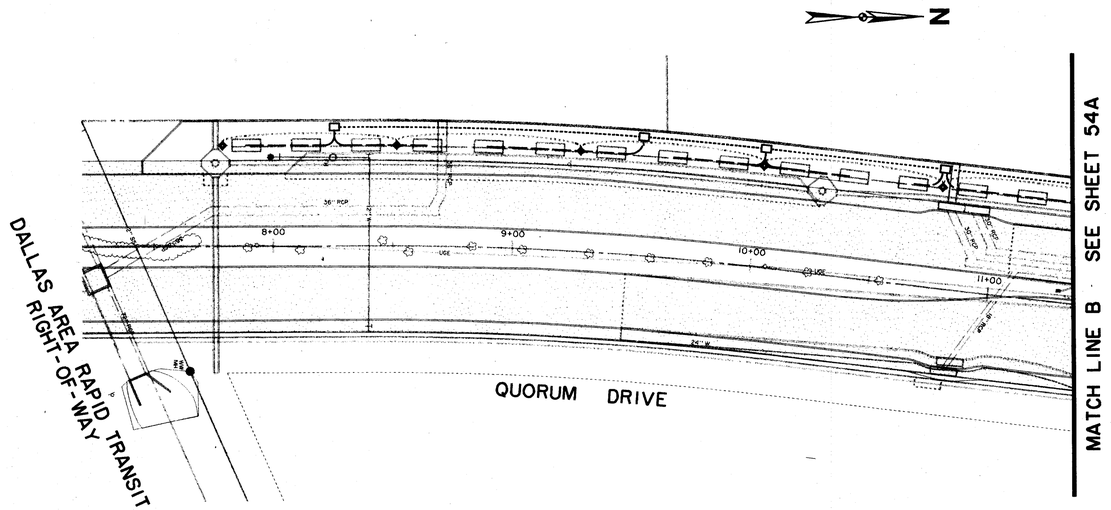

LEGEND: (1) (2)

- PULL BOX
- 2" SCH. 40 PVC TREE LIGHTING CONDUIT
- 1" SCH. 40 PVC TREE LIGHTING CONDUIT
- 3" SCH 40 PVC TREE LIGHTING CONDUIT

(2) DELETED CONDUIT ON PASCHAL MEWS AND McKAMY AVENUE EXCEPT ONE FEED TO QUORUM TREES; REVISED LEGEND TO CHANGE ¾" CONDUIT TO 1" CONDUIT; REVISED TYPICAL TREE CONDUIT INSTALLATION DETAIL. 5/15/97

(1) REVISED LEGEND TO CHANGE 1" TO ¾". CHANGE 3" TO 2". AND ADD A NEW SYMBOLOGY FOR 3" CONDUIT. 9/25/96

ISSUED FOR CONSTRUCTION
JULY 2, 1996

THE SEAL APPEARING ON THIS DOCUMENT WAS AUTHORIZED BY KENNETH A. ROBERTS, P.E. 55446 ON JULY 2, 1996.

STATE OF TEXAS
KENNETH A ROBERTS
55446
REGISTERED
PROFESSIONAL ENGINEER

7-2-96

TREE LIGHTING CONDUIT PLAN

ADDISON CIRCLE

PHASE I PUBLIC INFRASTRUCTURE

TOWN OF ADDISON, TEXAS

Huitt-Zollars, Inc./Engineering/Architecture
Dallas, Fort Worth, Houston, El Paso, Phoenix, Tustin, Ontario, San Clemente

DESIGN	DRAWN	APPR.	SCALE	DATE	PROJECT NO.	NO.
HZI	HZI	KAR	1"=30'	JUL 96	1822-04	54B / 137

h:\proj\1822\04\dgn\AUCITL03.DGN

PRF ROTATION=90.000000
FILTER=WALLS.FIL
h:\proj\1822\04\dgn\AUCITL03.DGN
Mon May 5 16:44:25 1997
Huitt-Zollars, Inc.
B:\AUCIRDGN; 1=1\1=1\1=1\1=1\2=2\3=3\4=4\5=5\6=6\7=7\8=8\9=9\10=10\11=11\12=12\13=13\14=14\15=15\16=16\17=17\18=18\19=19\20=20\21=21\22=22\23=23\24=24\25=25\26=26\27=27\28=28\29=29\30=30\31=31\32=32\33=33\34=34\35=35\36=36\37=37\38=38\39=39\40=40\41=41\42=42\43=43\44=44\45=45\46=46\47=47\48=48\49=49\50=50\AUCITL.DGN
