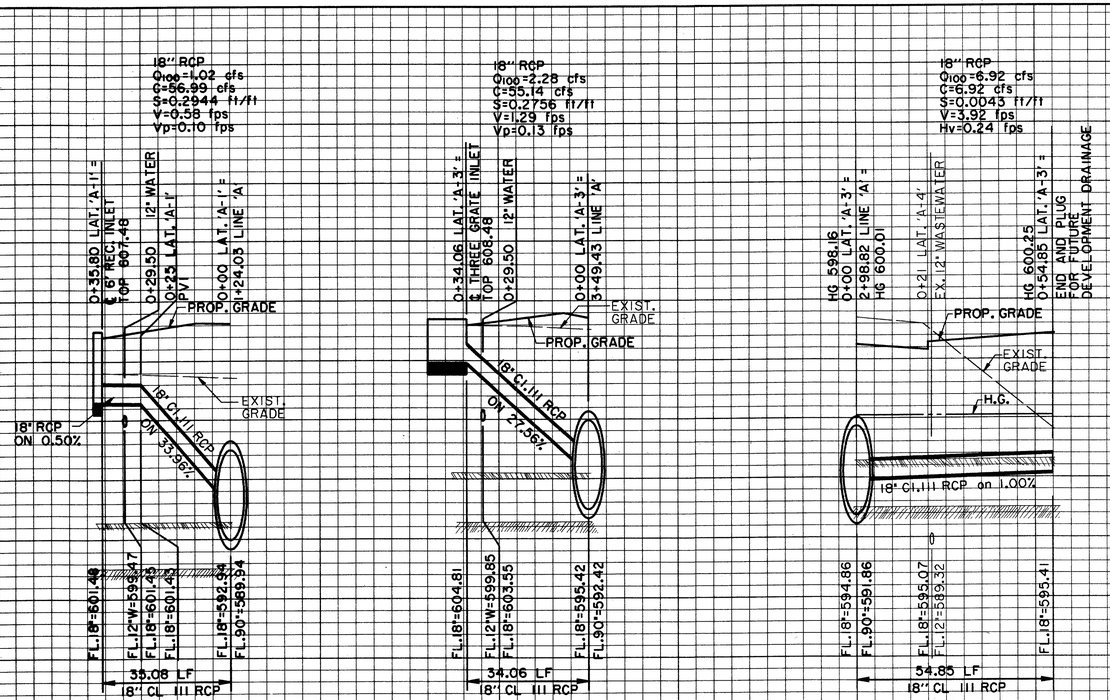

THE SEAL APPEARING ON THIS DOCUMENT WAS AUTHORIZED BY DAVID E. MEYERS, P.E. 81512 ON 10/27/97

STATE OF TEXAS · DAVID E. MEYERS · 81512 · REGISTERED · PROFESSIONAL ENGINEER · 10/27/97

DATE	DESCRIPTION	REF NO.
10/27/97	RECORD DRAWING	1
6/16/97	ISSUED FOR CONSTRUCTION	N/A
6/2/97	ISSUED FOR BID	N/A

STORM WATER LATERAL PROFILES
LATERALS "A" AND "J"

ADDISON CIRCLE
PHASE II MASS GRADING

TOWN OF ADDISON, TEXAS

Huitt-Zollars, Inc./Engineering/Architecture
Dallas, Fort Worth, Houston, El Paso, Phoenix, Tustin, Ontario

DESIGN	DRAWN	APPR.	SCALE	DATE	PROJECT NO.	NO.
HZI	HZI	DEM	H. 1"=20' V. 1"=6'	JUNE 97	01-1822-34	SW9

H:\PROJ\01822211\DGN\ACMGDG13.DGN