


NOTES:

- SEE LANDSCAPE PLANS FOR FINAL COURTYARD GRADES AND DRAIN TYPES.
- SEE OVERALL BUILDING DRAINAGE PLAN FOR GENERAL NOTES AND CONNECTION DETAIL.

BENCHMARKS:

BM#1
 "C" CUT AT CENTER BACK OF CURB OF INLET, 190 FEET SOUTH FROM THE CENTERLINE INTERSECTION OF ADDISON CIRCLE, WEST SIDE OF QUORUM DRIVE.
 ELEV. 621.89

BM#4
 "C" CUT AT CENTER OF CURB INLET, 1015 FEET NORTH FROM THE CENTERLINE INTERSECTION OF ADDISON CIRCLE, WEST SIDE OF QUORUM DRIVE.
 ELEV. 629.36

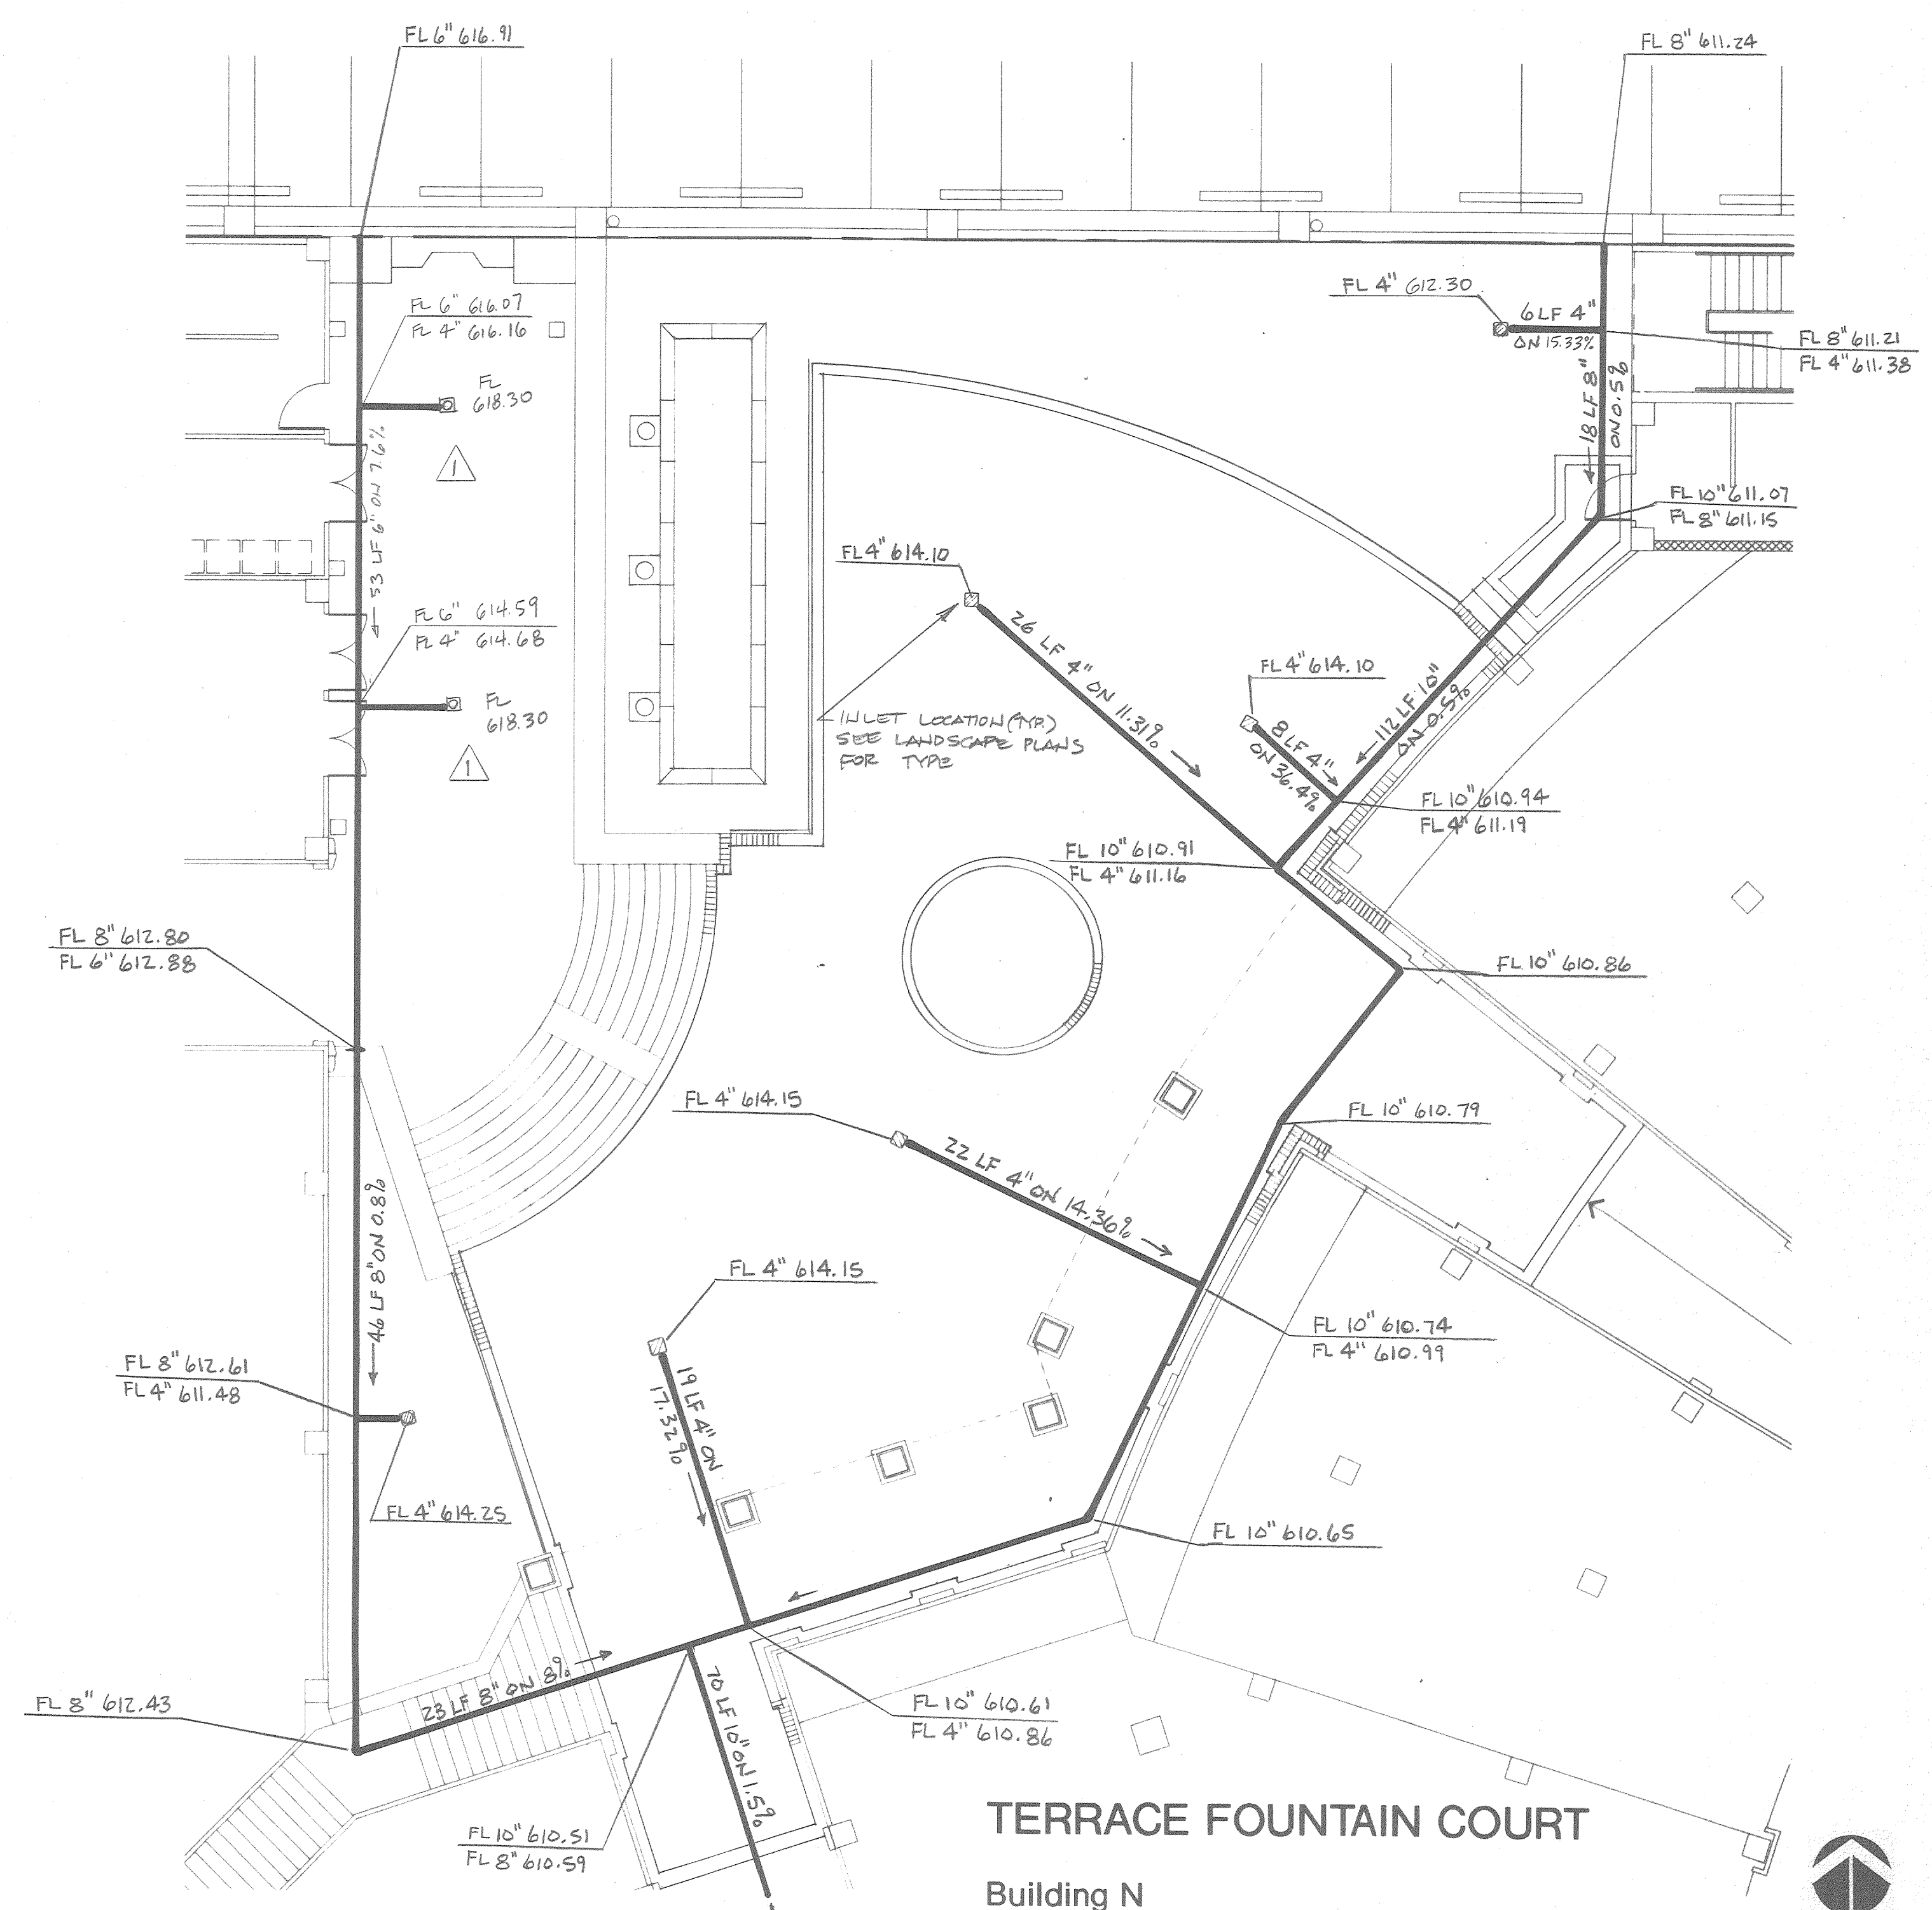

SEE SHEET D4 FOR CONTINUATION OF ROOF DRAINAGE DESIGN

TERRACE FOUNTAIN COURT
 Building N


ADDISON CIRCLE
 PHASE II

Landscape Architect
HUITT ZOLIARS, INC.
 3131 McKinney Avenue
 Suite 600
 Dallas, Texas 75204
 (214) 871-3311

Owner / Developer
COLUMBUS REALTY TRUST
 19851 Dallas Parkway
 Suite 855 LB5
 Dallas, Texas 75248
 (972) 387-1482

HUITT ZOLIARS

3131 McKinney Avenue, Suite 600
 Dallas, Texas 75204-2489
 Phone (214) 871-3311
 Fax (214) 871-0757

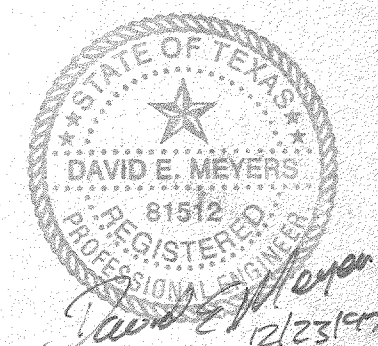

Revisions

No	Date	Items
△		
△		
△		
△		
△	1/6/98	ADDED DRAINS

Drawn: _____
 Appr: _____
 Scale: 1/8" = 1'-0"
 Date: DEC. 23, 1997
 Project No.: 01-1822-30