


NOTES:

- SEE LANDSCAPE PLANS FOR FINAL COURTYARD GRADES AND DRAIN TYPES.
- SEE OVERALL BUILDING DRAINAGE PLAN FOR GENERAL NOTES AND CONNECTION DETAIL.

BENCHMARKS:

BM#1
 "I" CUT AT CENTER BACK OF CURB OF INLET, 190 FEET SOUTH FROM THE CENTERLINE INTERSECTION OF ADDISON CIRCLE, WEST SIDE OF QUORUM DRIVE.
 ELEV. 621.89

BM#4
 "I" CUT AT CENTER OF CURB INLET, 1015 FEET NORTH FROM THE CENTERLINE INTERSECTION OF ADDISON CIRCLE, WEST SIDE OF QUORUM DRIVE.
 ELEV. 629.36

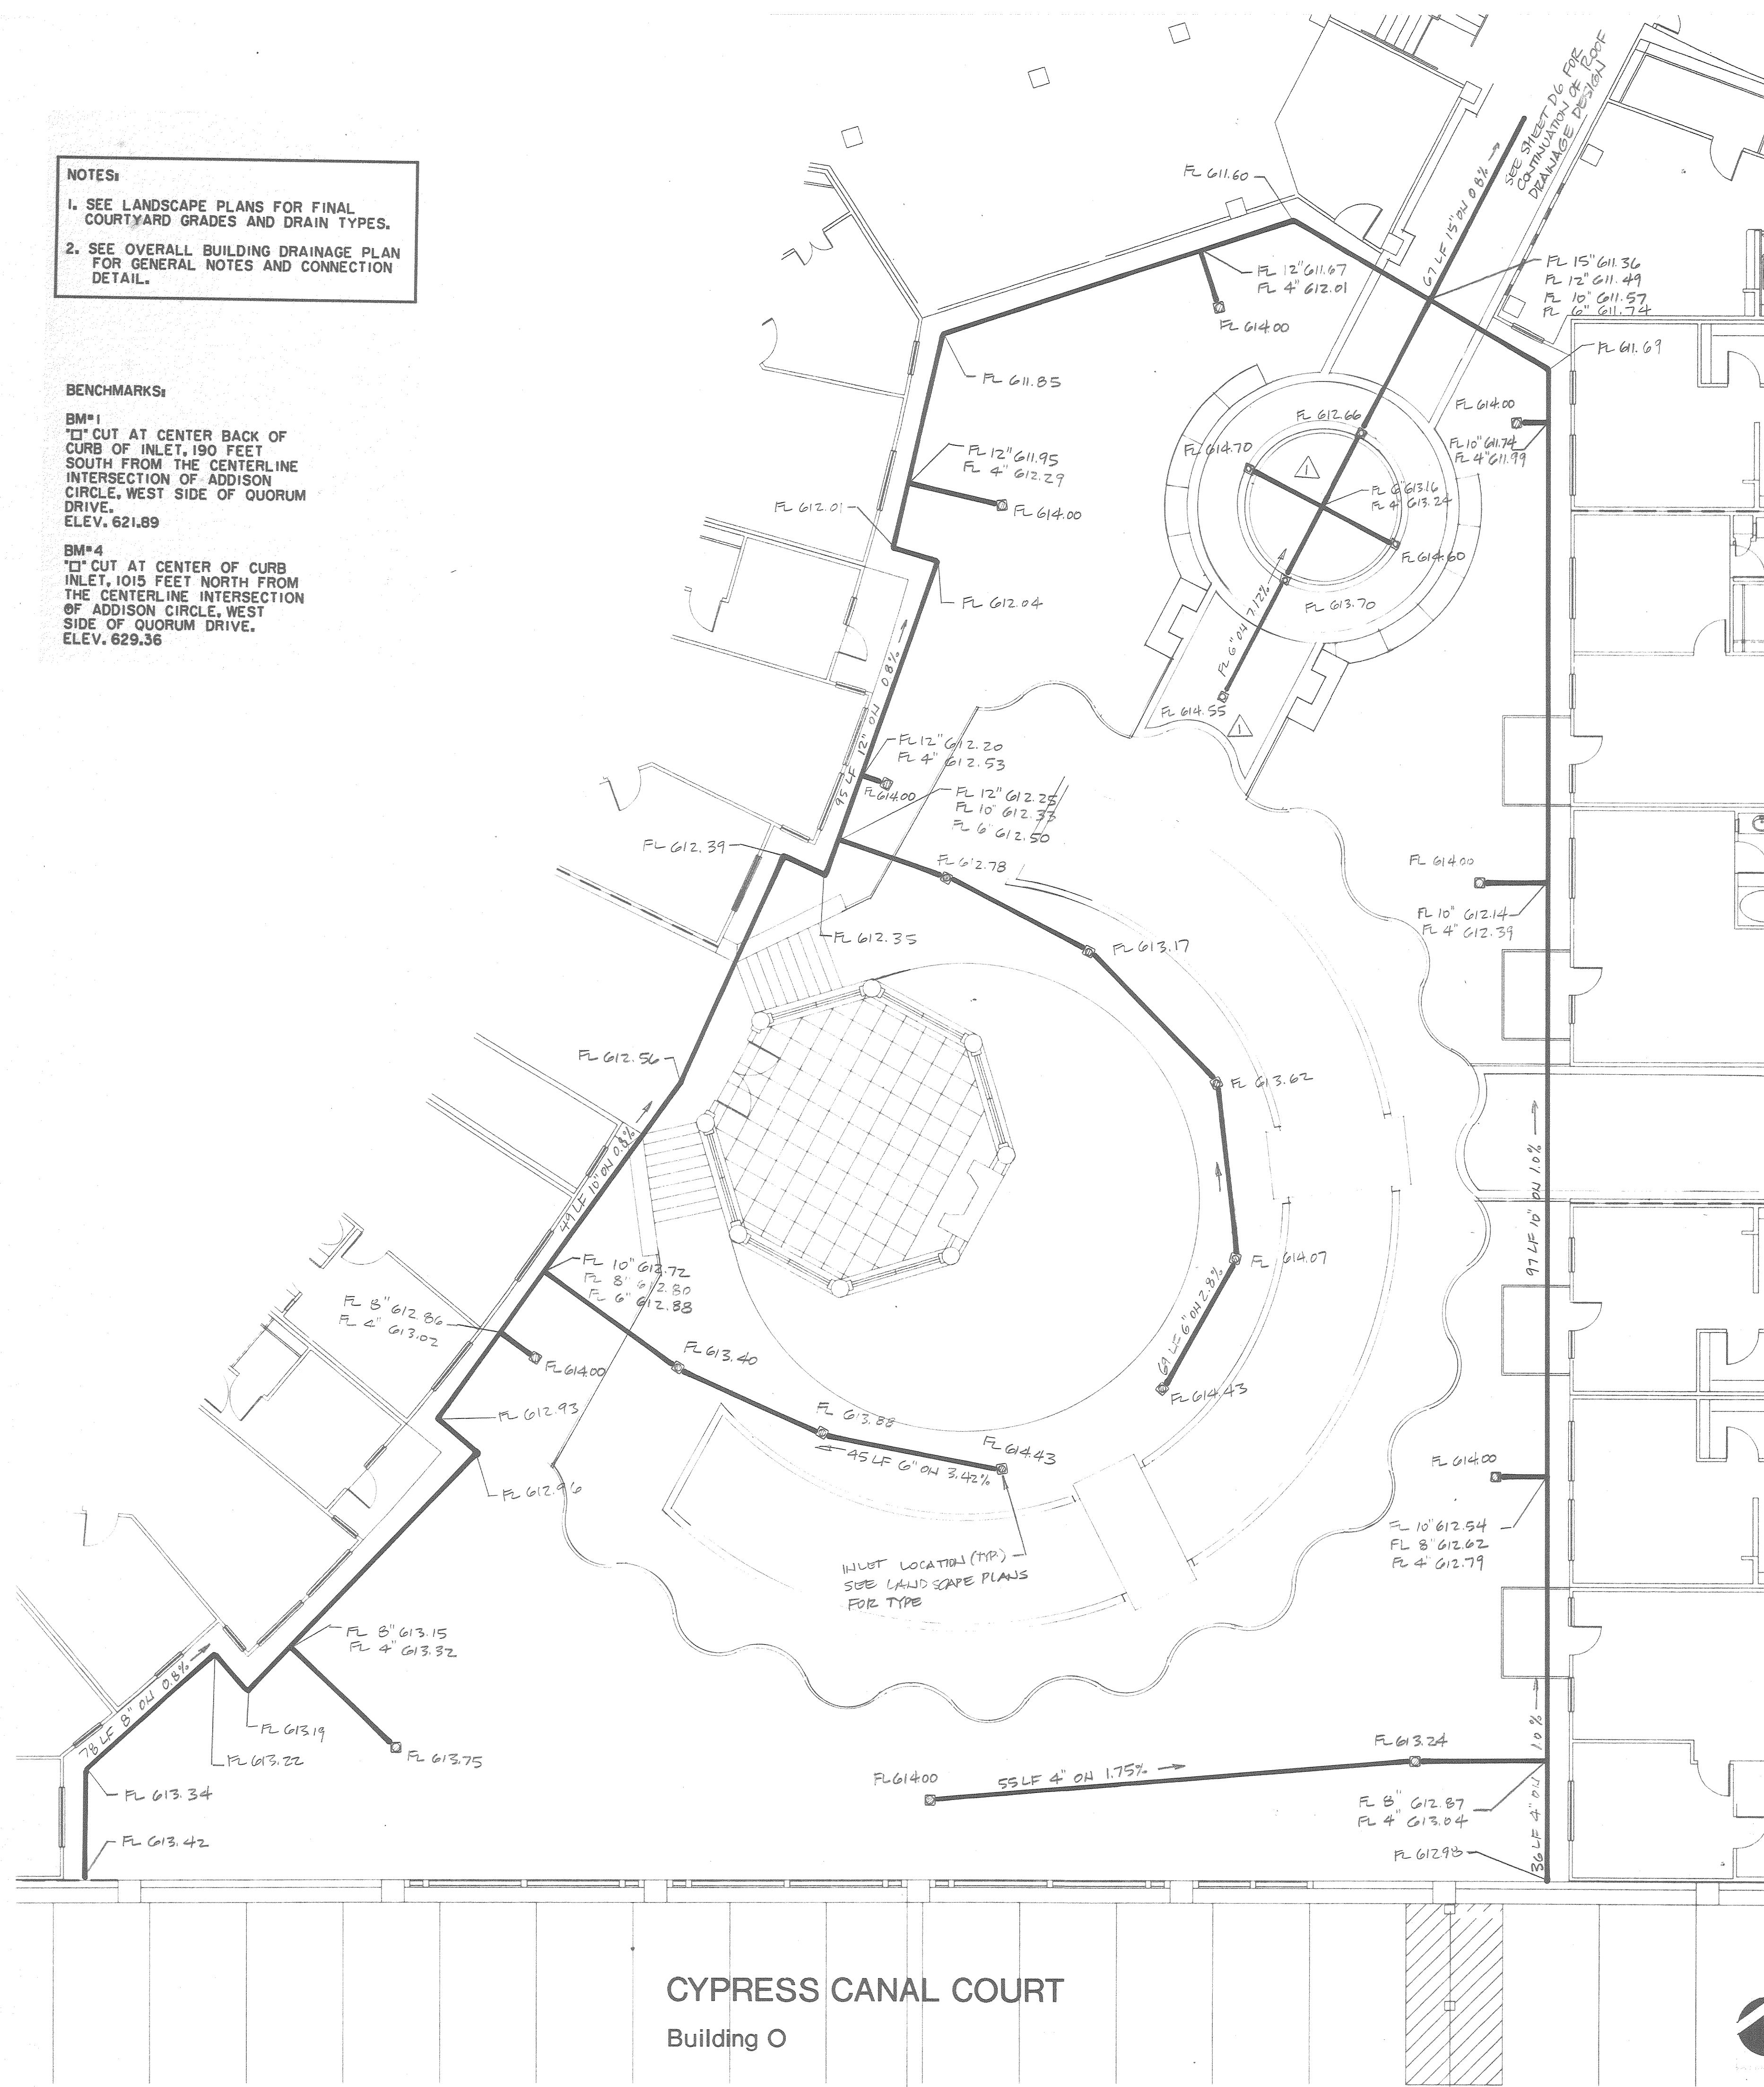

CYPRESS CANAL COURT
 Building O

ADDISON CIRCLE
 PHASE II

Landscaping Architect
HUITT ZOLIARS, INC.
 3131 McKinney Avenue
 Suite 600
 Dallas, Texas 75204
 (214) 871-3311

Owner / Developer
COLUMBUS REALTY TRUST
 15851 Dallas Parkway
 Suite 855 LB
 Dallas, Texas 75248
 (972) 387-1462

HUITT ZOLIARS

3131 McKinney Avenue, Suite 600
 Dallas, Texas 75204-2489
 Phone (214) 871-3311
 Fax (214) 871-0757



Revisions	No.	Date	Items
△			
△			
△			
△			
△	1/6/98		ADDED DRAINS

Drawn: _____
 Appr: _____
 Scale: 1/8"=1'-0"
 Date: DEC. 23, 1997
 Project No.: 01-1822-30

Sheet Title: **D7**