


- NOTES:**
- SEE DRAINAGE AREA MAP FOR DRAINAGE AREAS AND RUNOFF CALCULATIONS.
 - SEE ROUGH GRADING PLAN FOR DETAILED LOT GRADING.
 - STABILIZED CONSTRUCTION ENTRANCES WILL BE REQUIRED UNTIL MORRIS AVE. AND ADDISON CIRCLE ARE CONSTRUCTED.
 - CONCURRENT CONSTRUCTION OF APARTMENT DEVELOPMENT WITHIN AND ADJACENT TO THIS PROJECT MAY REQUIRE MODIFICATION OF EROSION CONTROL MEASURES. CONTRACTOR SHALL COORDINATE WITH PUBLIC CONTRACTOR FOR A PRACTICAL AND USEFUL SYSTEM TO CONTROL EROSION AND SILTATION FROM BOTH PROJECTS.
 - TEMPORARY STRAW BALE DIKS WILL BE REQUIRED AROUND ALL AREA DRAINS WITHIN BUILDING COURTYARDS.
 - PROVIDE STABILIZED CONSTRUCTION ENTRANCES TO ALL DISTURBED SITE AREAS THAT ACCESS THE PUBLIC STREETS.

- LEGEND:**
- SILT FENCE
 - INLET PROTECTION
 - - - - EXISTING CONTOURS
 - DIRECTION OF RUNOFF
 - - - - LIMITS OF DISTURBANCE
 - ▨ STABILIZED CONSTRUCTION ENTRANCE/EXIT

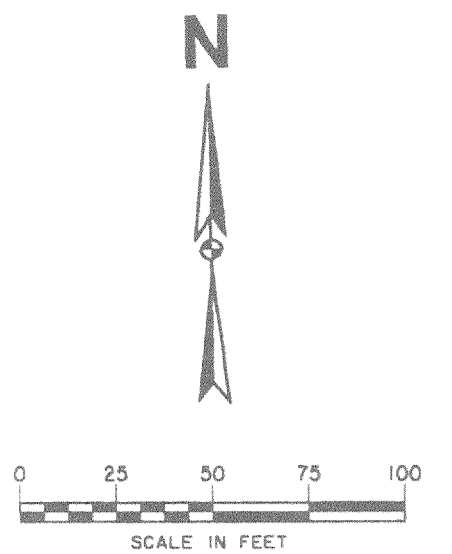

THE SEAL APPEARING ON THIS DOCUMENT WAS AUTHORIZED BY DAVID E. MEYERS, P.E. 81512 ON 2/16/98



SEE ADDISON CIRCLE PHASE II MASS GRADING PLAN SET FOR INITIAL POLLUTION CONTROL PLAN. MANY OF THE MEASURES SHOWN ON THIS PLAN MAY ONLY INVOLVE MAINTENANCE OF EXISTING EROSION AND SILTATION CONTROLS.

TOTAL AREA OF DISTURBANCE 10.134 ACRES

H:\PROJ\01182230\00\AC2PECOI.DGN, 1:45
 B:\CP2000.DWG, 5:41:11.33.32, 30.43, 52.34, 81
 U:\PROJ\01182230\00\AC2PECOI.DGN, 1:50:38.23, 45.1, 55.07, 29.99
 T2:\PROJ\01182230\00\AC2PECOI.DGN, 1:24:45

DATE	DESCRIPTION	REF. NO.
3/6/98	ADDED NOTE 6	▲
7/15/97	ISSUED FOR CONSTRUCTION	N/A
6/4/97	CITY SUBMITTAL	N/A

POLLUTION CONTROL PLAN						
ADDISON CIRCLE APARTMENTS						
PHASE II PRIVATE						
TOWN OF ADDISON, TEXAS						
Huitt-Zollars, Inc./Engineering/Architecture Dallas, Fort Worth, Houston, El Paso, Phoenix, Austin, Ontario						
DESIGN	DRAWN	APPR.	SCALE	DATE	PROJECT NO.	NO.
HZI	HZI	DEM	1"=50'	JULY 97	1822-30	PCI