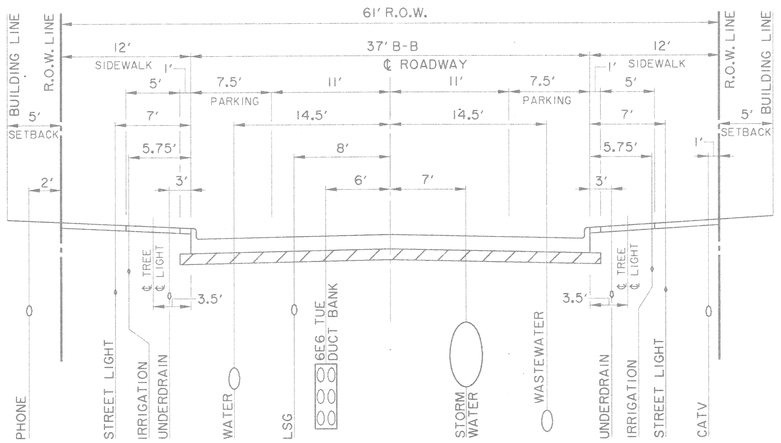

MORRIS AVENUE ⚠1

(LOOKING EAST)

NOTE:

THE PRECISE FINAL LOCATIONS OF ALL UTILITIES ARE ESTABLISHED IN PLAN VIEW. LOCATIONS ON THIS PLAN ARE GIVEN AS A GUIDE AND TO INDICATE ALLOCATION OF SPACE.

⚠1 PHONE TO BE INSTALLED BY ADDISON CIRCLE ACCESS LTD.

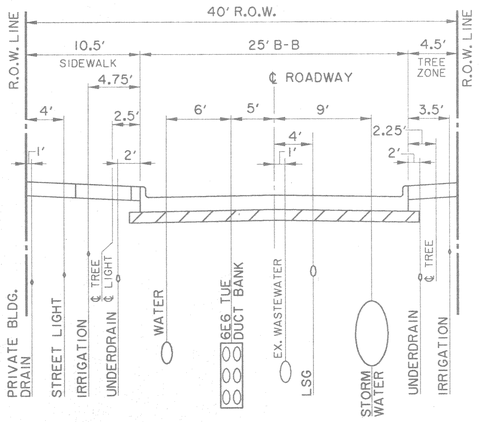

McENTIRE PLACE ⚠1

(LOOKING EAST)

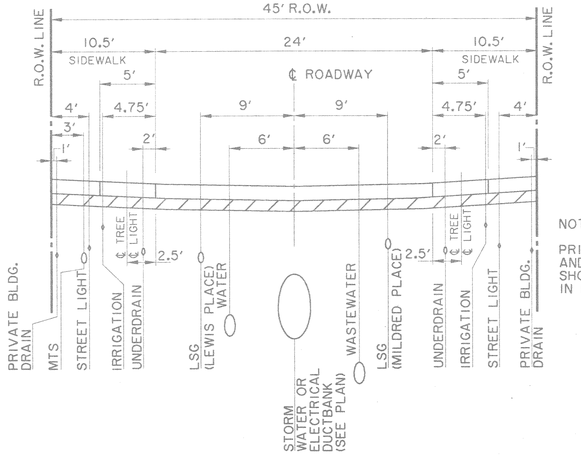

MILDRED PLACE & LEWIS PLACE ⚠1

(LOOKING NORTH)

NOTE:

PRIVATE COMMUNICATION AND ELECTRICAL LINES SHOULD NOT BE PLACED IN MEWS STREETS.

THE SEAL APPEARING ON THIS DOCUMENT WAS AUTHORIZED BY DAVID E. MEYERS, P.E. 81512 ON 2/19/98

STATE OF TEXAS
DAVID E. MEYERS
81512
REGISTERED
PROFESSIONAL ENGINEER
2/19/98

DATE	DESCRIPTION	REF NO.
2/19/98	REVISED PHONE AND GAS	⚠1
7/15/97	ISSUED FOR CONSTRUCTION	N/A
6/4/97	CITY SUBMITTAL	N/A

TYPICAL UTILITY LOCATIONS

ADDISON CIRCLE APARTMENTS

PHASE II PRIVATE

TOWN OF ADDISON, TEXAS

Huitt-Zollars, Inc./Engineering/Architecture
Dallas, Fort Worth, Houston, El Paso, Phoenix, Tustin, Ontario

DESIGN	DRAWN	APPR.	SCALE	DATE	PROJECT NO.	NO.
HZI	HZI	DEM	N.T.S.	JULY 97	1822-30	M3

h:\proj\01182230\dgn\AC2PUT02.DGN

PRF ROTATION=0.000000
h:\proj\01182230\dgn\AC2PUT02.DGN
Tue May 13 08:21 1998
F:\PLOTTING\400V\ac2put02.prf
mamag
F:\GIS\MILLER.TBL
B_EXTENSION, 4, 0, 0.0, 0.0, 0.0
*no ref layouts, *no ref names, *no ref levels
*no ref layouts, *no ref names, *no ref levels
*no ref layouts, *no ref names, *no ref levels
*no ref layouts, *no ref names, *no ref levels
*no ref layouts, *no ref names, *no ref levels
*no ref layouts, *no ref names, *no ref levels