


**RECORD  
DRAWING**

THE SEAL APPEARING ON THIS DOCUMENT WAS AUTHORIZED BY DAVID E. MEYERS, P.E. 81512

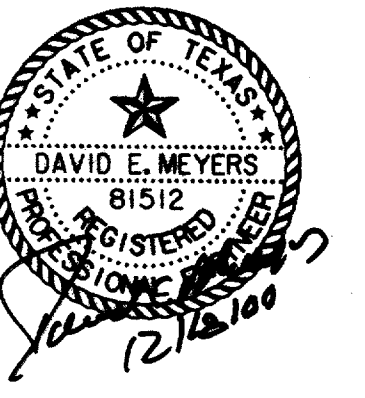

DATE	DESCRIPTION	REF. NO.				
10/3/97	ISSUED FOR CONSTRUCTION	N/A				
7/14/97	ISSUED FOR BID	N/A				
<b>ELECTRICAL DUCTBANK SITE PLAN</b>						
<b>ADDISON CIRCLE</b>						
<b>PHASE II PUBLIC INFRASTRUCTURE</b>						
<b>TOWN OF ADDISON, TEXAS</b>						
Huitt-Zollars, Inc./Engineering/Architecture Dallas, Fort Worth, Houston, El Paso, Phoenix, Tustin, Ontario						
DESIGN	DRAWN	APPR.	SCALE	DATE	PROJECT NO.	NO.
HZI	HZI	DEM	1"=50'	JUN. 97	01-1822-21	EI