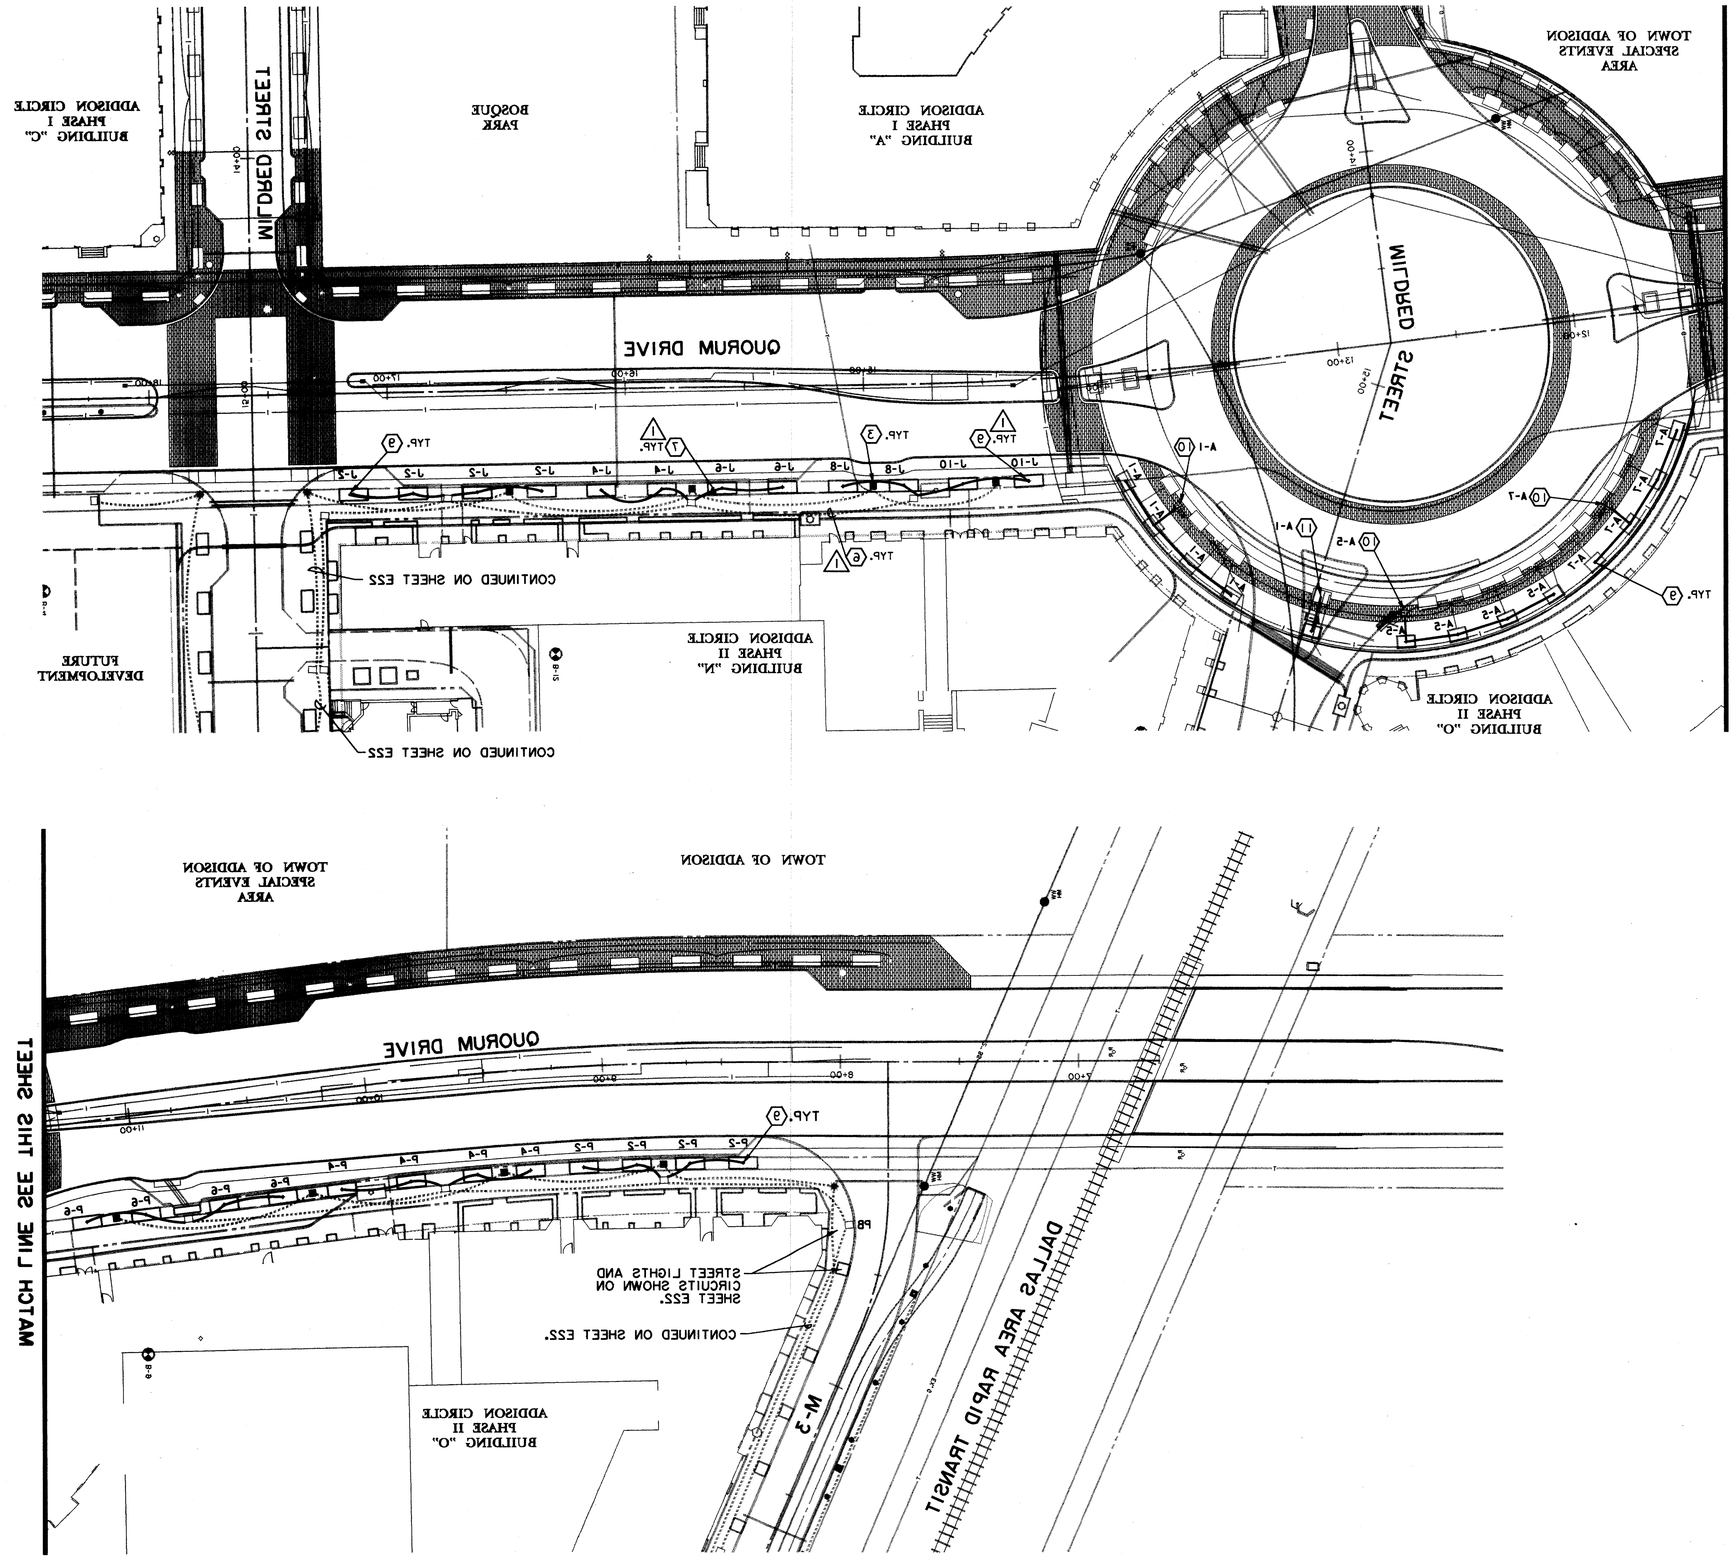

RECORD
DRAWING

DATE	DESCRIPTION	REV NO.
2/25/98	CIRCUIT REVISIONS	N/A
10/23/97	ISSUED FOR CONSTRUCTION	N/A
7/14/97	ISSUED FOR BID	N/A

TREE LIGHTING POWER PLAN

ADDISON CIRCLE

PHASE II PUBLIC INFRASTRUCTURE

TOWN OF ADDISON, TEXAS

Huitt-Zollars, Inc./Engineering/Architecture
Dallas, Fort Worth, Houston, El Paso, Phoenix, Austin, Ontario

DESIGN	DRAWN	APPR.	SCALE	DATE	PROJECT NO.	NO.
HZI	HZI	GWI	1"=30'	OCT. 97	01-1022-25	E23