


AREA OF DISTURBANCE
7.7 ACRES

- NOTES:
1. SEE DRAINAGE AREA MAP FOR DRAINAGE AREAS AND CALCULATIONS.
 2. SEE POLLUTION CONTROL DETAILS FOR TYPES OF INLET PROTECTION.

- LEGEND:
- SILT FENCE
 - INLET PROTECTION
 - EXISTING CONTOURS
 - DIRECTION OF RUNOFF
 - - - - LIMITS OF DISTURBANCE
 - ▨ STABILIZED CONSTRUCTION ENTRANCE/EXIT

RECORD
DRAWING

THE SEAL APPEARING ON THIS DOCUMENT WAS AUTHORIZED BY DAVID E. MEYERS, P.E. 81512

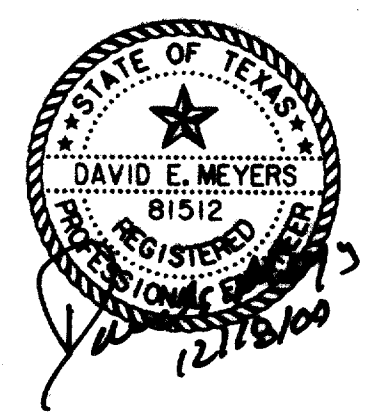

DATE	DESCRIPTION	REF. NO.
10/3/97	ISSUED FOR CONSTRUCTION	N/A
7/14/97	ISSUED FOR BID	N/A

POLLUTION CONTROL PLAN						
ADDISON CIRCLE						
PHASE II PUBLIC INFRASTRUCTURE						
TOWN OF ADDISON, TEXAS						
Huitt-Zollars, Inc./Engineering/Architecture Dallas, Fort Worth, Houston, El Paso, Phoenix, Tustin, Ontario						
DESIGN	DRAWN	APPR.	SCALE	DATE	PROJECT NO.	NO.
HZI	HZI	DEM	1"=50'	JUN. 97	01-1822-21	PCI