



15 - 5" OR 6"  
TERMINATOR INSTALLATION  
IN MANHOLES

SEE JOB SKETCH FOR  
NUMBER OF TERMINATORS  
TO BE INSTALLED

DETAIL # ⑧

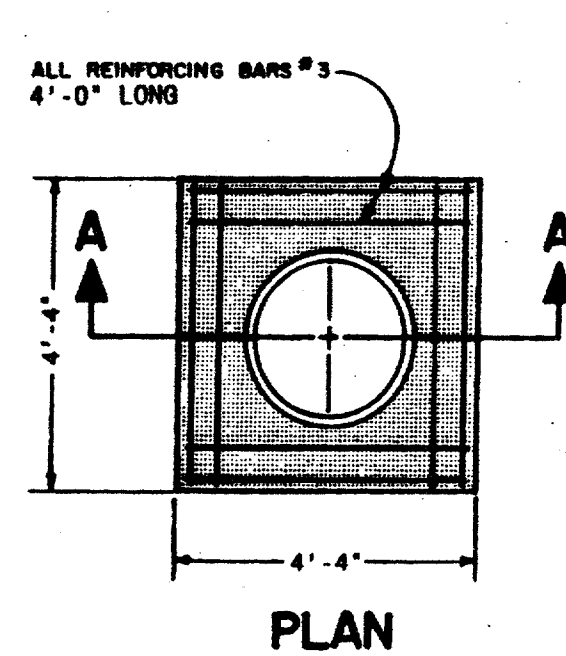


PLAN

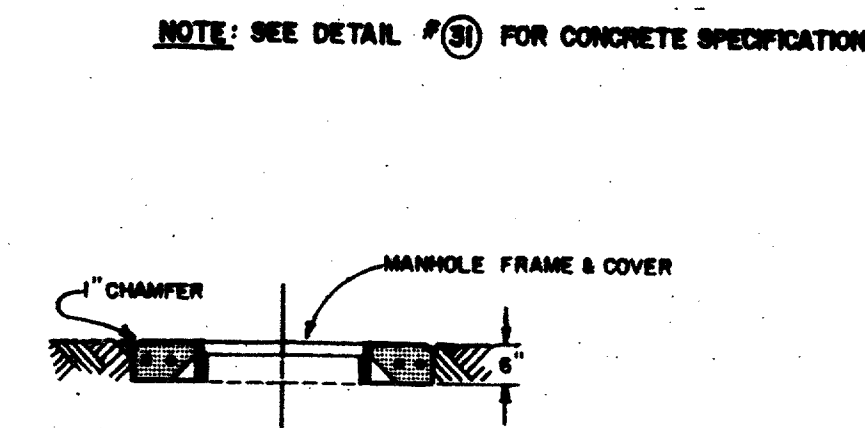

SECTION A-A







— CONCRETE SLAB FOR MANHOLE—  
CASTING

DETAIL # ⑪




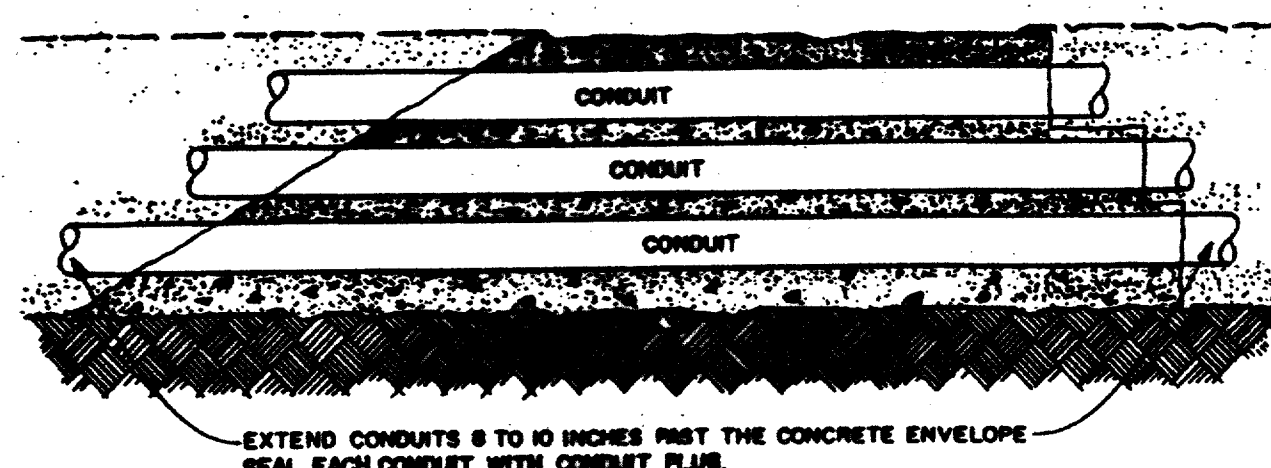


—SLOPED AND STAIR STEPPED—  
COLD JOINTS

DETAIL # ⑫

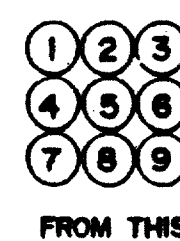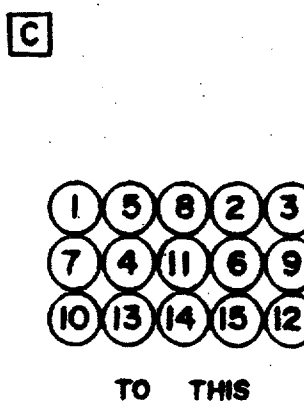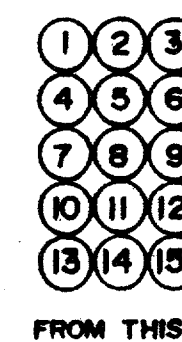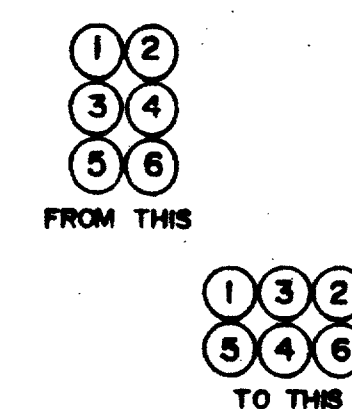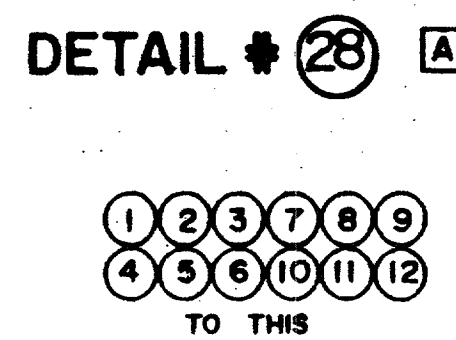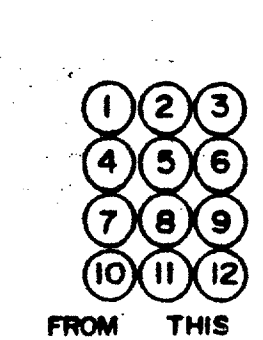

CONDUIT TRANSITION DETAILS

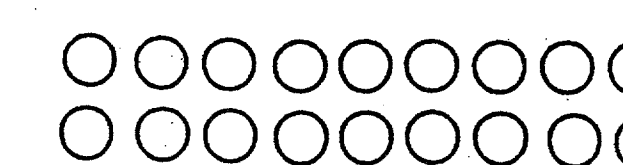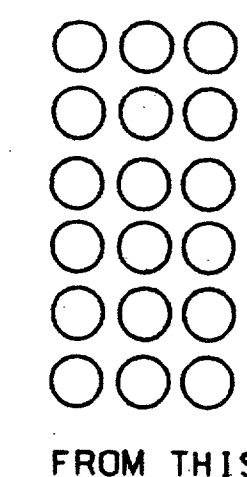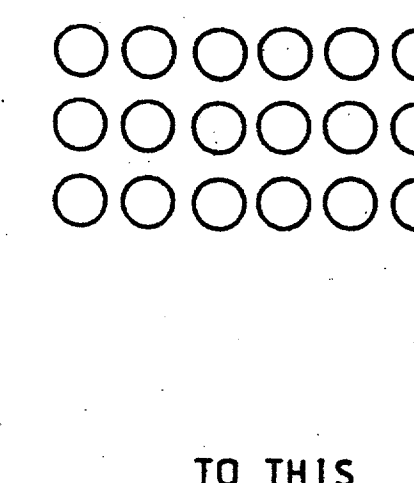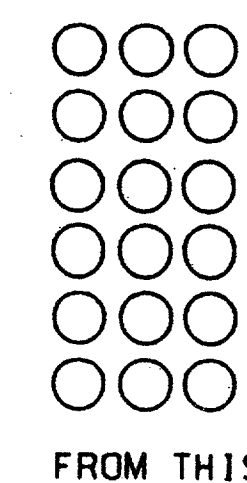

RECORD  
DRAWING

10/3/97 ISSUED FOR CONSTRUCTION

E17

TU ELECTRIC		CD	
DATE 05-12-92	DWN. MED	CH. JRC	ENG. JRC
APP. JES	APP. PRN	W.A.	W.A.
NO.	DATE	REVISION DESCRIPTION	DRAWN CH. APP. APP.
ESTIMATE	DWG TYPE	UNIT ID	
NETWORK UNDERGROUND APPURTENANCE SHEETS MISCELLANEOUS DETAILS			
SCALE (H&D SCALE) (V&D SCALE)	LIST OF DRAWINGS		
E-NUA-1 SHEET NO. 6			