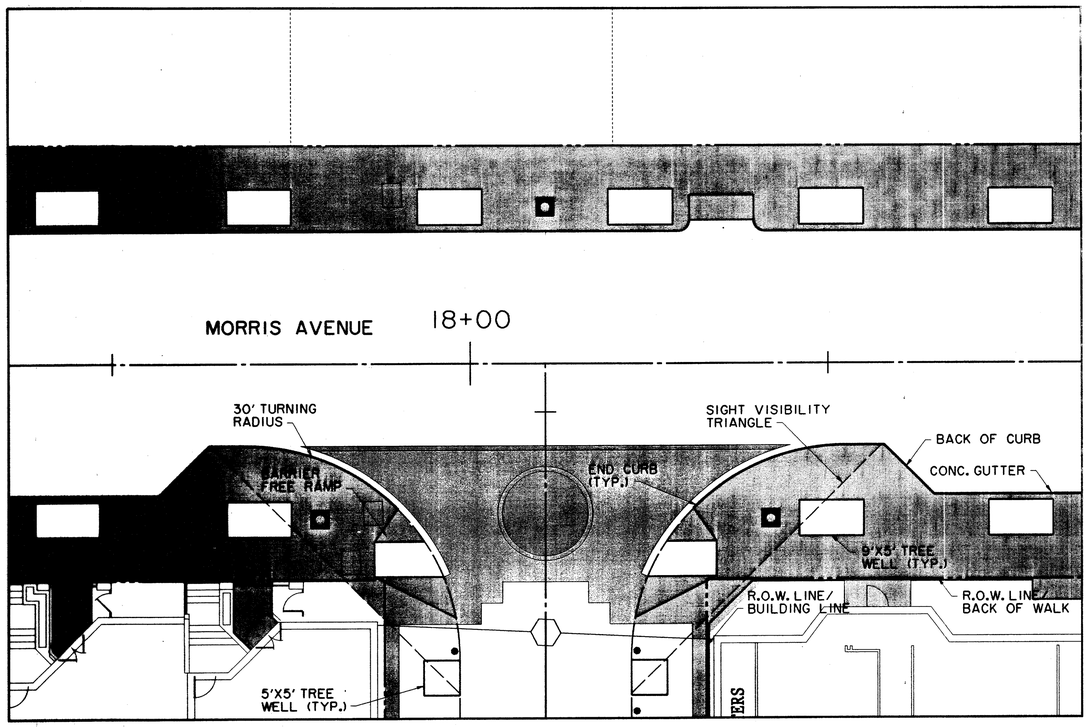

TYPICAL STREET INTERSECTION BRICK PLAN

MORRIS AVENUE / M-2 NORTH
ADDISON CIRCLE / M-2 NORTH
ADDISON CIRCLE / M-2 SOUTH
M-3 / M-2 SOUTH

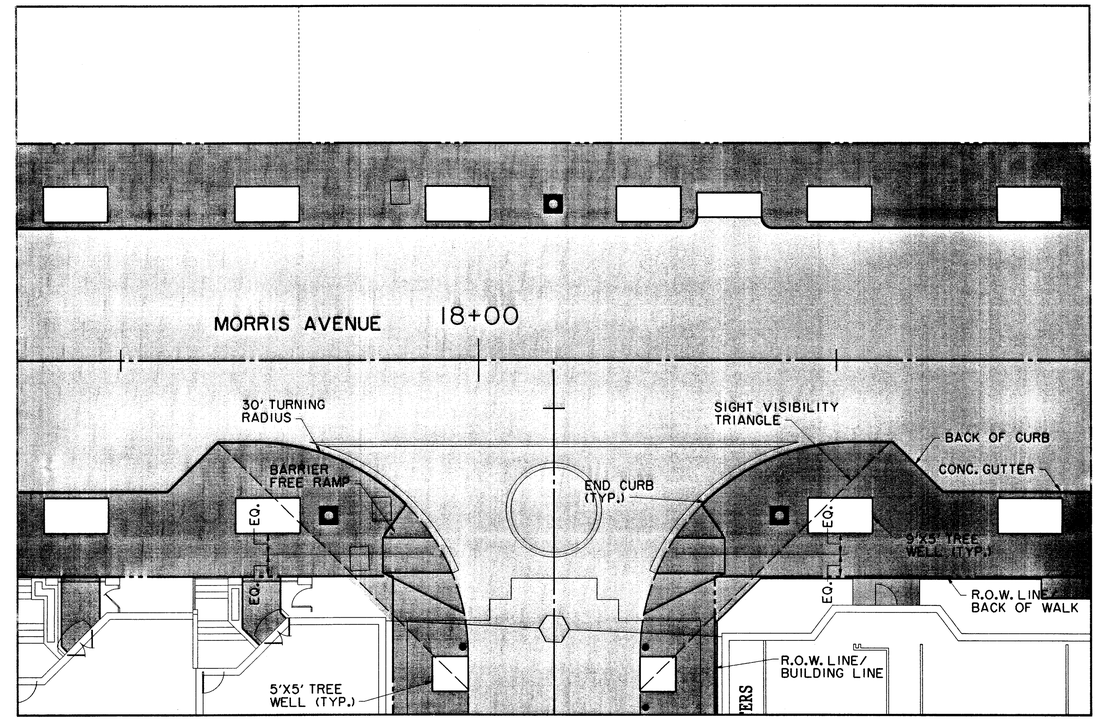

TYPICAL STREET INTERSECTION PAVEMENT PLAN

MORRIS AVENUE / M-2 NORTH
ADDISON CIRCLE / M-2 NORTH
ADDISON CIRCLE / M-2 SOUTH
M-3 / M-2 SOUTH

N

0 5 10 15 20
SCALE IN FEET

THE SEAL APPEARING ON THIS DOCUMENT WAS AUTHORIZED BY DAVID E. MEYERS, P.E. 81512

STATE OF TEXAS
DAVID E. MEYERS
81512
REGISTERED PROFESSIONAL ENGINEER

RECORD DRAWING

DATE	DESCRIPTION	REF NO.
10/3/97	ISSUED FOR CONSTRUCTION	N/A
7/14/97	ISSUED FOR BID	N/A

PAVING DETAILS

ADDISON CIRCLE

PHASE II PUBLIC INFRASTRUCTURE

TOWN OF ADDISON, TEXAS

Huitt-Zollars, Inc./Engineering/Architecture
Dallas, Fort Worth, Houston, El Paso, Phoenix, Tustin, Ontario

DESIGN	DRAWN	APPR.	SCALE	DATE	PROJECT NO.	NO.
HZI	HZI	DEM	1" = 10'	OCT. 97	01-1822-21	P23

h:\proj\01182221\dgn\AUC2TY01.DGN