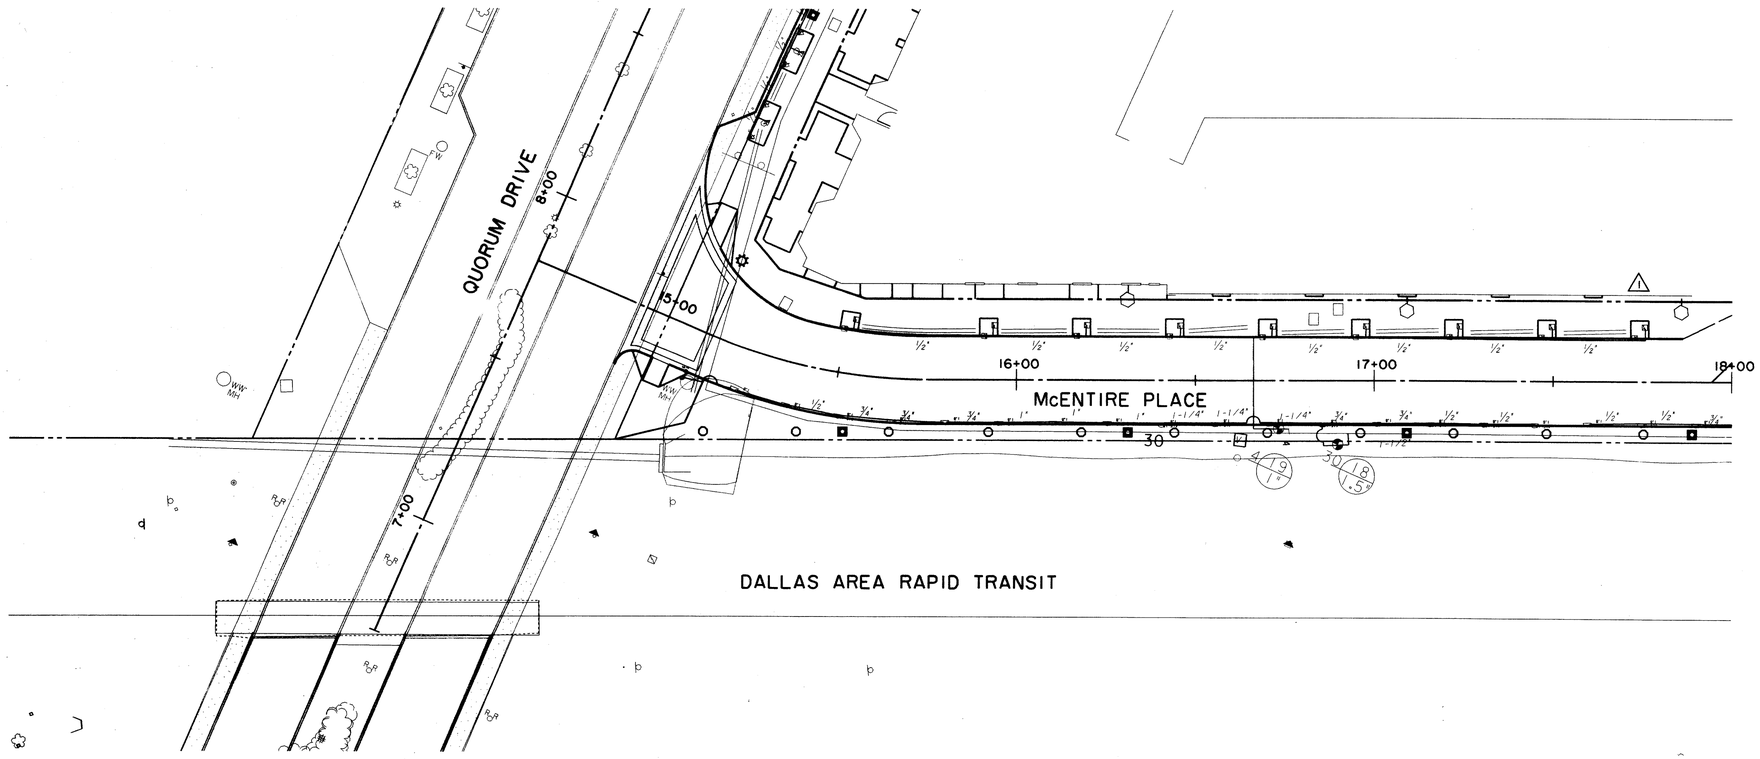

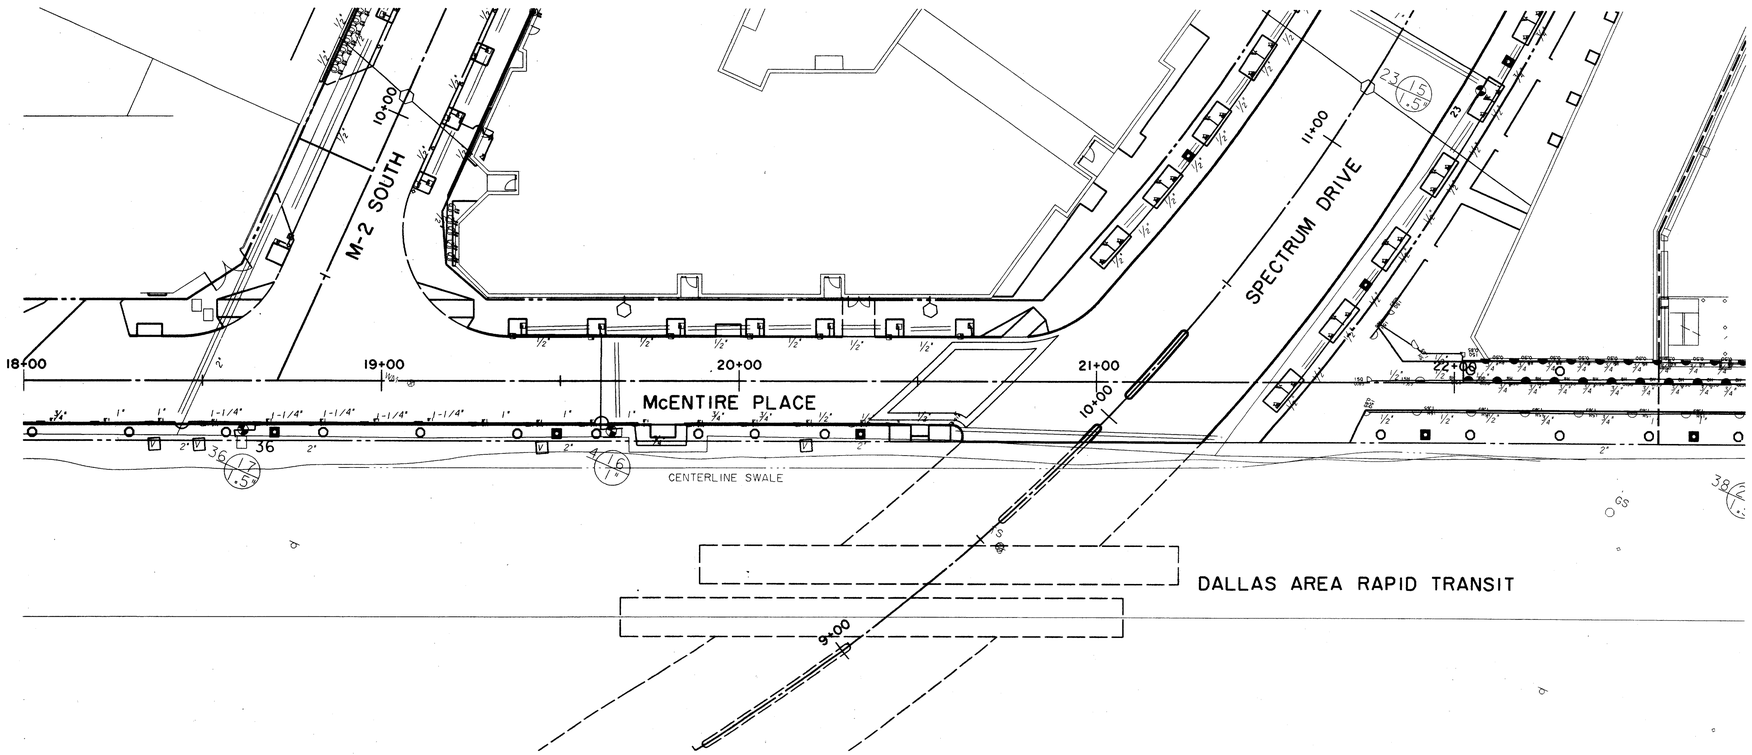

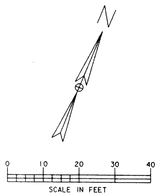

STATE OF TEXAS
STEPHEN C. BERKENBILE
REGISTERED IRRIGATOR

STEPHEN C BERKENBILE & ASSOCIATES
IRRIGATION DESIGN CONSULTANTS
411 HYDE PARK PLACE
DUNCANVILLE, TX 75137
(972) 296-2724
FAX (972) 780-0048

RECORD DRAWING

DATE	DESCRIPTION	REF NO.
12/15/97	ADDED TREE	1
10/3/97	ISSUED FOR CONSTRUCTION	N/A
7/14/97	ISSUED FOR BID	N/A

IRRIGATION PLAN
M-3

ADDISON CIRCLE
PHASE II PUBLIC INFRASTRUCTURE
TOWN OF ADDISON, TEXAS

Huitt-Zollars, Inc./Engineering/Architecture
Dallas, Fort Worth, Houston, El Paso, Phoenix, Tustin, Ontario

DESIGN	DRAWN	APPR.	SCALE	DATE	PROJECT NO.	NO.
HZI	HZI	SCB	1"=20'	OCT. 97	01-1822-21	IR8

h:\proj\01182221\dgn\AUC21IR08.DGN