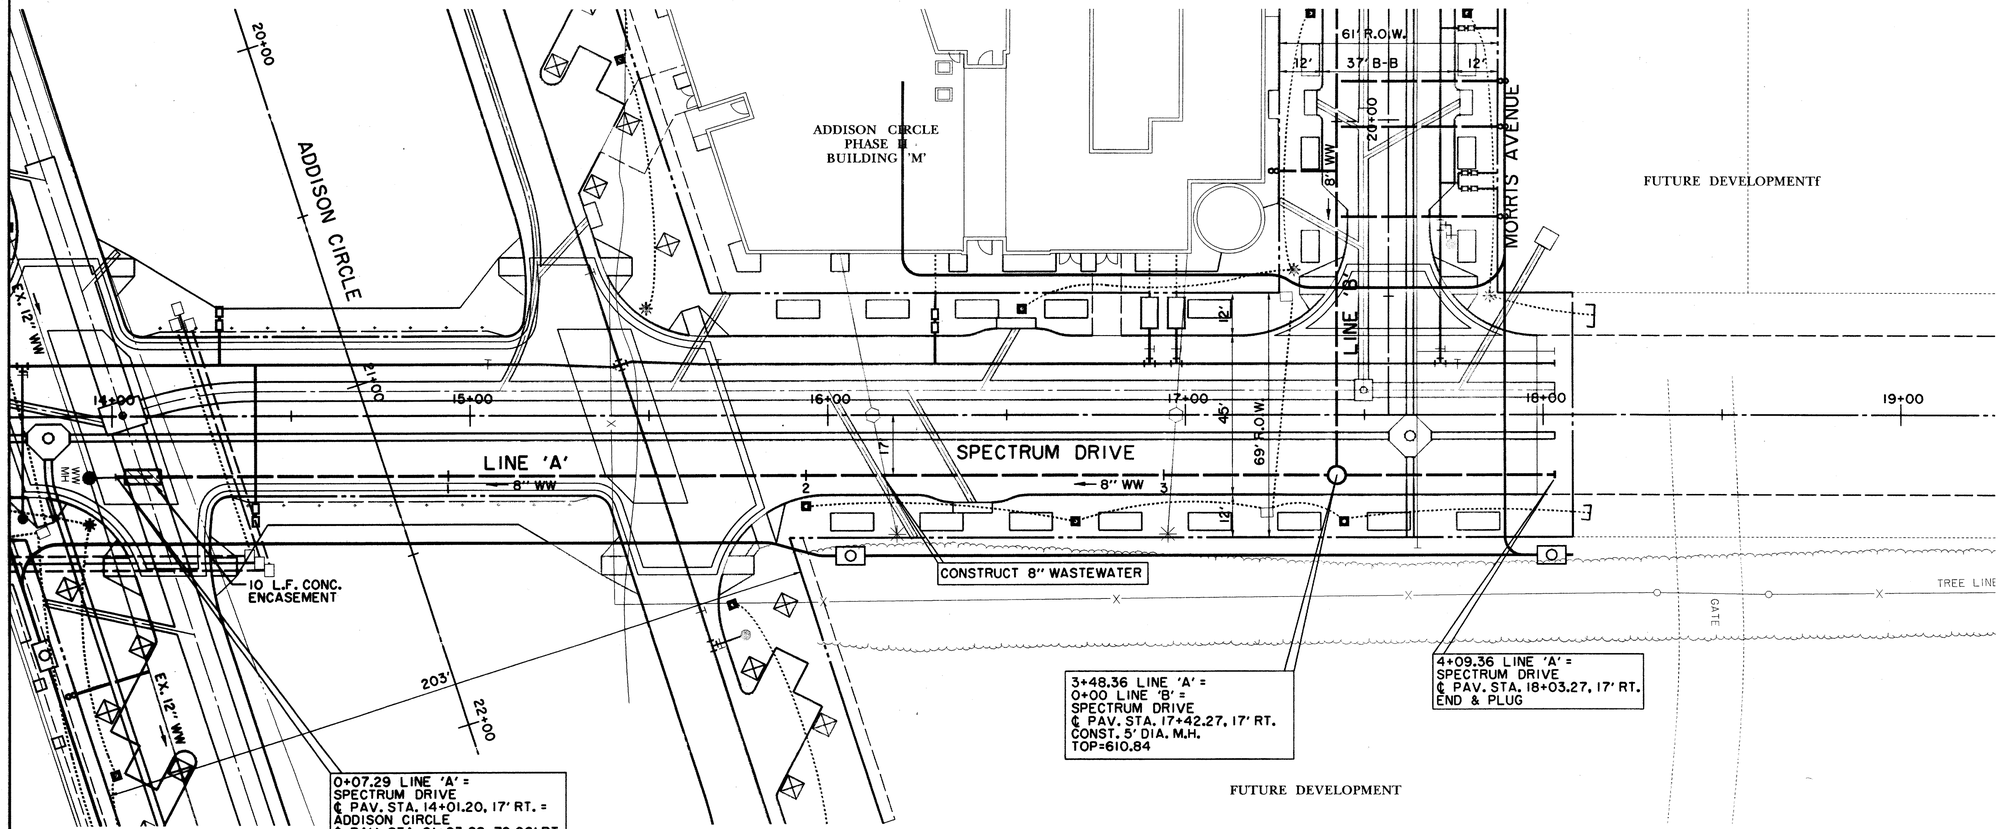

RECORD DRAWING

LEGEND

- ELECTRIC — OHE —
- LIGHT POLE
- POWER POLE
- GUY WIRE
- TELEPHONE — T —
- TELEPHONE MANHOLE
- TELEPHONE PEDESTAL
- TELEPHONE SIGN
- GAS — G —
- GAS METER
- GAS SIGN
- LAND USE
- RAILROAD SIGN
- SIGN
- SURVEY
- FOUND IRON ROD
- BENCHMARK
- WASTEWATER — WW —
- WASTEWATER MANHOLE
- CLEANOUT
- WATER — W —
- FIRE HYDRANT
- METER
- WATER VALVE
- MISC.
- 48" RCP — EX. STORM SEWER
- CHAIN LINK FENCE
- WOOD FENCE
- EXISTING ASPHALT
- EXISTING DIRT OR GRAVEL
- EX. CONCRETE
- TREE/TREE LINE
- EXISTING CURB
- PROP. CURB
- PROP. EDGE OF PAVEMENT NO CURB
- EX. PROPERTY LINE
- PROP. CENTERLINE
- PROP. R.O.W.
- PROP. INLET
- T.P. TOP OF PAVEMENT
- T.C. TOP OF CURB
- CR CURB RETURN
- EX. G EXISTING GUTTER
- EX. T.C. EXISTING TOP OF CURB
- B-20 BORING LOCATION
- EXISTING BRICKS
- PAVEMENT REMOVAL

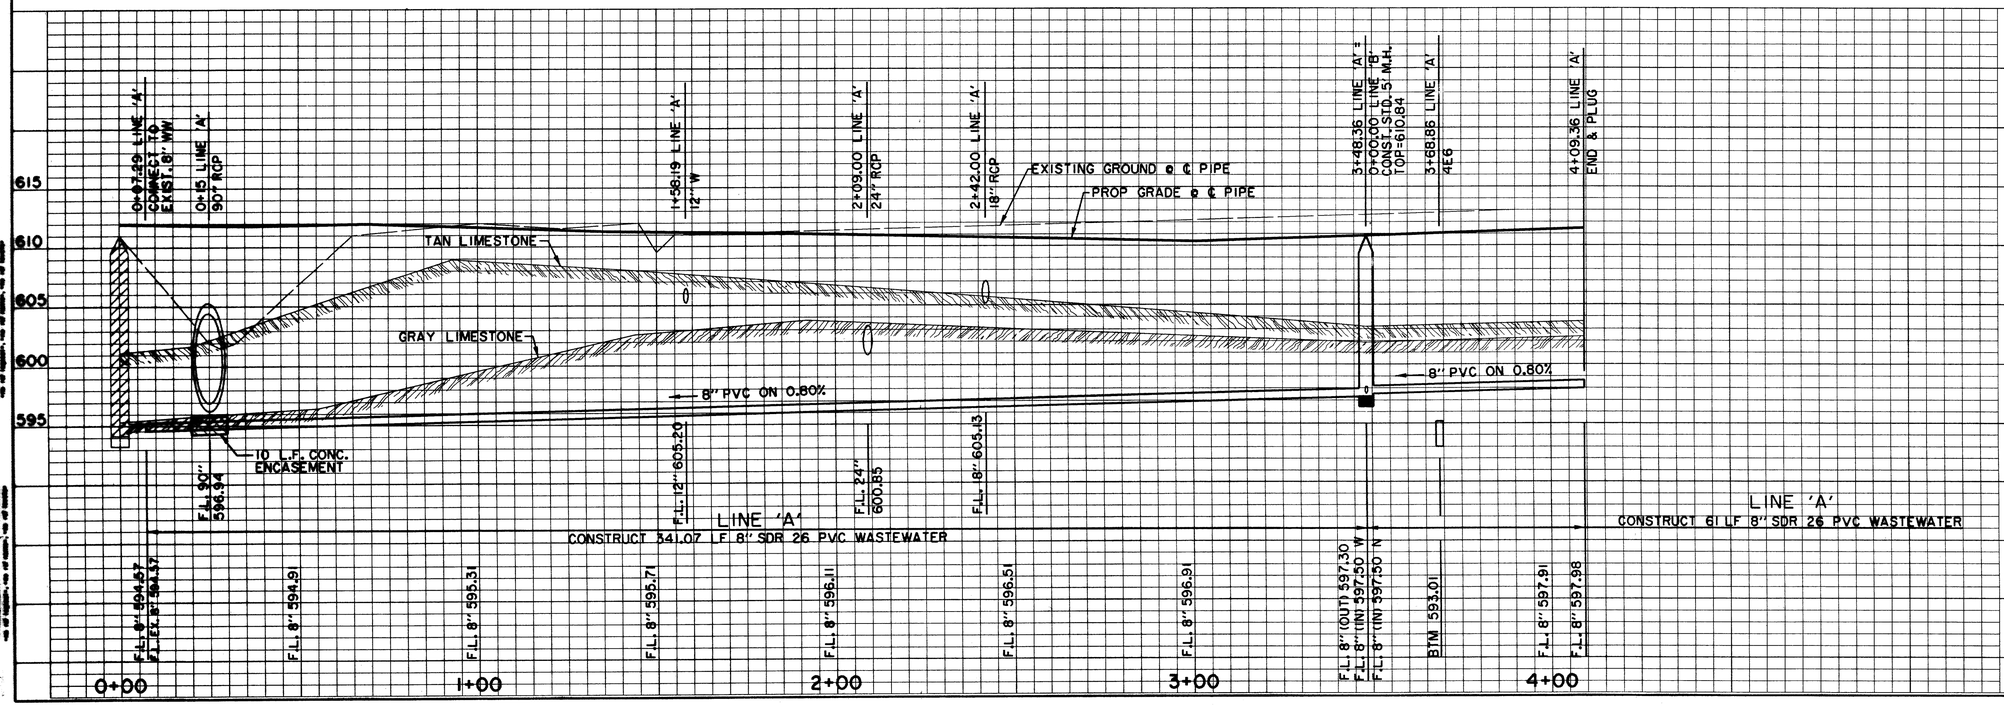

BENCHMARKS:

BM#1
"D" CUT AT CENTER BACK OF CURB OF INLET, 190 FEET SOUTH FROM THE CENTERLINE INTERSECTION OF MILDRED STREET, WEST SIDE OF QUORUM DRIVE.
ELEV. 621.89

BM#5
"D" CUT ON NORTHWEST CORNER OF CONC. HDWL. FOR 7'X7' BOX CULVERT UNDER R.R. TRACKS, 180 FEET WEST OF DALLAS PARKWAY SOUTHBOUND.
ELEV. 610.49

THE SEAL APPEARING ON THIS DOCUMENT WAS AUTHORIZED BY DAVID E. MEYERS, P.E. 81512

STATE OF TEXAS — DAVID E. MEYERS — 81512 — REGISTERED PROFESSIONAL ENGINEER — 12/19/00

DATE	DESCRIPTION	REF NO.
10/3/97	ISSUED FOR CONSTRUCTION	N/A
7/14/97	ISSUED FOR BID	N/A

WASTEWATER PLAN & PROFILE
LINE 'A' - STA. 0+00 TO STA. 3+55.86

ADDISON CIRCLE
PHASE II PUBLIC INFRASTRUCTURE
TOWN OF ADDISON, TEXAS

Huitt-Zollars, Inc./Engineering/Architecture
Dallas, Fort Worth, Houston, El Paso, Phoenix, Tustin, Ontario

DESIGN	DRAWN	APPR.	SCALE	DATE	PROJECT NO.	NO.
HZI	HZI	DEM	H: 1"=20' V: 1"=6'	OCT. 97	01-1822-21	WW1

h:\proj\01182221\dgn\AUC2WW03.DGN