



ACTJ HIKE & BIKE TRAIL B25-3

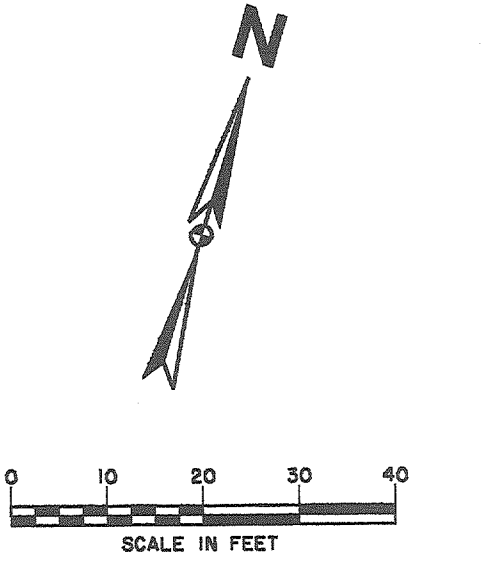


F SPECIAL DETAIL SEE SHEET SP9

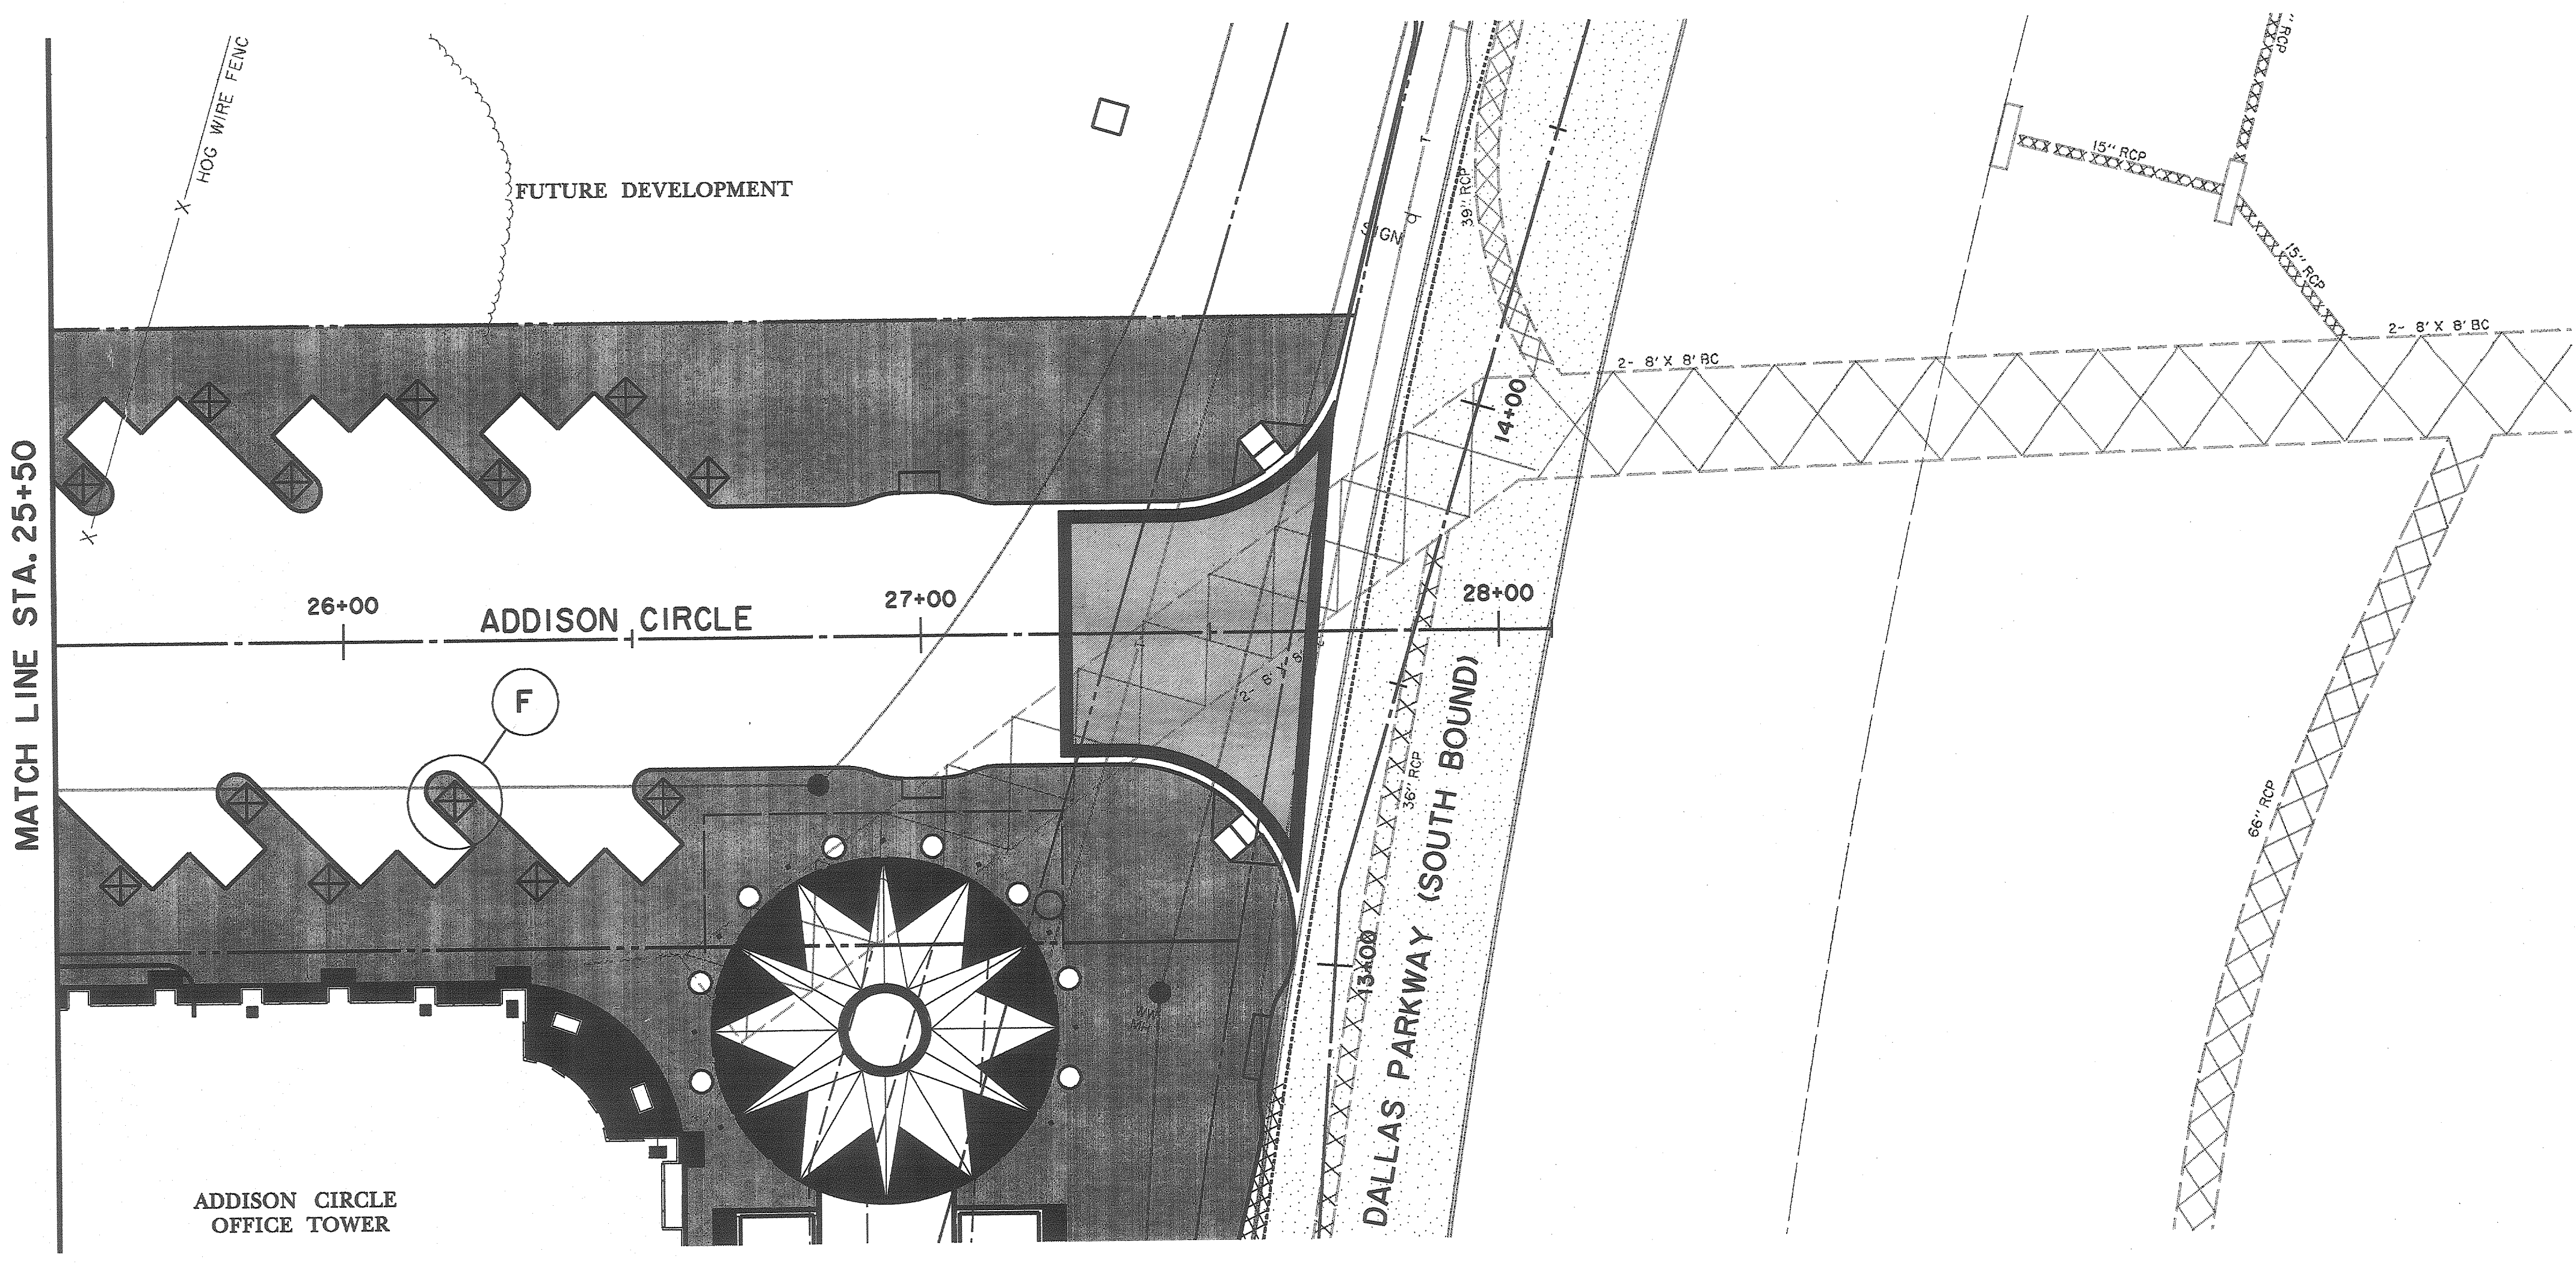

LEGEND

ELECTRIC — OHE	48" RCP	MISC.
⊙ LIGHT POLE	EX. STORM SEWER	
PP POWER POLE	CHAIN LINK FENCE	
— GUY WIRE	WOOD FENCE	
TELEPHONE — T	EXISTING ASPHALT	
TELEPHONE MANHOLE	EXISTING DIRT OR GRAVEL	
TELEPHONE PEDESTAL	EX. CONCRETE	
TELEPHONE SIGN	TREE/TREE LINE	
GAS — G	EXISTING CURB	
GAS METER	PROP. CURB	
GAS SIGN	PROP. EDGE OF PAVEMENT NO CURB	
LAND USE	EX. PROPERTY LINE	
RAILROAD SIGN	PROP. CENTERLINE	
SIGN	PROP. R.O.W.	
SURVEY	PROP. INLET	
FOUND IRON ROD	T.P.	TOP OF PAVEMENT
BENCHMARK	T.C.	TOP OF CURB
WASTEWATER — WW	CR	CURB RETURN
WASTEWATER MANHOLE	EX. G	EXISTING GUTTER
CLEANOUT	EX. T.C.	EXISTING TOP OF CURB
WATER — W	B-20	BORING LOCATION
FIRE HYDRANT		EXISTING BRICKS
METER		PAVEMENT REMOVAL
WATER VALVE		

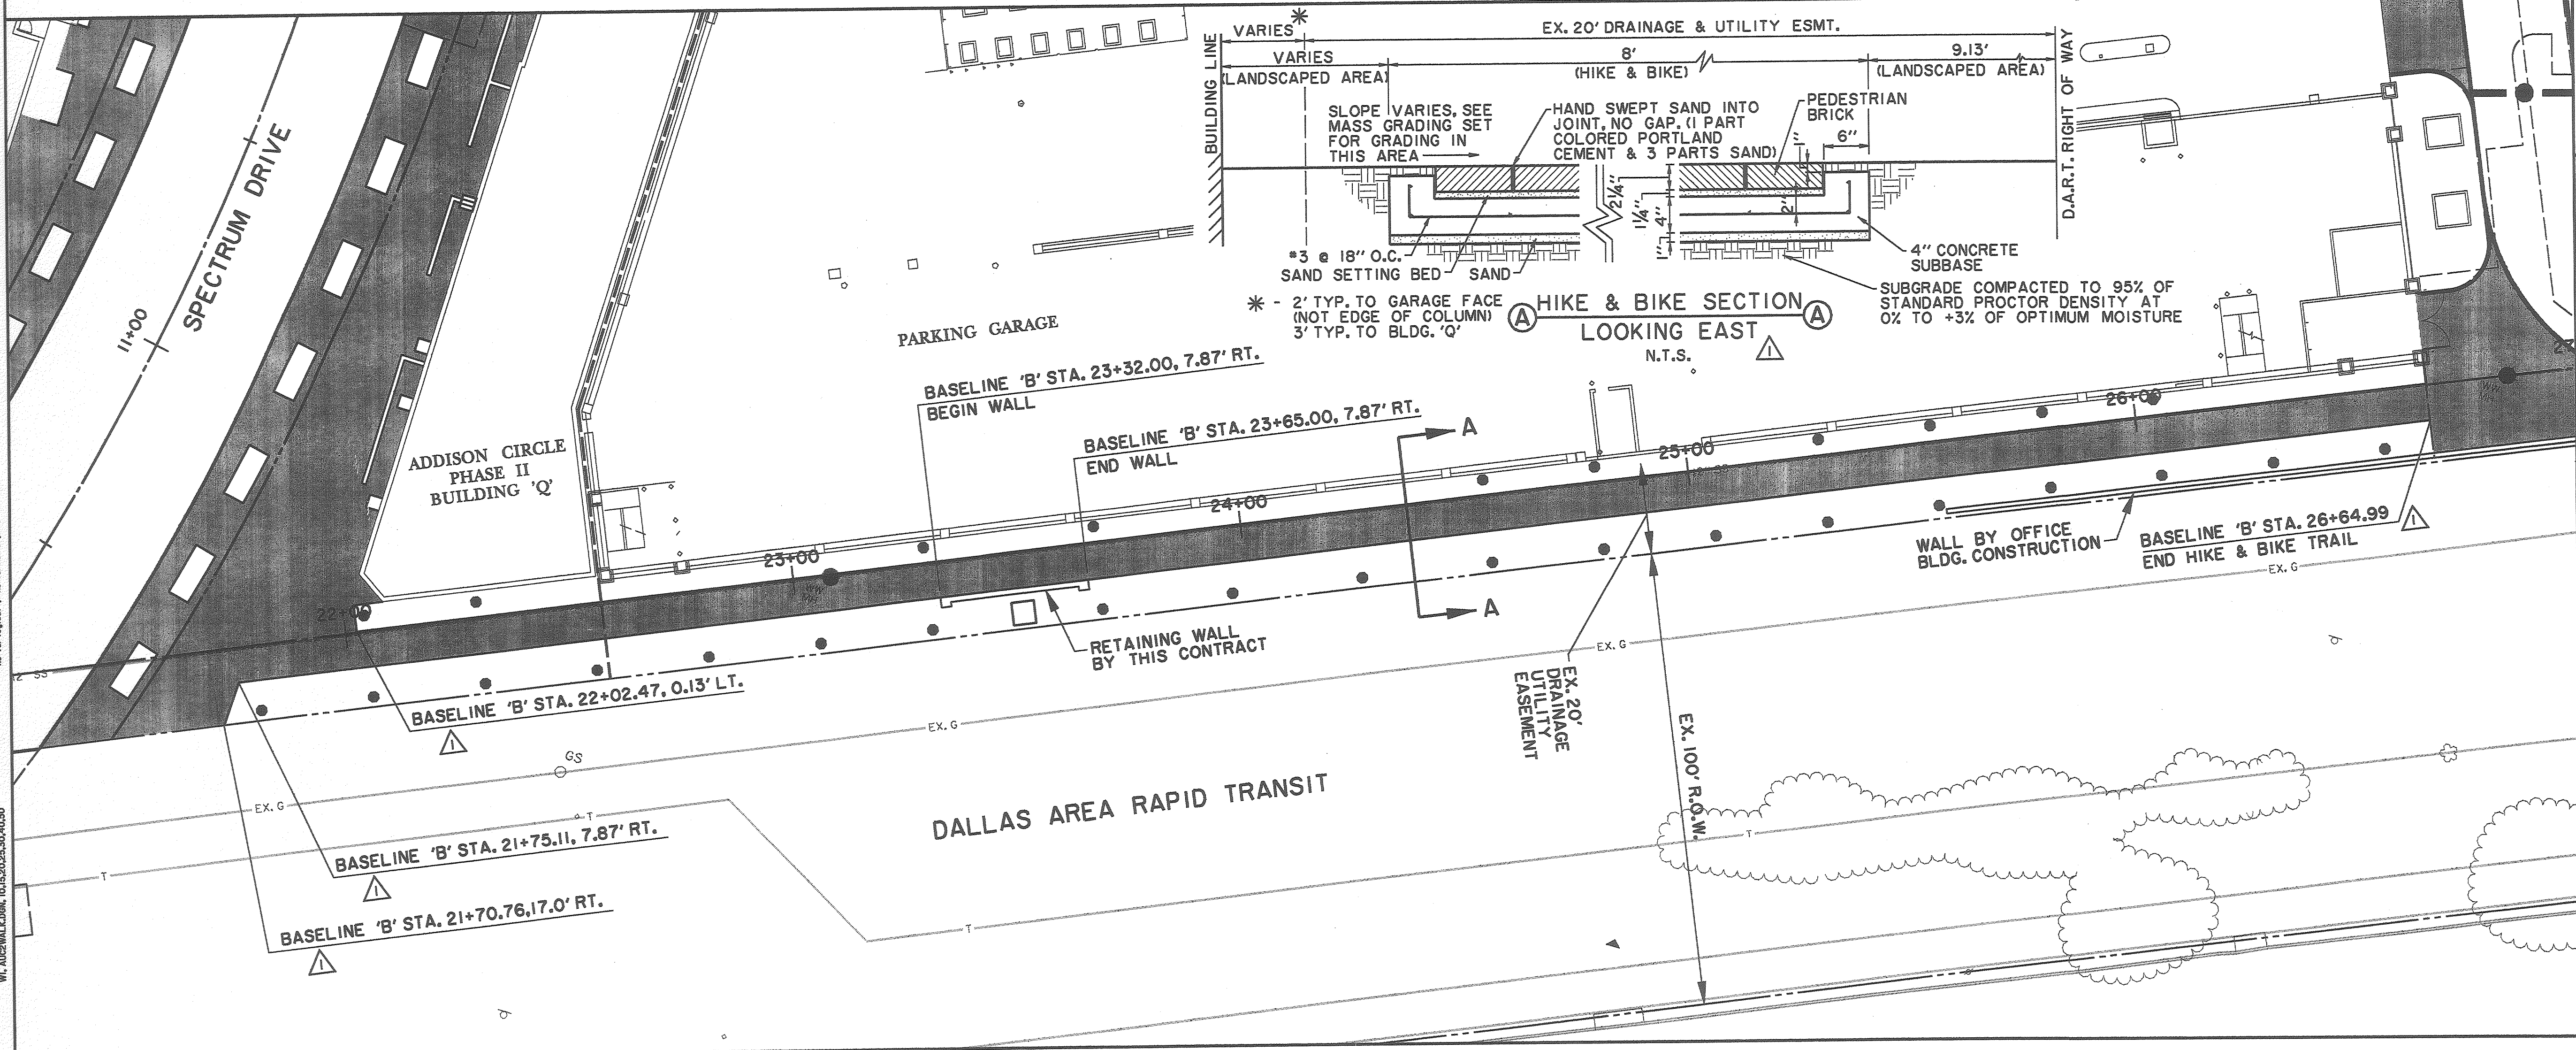

BENCHMARKS:

BM#1
"I" CUT AT CENTER BACK OF CURB OF INLET, 190 FEET SOUTH FROM THE CENTERLINE INTERSECTION OF ADDISON CIRCLE, WEST SIDE OF QUORUM DRIVE. ELEV. 621.89

BM#4
"I" CUT AT CENTER OF CURB INLET, 1015 FEET NORTH FROM THE CENTERLINE INTERSECTION OF ADDISON CIRCLE, WEST SIDE OF QUORUM DRIVE. ELEV. 629.36

THE SEAL APPEARING ON THIS DOCUMENT WAS AUTHORIZED BY DAVID E. MEYERS, P.E. 81512 ON

DATE	DESCRIPTION	REF. NO.
1/16/98	ADDED NOTES AND SECTION FOR HIKE & BIKE TRAIL	
10/3/97	ISSUED FOR CONSTRUCTION	N/A
7/14/97	ISSUED FOR BID	N/A

SURFACE PATTERNING PLAN
ADDISON CIRCLE 25+50 TO 28+00

ADDISON CIRCLE
PHASE II PUBLIC INFRASTRUCTURE
TOWN OF ADDISON, TEXAS

Huitt-Zollars, Inc./Engineering/Architecture
Dallas, Fort Worth, Houston, El Paso, Phoenix, Tustin, Ontario

DESIGN	DRAWN	APPR.	SCALE	DATE	PROJECT NO.	NO.
HZI	HZI	DEM	1"=20'	00N. 97	01-1822-21	SP4

IN TEXAS: 01182221\vgm\AUC25W03.DGN
