


NOTE:
CENTER TO CENTER TREE DIMENSIONS ARE MEASURED ALONG THE CENTERLINE OF THE STREET.

LEGEND

ELECTRIC	— OHE —	MISC.	— 48" RCP —
☆	LIGHT POLE	— EX. STORM SEWER —	
pp	POWER POLE	— CHAIN LINK FENCE —	
—	GUY WIRE	— WOOD FENCE —	
TEL	TELEPHONE	— EXISTING ASPHALT —	
MH	TELEPHONE MANHOLE	— EXISTING DIRT OR GRAVEL —	
TS	TELEPHONE PEDESTAL	— EX. CONCRETE —	
TS	TELEPHONE SIGN	— TREE/TREE LINE —	
GM	GAS METER	— EXISTING CURB —	
GS	GAS SIGN	— PROP. CURB —	
	LAND USE	— PROP. EDGE OF PAVEMENT NO CURB —	
R.R.	RAILROAD SIGN	— EX. PROPERTY LINE —	
SIGN	SIGN	— PROP. CENTERLINE —	
	SURVEY	— PROP. R.O.W. —	
I.R.	FOUND IRON ROD	— PROP. INLET —	
BENCH	BENCHMARK	— T.P. —	
W.W.	WASTEWATER	— T.C. —	
MH	WASTEWATER MANHOLE	— CR —	
CO	CLEANOUT	— EX. G —	
FH	FIRE HYDRANT	— EX. T.C. —	
M	METER	— B-20 —	
T	WATER VALVE	— BORING LOCATION —	
		— EXISTING BRICKS —	
		— PAVEMENT REMOVAL —	

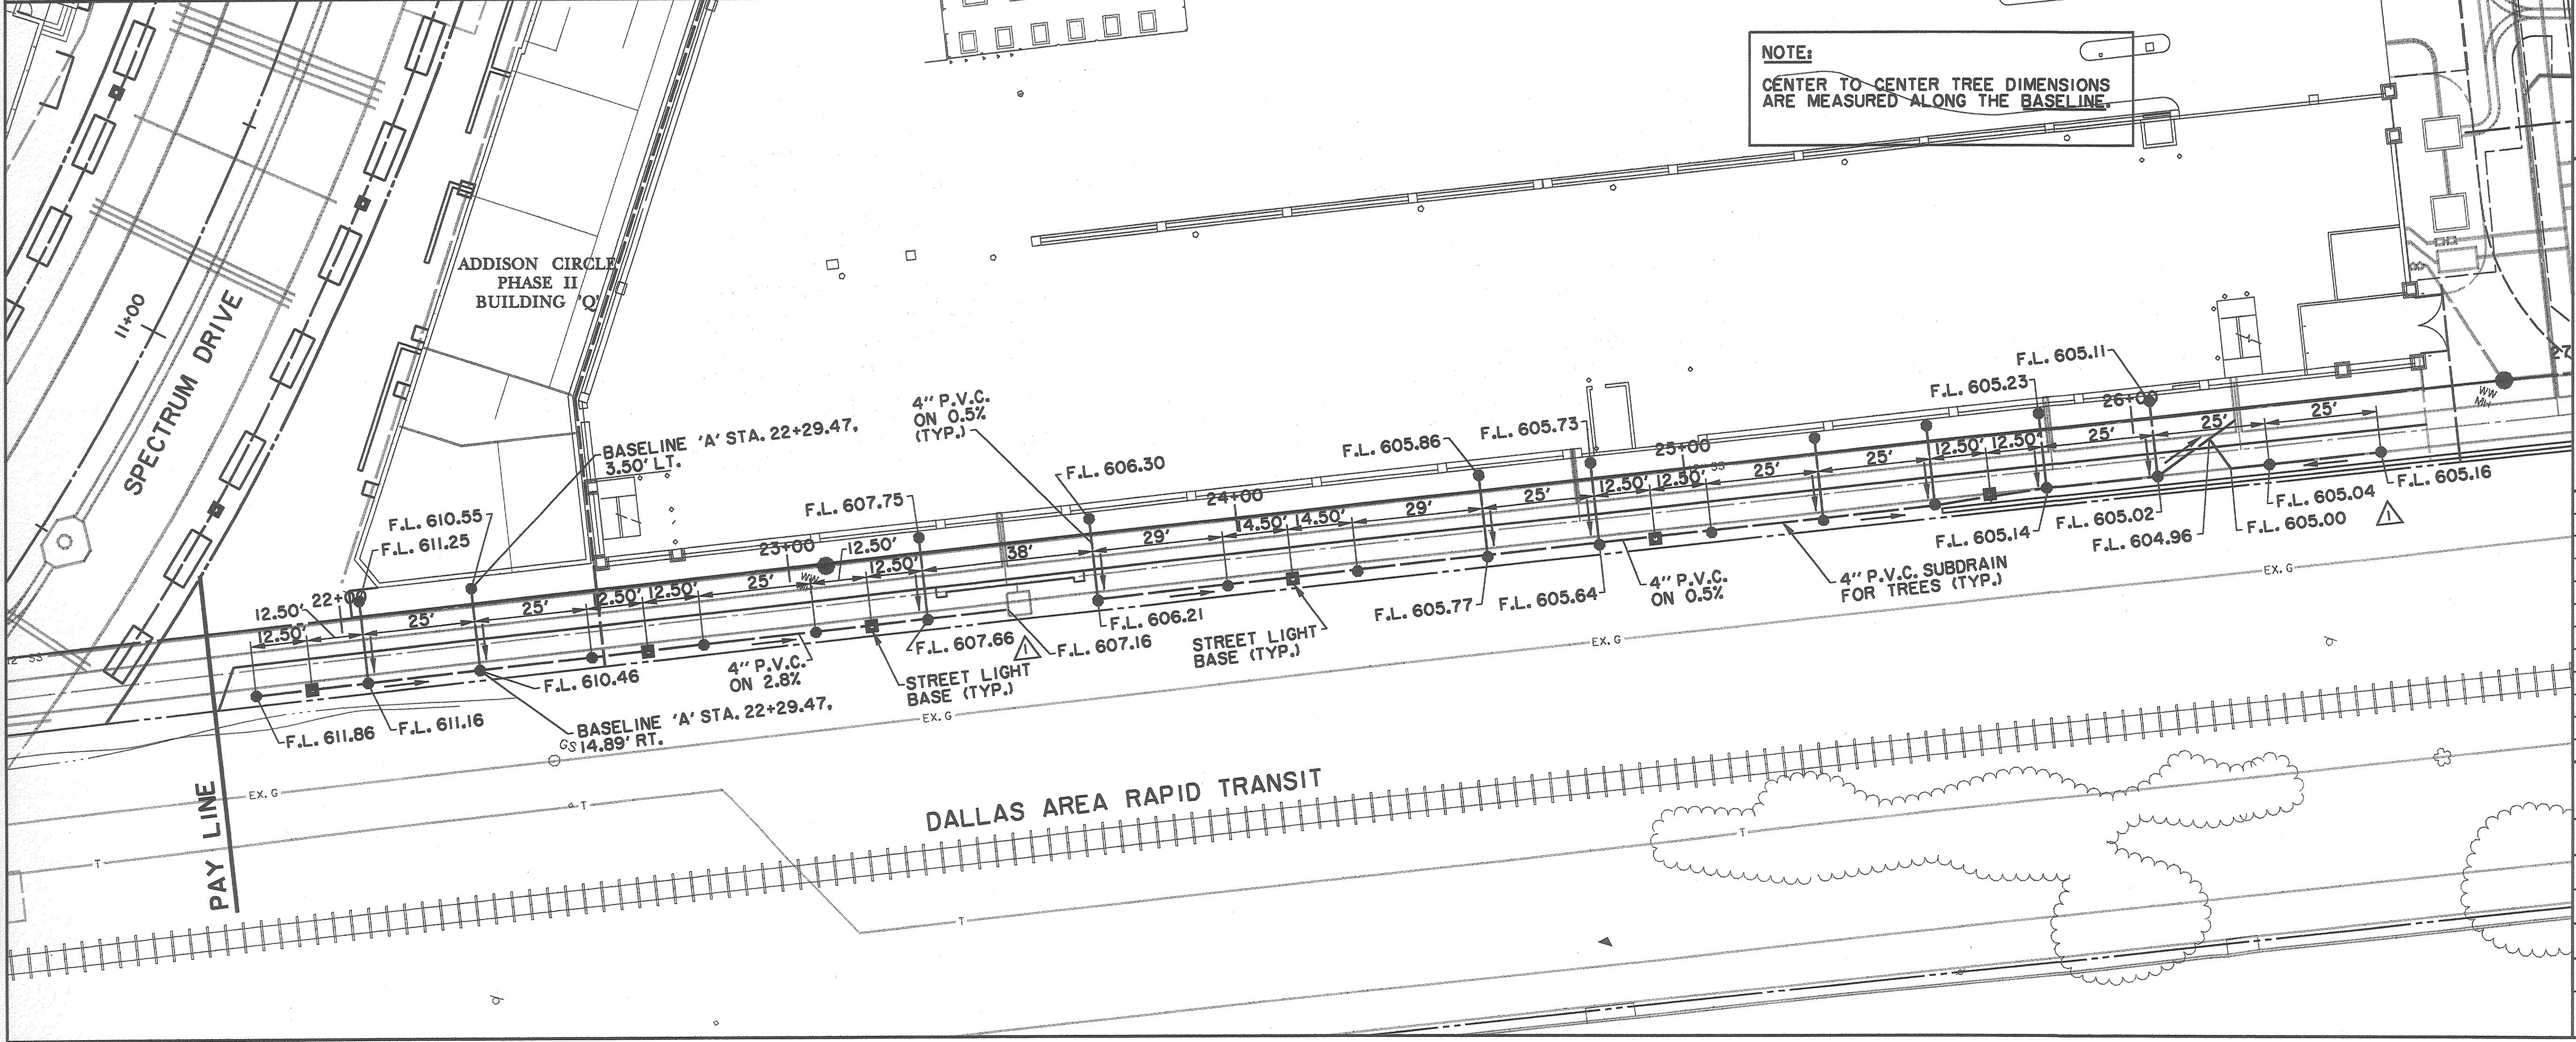

NOTE:
CENTER TO CENTER TREE DIMENSIONS ARE MEASURED ALONG THE BASELINE.

BENCHMARKS:

BM#5
T.C. CUT AT NORTHWEST CORNER OF NORTH HDWL. OF 7'X7' BOX CULVERT UNDER RAILROAD, ±180' WEST OF DALLAS PARKWAY SOUTHBOUND, ELEV. 610.49

BM#6
T.C. CUT AT CENTER FRONT OF 18" REC. INLET, SECOND INLET NORTH OF RAILROAD TRACKS ON THE WEST SIDE OF DALLAS PARKWAY SOUTHBOUND, ELEV. 605.67

THE SEAL APPEARING ON THIS DOCUMENT WAS AUTHORIZED BY DAVID E. MEYERS, P.E. 81512 ON 11/21/98

DATE	DESCRIPTION	REF. NO.
1/12/98	REVISED FLOWLINES, TREE AND LIGHT SPACING REMOVED TREE	▲
10/3/97	ISSUED FOR CONSTRUCTION	N/A
7/14/97	ISSUED FOR BID	N/A

**STREETSCAPE PLAN
ADDISON CIRCLE / HIKE & BIKE
ADDISON CIRCLE
PHASE II PUBLIC INFRASTRUCTURE
TOWN OF ADDISON, TEXAS**

Hullt-Zollars, Inc./Engineering/Architecture
Dallas, Fort Worth, Houston, El Paso, Phoenix, Austin, Ontario

DESIGN	DRAWN	APPR.	SCALE	DATE	PROJECT NO.	NO.
HZ1	HZ1	DEM	1"=20'	00R. 97	01-1822-21	ST5

TS: AUGUST 1998 - 18, 20, 22,3524