

ADDISON ROAD

NOT IN CONTRACT

TOWN OF ADDISON
CONFERENCE &
THEATRE CENTRE

TOWN OF ADDISON
FUTURE PARKING

AVIS

BARCO MIRROR & GLASS

MEIER
VALUE
CENTER

BENT
TREE
AUTO

REGENCY

AUTO
HAUS

WATER
TOWER

PROP.
R.O.W.
(VARIABLE)

MORRIS AVENUE

ADDISON CIRCLE
PHASE III
BUILDING "3B"

COURTYARD

RESIDENT
PARKING GARAGE
5 LEVELS

ADDISON CIRCLE
PHASE III
BUILDING "3B"

PRIVATE FIRE LANE

FUTURE
DEVELOPMENT

18+00

19+00

20+00

21+00

22+00

23+00

24+00

25+00

ARTIST WAY

U.S.
POST OFFICE

ADDISON CIRCLE
PHASE I
EXISTING
BUILDING "B"

WITT PLACE

EXISTING
BOSQUE PARK

COURTYARD

ADDISON CIRCLE
PHASE III
BUILDING "3A"

18+00

19+00

20+00

EX. 12'

EX. 12'

EX. 61' R.O.W.

ADDISON CIRCLE
PHASE I
EXISTING
BUILDING "C"

EX. 61' R.O.W.

EX. 12' B-B

FUTURE
PARK


FUTURE
DEVELOPMENT

FUTURE MEWS

FUTURE RESIDENTIAL STREET (R-1)

**RECORD
DRAWING**

THE SEAL APPEARING ON THIS
DOCUMENT WAS AUTHORIZED BY
DAVID E. MEYERS, P.E. 81512

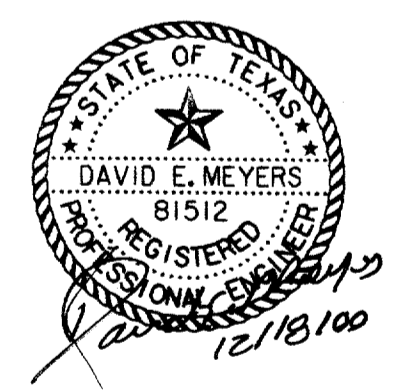

LEGEND:

- EXIST. CURB
- PROP. CURB
- - - FUTURE CURB

DATE	DESCRIPTION	REF. NO.
6/23/99	ISSUED FOR CONSTRUCTION	N/A
5/17/99	ISSUED FOR BID	N/A

PAVING & STREETScape SITE PLAN
ADDISON CIRCLE
PHASE II-B PUBLIC INFRASTRUCTURE
TOWN OF ADDISON, TEXAS

Hull - Zoltera, Inc.
3131 McKinney Ave., Suite 600, Dallas, TX 75204
Phone: (214) 871-3311/Fax: (214) 871-0757

DESIGN	DRAWN	APPR.	SCALE	DATE	PROJECT NO.	NO.
HZI	HZI	DEM	1"=50'	MAR. 99	01-1822-50	P5

PL: 01182250.dgn/AUC3SP02.DGN

