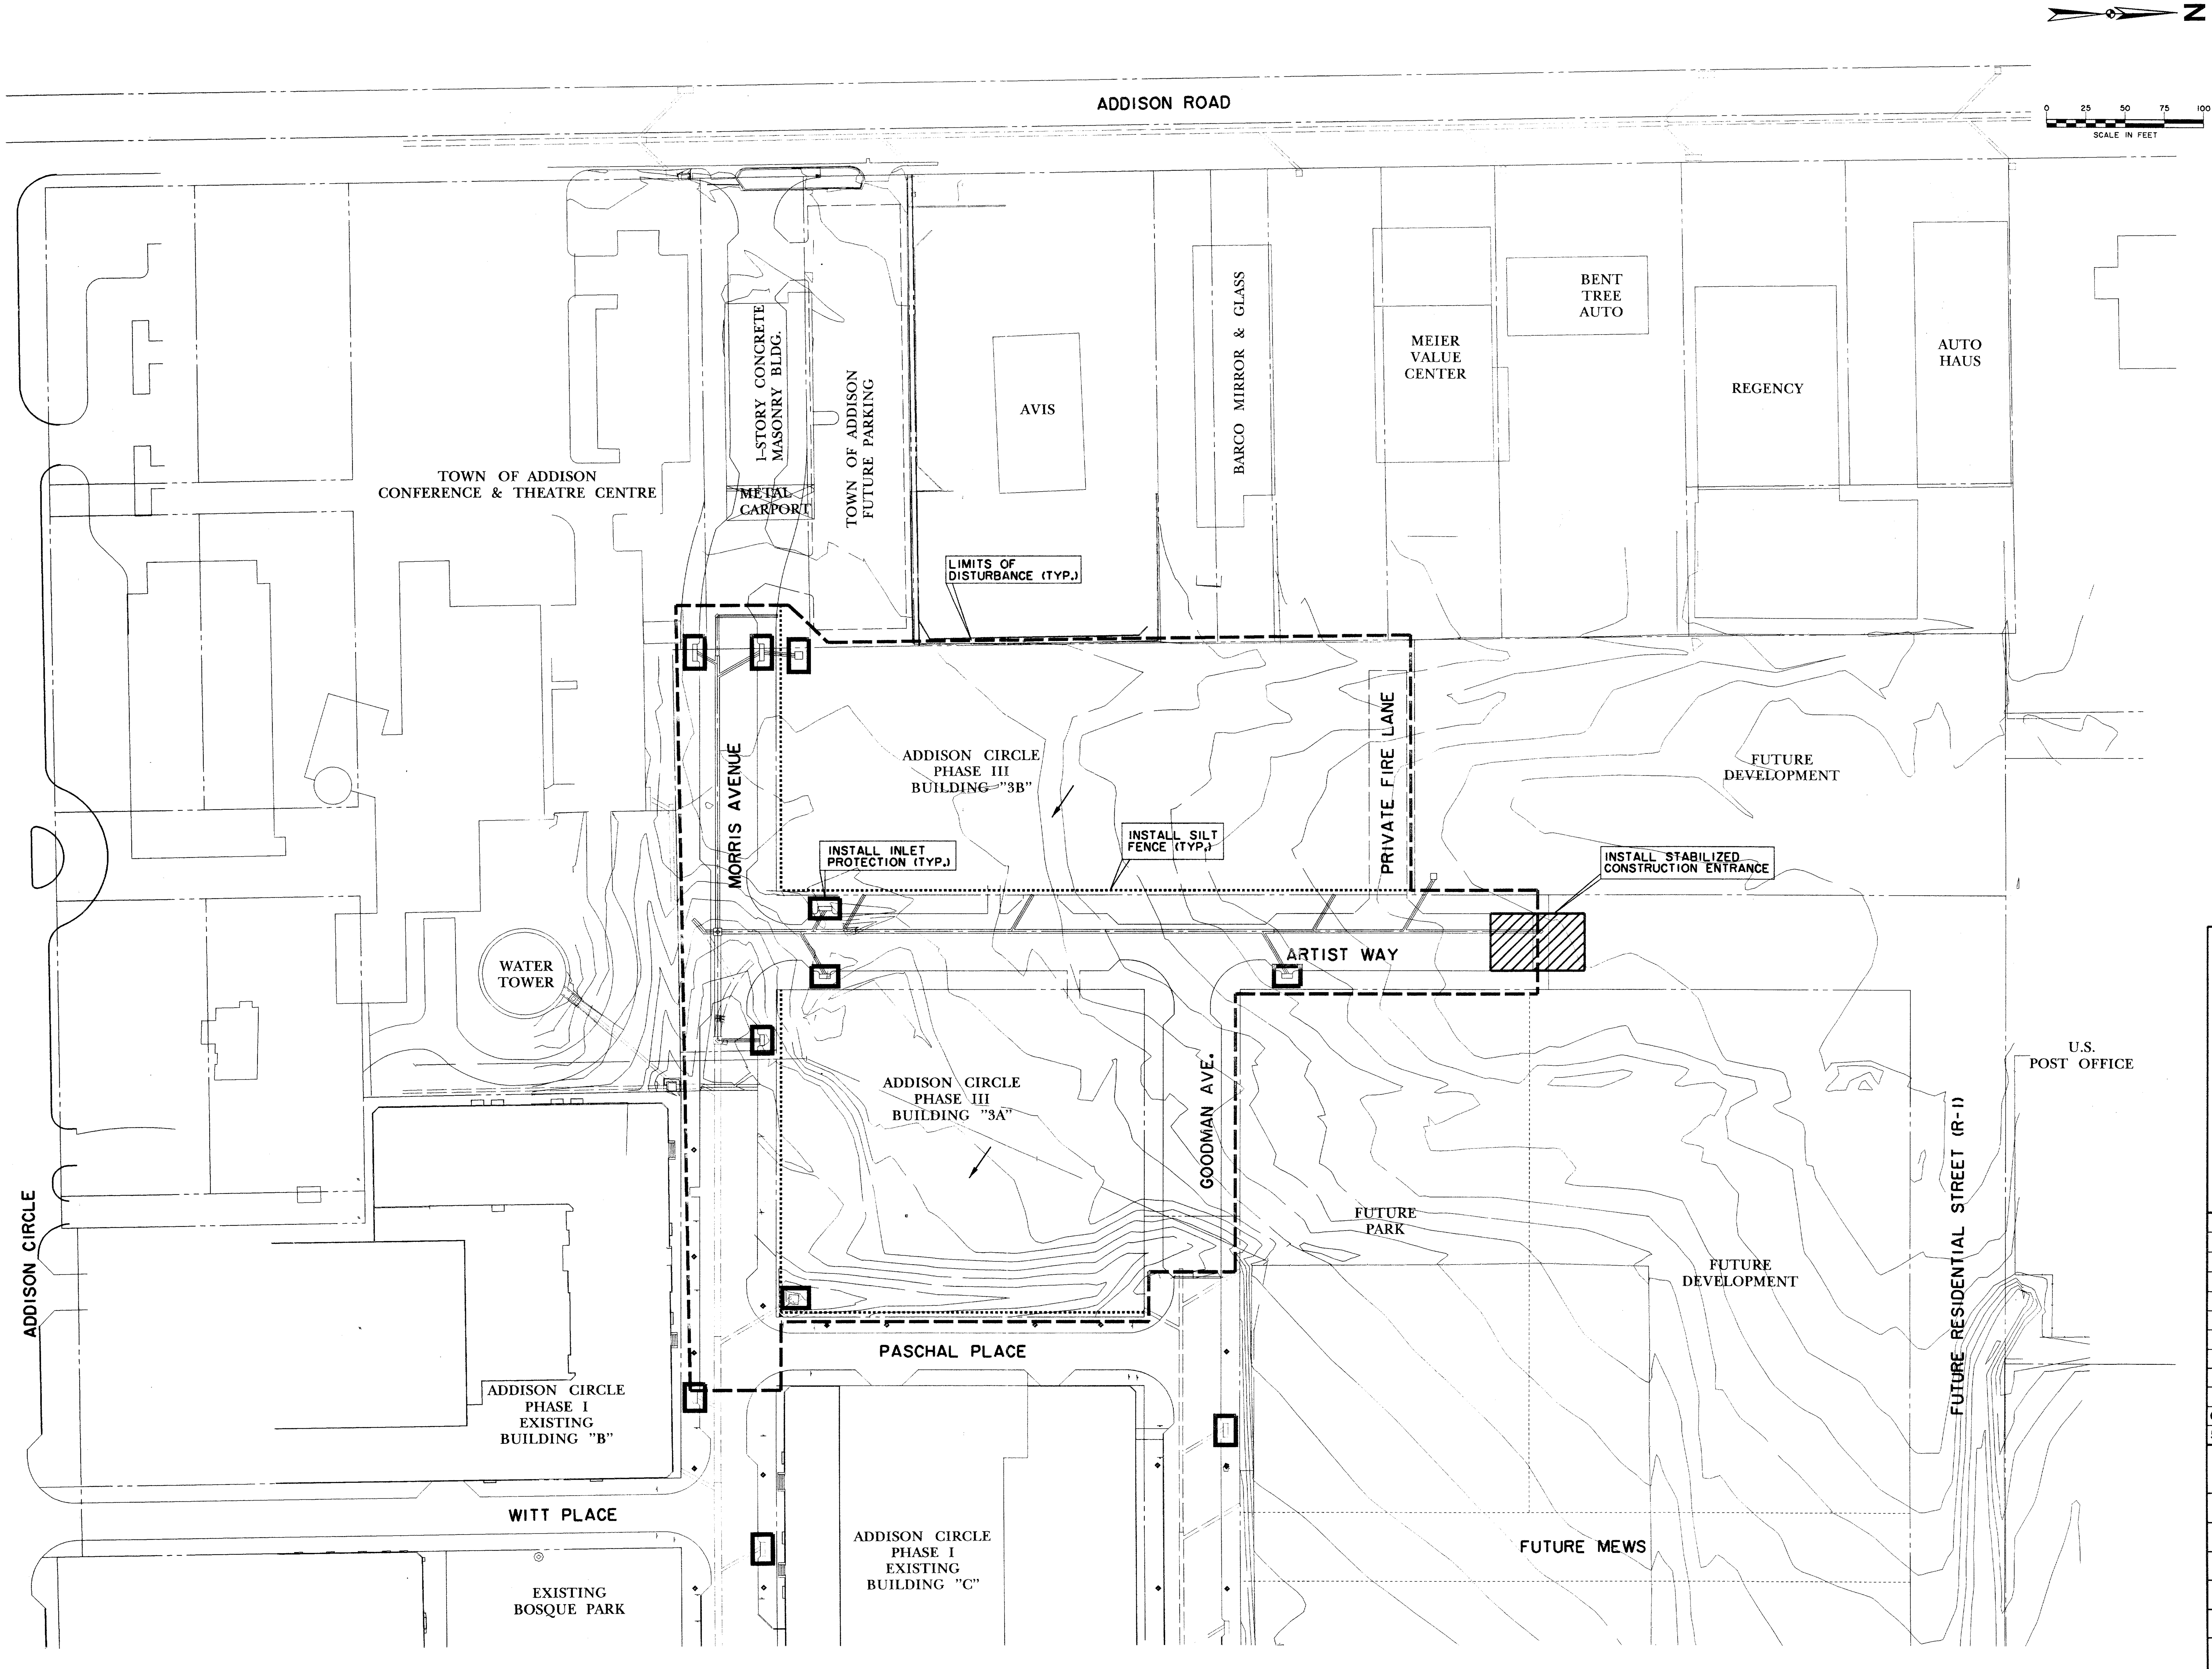

AREA OF DISTURBANCE
4.33 ACRES

NOTES:

1. SEE DRAINAGE AREA MAP FOR DRAINAGE AREAS AND CALCULATIONS.
2. SEE POLLUTION CONTROL DETAILS FOR TYPES OF INLET PROTECTION.

LEGEND:

- SILT FENCE
- INLET PROTECTION
- EXISTING CONTOURS
- DIRECTION OF RUNOFF
- LIMITS OF DISTURBANCE
- STABILIZED CONSTRUCTION ENTRANCE/EXIT

RECORD DRAWING

BENCHMARKS:

BM#5
"□" CUT ON 8' INLET ON NORTH CURB LINE OF GOODMAN AVE. ±75' EAST OF PASCHAL PLACE.
ELEV. 629.98

BM#6
"□" CUT AT ℄ OF 8' INLET AT THE SOUTHWEST CORNER OF MORRIS AVE. AND WITT PLACE.
ELEV. 627.29

BM#7
"□" CUT AT WEST CORNER OF ADDISON THEATRE CENTRE PARKING LOT, SECOND ENTRANCE NORTH OF ADDISON RD.
ELEV. 637.66

THE SEAL APPEARING ON THIS DOCUMENT WAS AUTHORIZED BY DAVID E. MEYERS, P.E. 81512

STATE OF TEXAS
DAVID E. MEYERS
81512
REGISTERED
PROFESSIONAL ENGINEER
12/8/00

DATE	DESCRIPTION	REF NO.
6/23/99	ISSUED FOR CONSTRUCTION	N/A
5/17/99	ISSUED FOR BID	N/A

POLLUTION CONTROL PLAN

ADDISON CIRCLE

PHASE II-B PUBLIC INFRASTRUCTURE

TOWN OF ADDISON, TEXAS

Huitt - Zollars, Inc.
3131 Mckinney Ave., Suite 600, Dallas, TX 75204
Phone (214) 871-3311/Fax (214) 871-0757

DESIGN	DRAWN	APPR.	SCALE	DATE	PROJECT NO.	NO.
HZI	HZI	DEM	1"=50'	MAR. 99	01-1822-50	PC1

h:\proj\01182250\dgn\AUC3EC01.DGN

h:\proj\01182250\dgn\AUC3EC01.DGN
Fri Dec 8 14:30:24 2000
\\HZDALLAS2\DISKO\PLOTTING\400M\AUC3EC01.PRF
Huitt-Zollars, Inc.

PRF ROTATION=0.920000
F:\tbl\MILLER.TBL

no ref logical, *no ref name*, *no ref levels*
no ref logical, *no ref name*, *no ref levels*
no ref logical, *no ref name*, *no ref levels*
no ref logical, *no ref name*, *no ref levels*
no ref logical, *no ref name*, *no ref levels*
no ref logical, *no ref name*, *no ref levels*

T, AUC3TOPO.DGN, 1,11,12,16,17,21-29,31,51-53,56,57,60-62
U, AUC3UTIL.DGN, 41,43
TI, AUC3CONT.DGN, 5,11-13
P, AUC3BASE.DGN, 1-3,11,12,41,42,44
B, AUC3BD.DGN, 2,5,13,20,50,56,59-61