



TYPICAL ROOF

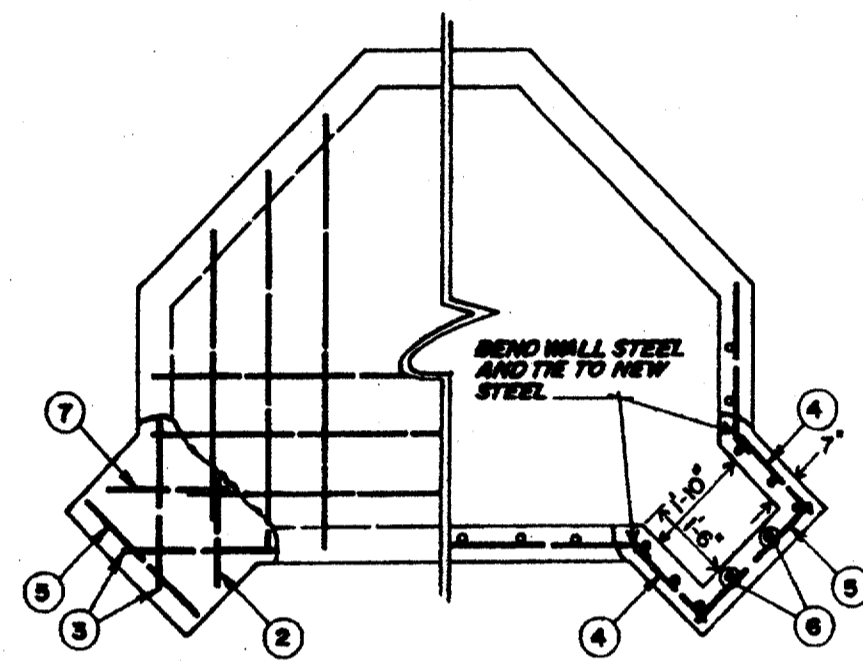

TYPICAL FLOOR / WALL

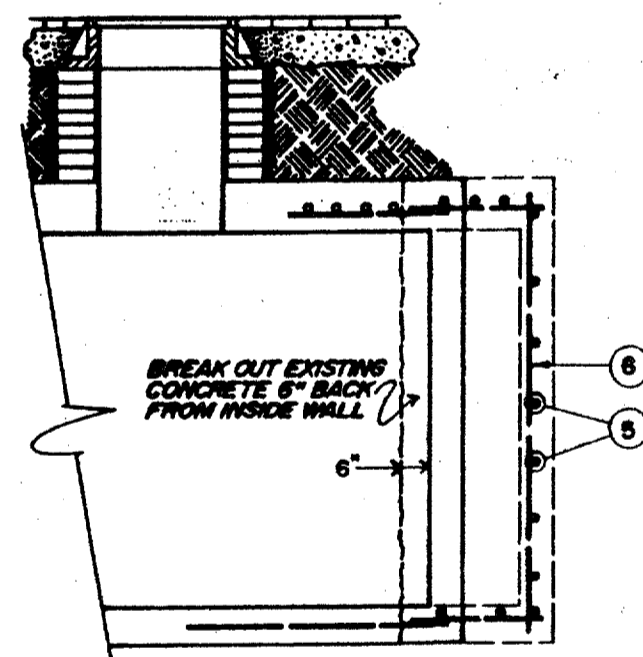


FLOOR / ROOF / WALL VIEW


ALL REINFORCING BARS #5						
ITEM	LENGTH			QUANTITY		
	FL.	HL.	FLOOR	WALLS	ROOF	TOTAL
1	2	9		4	4	
2	2	3	1		6	7
3	3	0	2			2
4	2	0	2	18	2	22
5	2	11	1	6	1	8
6	7	3		8		8
7	2	5	1			1

DEEP PANELS ON NEW OR EXISTING TYPE
"C" AND "B" - See Job Sketch


DETAIL #2

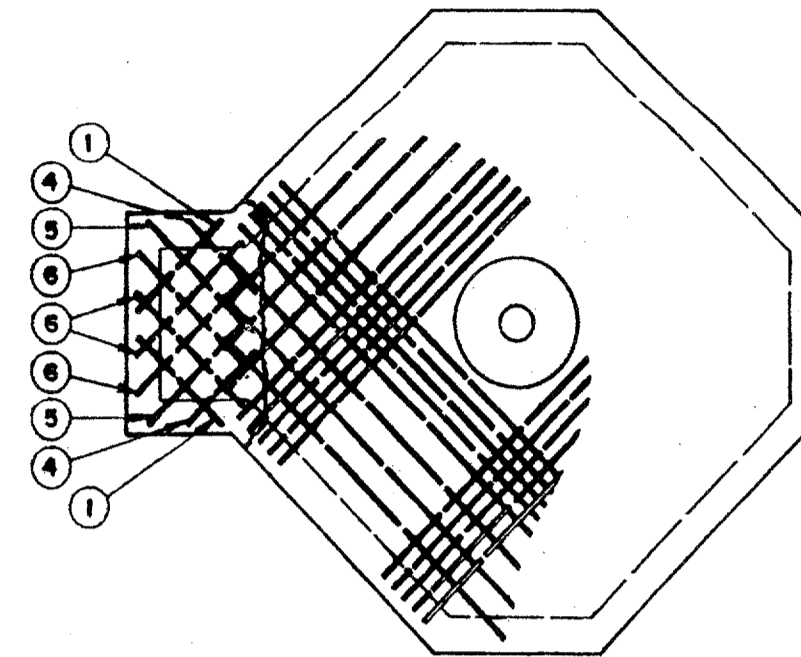

TYPICAL ROOF

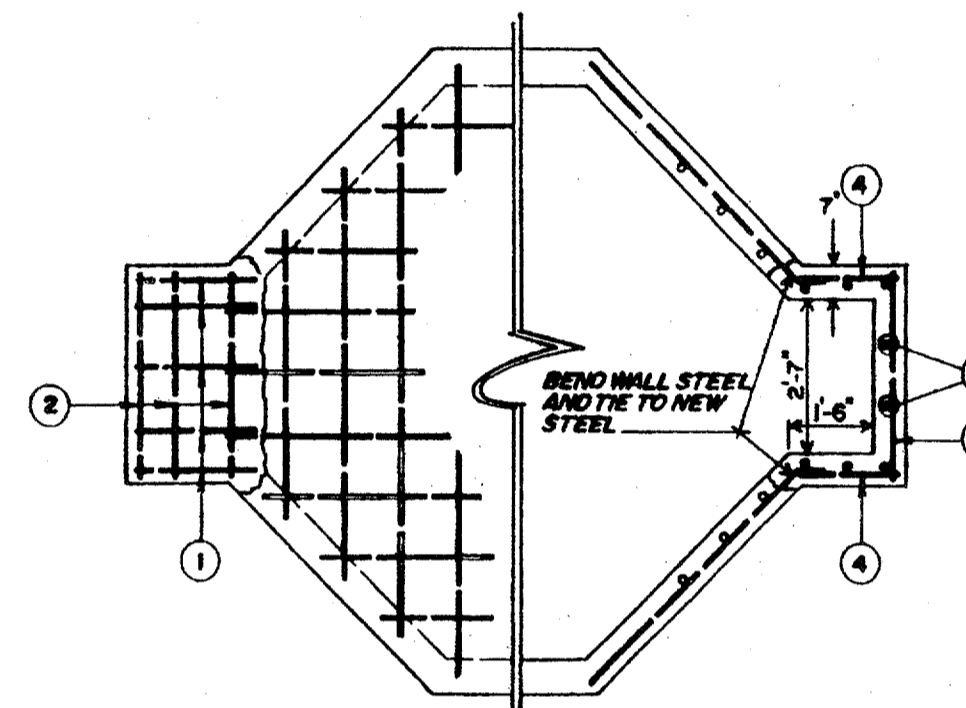

TYPICAL FLOOR / WALL

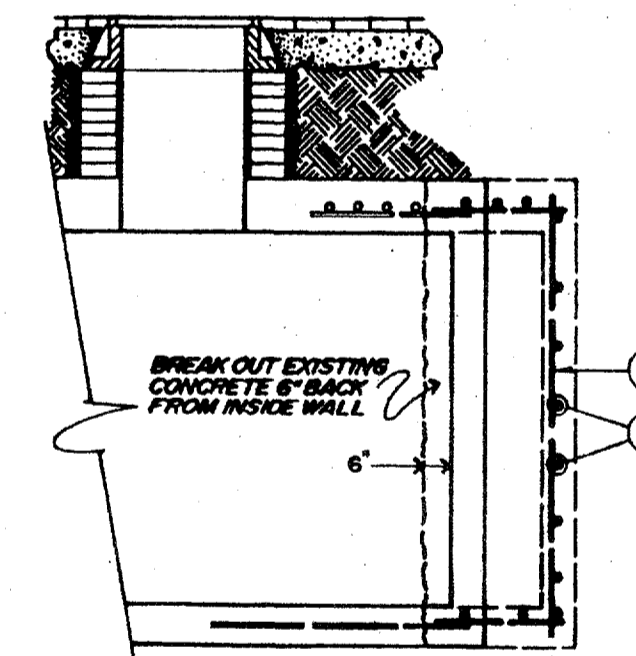

FLOOR / ROOF / WALL VIEW

ALL REINFORCING BARS #5						
ITEM	LENGTH			QUANTITY		
	FL.	HL.	FLOOR	WALLS	ROOF	TOTAL
1	2	3	5	2	7	
2	3	6	3	7	10	
3	7	3		8	8	
4	1	9		14	2	16
5	2	6			2	2
6	2	5		4	4	

DEEP PANELS ON NEW OR EXISTING TYPE
"B", "C" AND "D" - See Job Sketch

RECORD
DRAWING

E13

TU ELECTRIC

SCALE (H=HO SCALE) (V=VO SCALE)	LIST OF DRAWINGS	W.A.	ESTIMATE	DWG TYPE	UNIT ID
SCALE (H=HO SCALE) (V=VO SCALE)	NETWORK UNDERGROUND APPURTENANCE SHEETS MISCELLANEOUS DETAILS	W.A.	ESTIMATE	DWG TYPE	UNIT ID
DATE 05-12-92	APP. JES	W.A. NO.	DATE	REVISION DESCRIPTION	DRAWN CH. APP. APP.
	ENG. JRC				
	CH. JRC				
	DWN. MED				
	APP. PRN				

E-NUA-1
SHEET NO. 9