

LIST OF ABBREVIATIONS


at	at	PAR.	Parabolic
A	Area	P.C.	Point of Curvature
B-B	Back to Back	P.F.	Partial Flow
B.M.	Bench Mark	P.I.	Point of Intersection
B.T.M.	Bottom	P.R.C.	Point of Reverse Curvature
B.W.	Bottom of wall	PAV.	paving
C	Capacity or Runoff Coefficient	PP	Power Pole
C.C.	Center to Center	PROP.	Proposed
C.C.R.	Curb Return	P.T.	Point of Tangency
CATV	Cable TV	PB	pull Box
CD	Chord Distance	P.V.I.	Point of Vertical Intersection
CL	Centerline	P.V.C.	Point of Vertical Curvature
CLR.	Clear	P.V.R.C.	Point of Vertical Reverse Curvature
Conc.	Concrete	P.V.M.T.	pavement
CONST.	Construct	P.V.T.	Point of Vertical Tangency
DIA.	Diameter	Q100	100 year flow
DB	Direct Bury	R	Radius
E	East	REINF.	Reinforced
E.P.	Edge of Pavement	REC.	Recessed
E.O.	Equal	RCP	Reinforced Concrete Pipe
F	Existing	RCCP	Reinforced Concrete Cylinder Pipe
F.F.	Finished Floor	R.O.W.	Right of Way
F.L.	Flowline	RR	Railroad
F.H.	Fire Hydrant	RT.	Right
GM	Gas Meter	S	Slope or South
H.G.	Hydraulic Gradient	SCH.	schedule
H.V.	Velocity Head	SS	sanitary Sewer
I.R.	Iron Rod	STD.	standard
I.R.F.	Iron Rod Found	STA.	station
I.R.S.	Iron Rod Set	STAB.	stabilized
I100	100 Year Intensity	SW	storm Water
L	Length	SWBT	Southwestern Bell Telephone
L.F.	Linear Feet	T	Tangent
LAT.	Lateral	T.C.	Top of Curb
LT.	Left	Tc	Time of Concentration
M	Mid-ordinate	T.P.	Top of Pavement
MAX.	Maximum	T.W.	Top of Wall
M.J.	Mechanical Joint	Typ.	Typical
MH	Manhole or Metal Halide	V	Velocity
MIN.	Minimum	VP	Partial Flow Velocity
MOD.	Modified	V.C.	Vertical Curve
N	North	W	West
NA	Not Applicable	W/	with
N.T.S.	Not to Scale	WM	Water Meter
O.C.	On Center	W	Water
O.C.E.W.	On Center Each Way	WW	Waste Water
O.D.	Outside Diameter	Δ	Angle of Deflection

LEGEND

ELECTRIC — OHE —	MISC.
○ LIGHT POLE	48" RCP
PP POWER POLE	EX. STORM SEWER
← GUY WIRE	CHAIN LINK FENCE
TELEPHONE — T —	WOOD FENCE
TELE MH ● TELEPHONE MANHOLE	EXISTING ASPHALT
▣ TELEPHONE PEDESTAL	EXISTING DIRT OR GRAVEL
TS TELEPHONE SIGN	EX. CONCRETE
GAS — G —	TREE/TREE LINE
GM GAS METER	EXISTING CURB
GS GAS SIGN	PROP. CURB
LAND USE	PROP. EDGE OF PAVEMENT NO CURB
R.R. RAILROAD SIGN	EX. PROPERTY LINE
▽ SIGN	PROP. CENTERLINE
SURVEY	PROP. R.O.W.
I.R. FOUND IRON ROD	PROP. INLET
▣ BENCHMARK	T.P. TOP OF PAVEMENT
WASTEWATER — WW —	T.C. TOP OF CURB
WW MH ● WASTEWATER MANHOLE	CR CURB RETURN
CO CLEANOUT	EX. G EXISTING GUTTER
WATER — W —	EX. T.C. EXISTING TOP OF CURB
FH ○ FIRE HYDRANT	B-20 BORING LOCATION
WM METER	EXISTING BRICKS
T WATER VALVE	PAVEMENT REMOVAL

**RECORD
DRAWING**

THE SEAL APPEARING ON THIS DOCUMENT WAS AUTHORIZED BY DAVID E. MEYERS, P.E. 81512

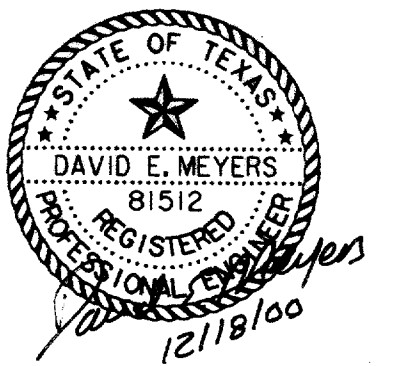

DATE	DESCRIPTION	REF NO.				
6/23/99	ISSUED FOR CONSTRUCTION	N/A				
5/17/99	ISSUED FOR BID	N/A				
LEGEND & ABBREVIATIONS						
ADDISON CIRCLE						
PHASE II-B PUBLIC INFRASTRUCTURE						
TOWN OF ADDISON, TEXAS						
<small>Hull - Zolters, Inc. 3131 McKinney Ave., Suite 600, Dallas, TX 75204 Phone (214) 871-3311/Fax (214) 871-0757</small>						
DESIGN	DRAWN	APPR.	SCALE	DATE	PROJECT NO.	NO.
HZI	HZI	DEM	N.T.S.	MAR. 99	01-1822-50	PI