


N

0 25 50 75 100
SCALE IN FEET

NOTE:
CONTRACTOR SHALL CONTACT ALL UTILITIES AND PRIVATE APARTMENT DEVELOPER TO INSURE THAT ALL NECESSARY SLEEVES ARE INSTALLED PRIOR TO PAVING.

NOTE:
MINIMUM COVER OF CONDUIT SLEEVES SHALL BE 2.5' FROM TOP OF CURB.

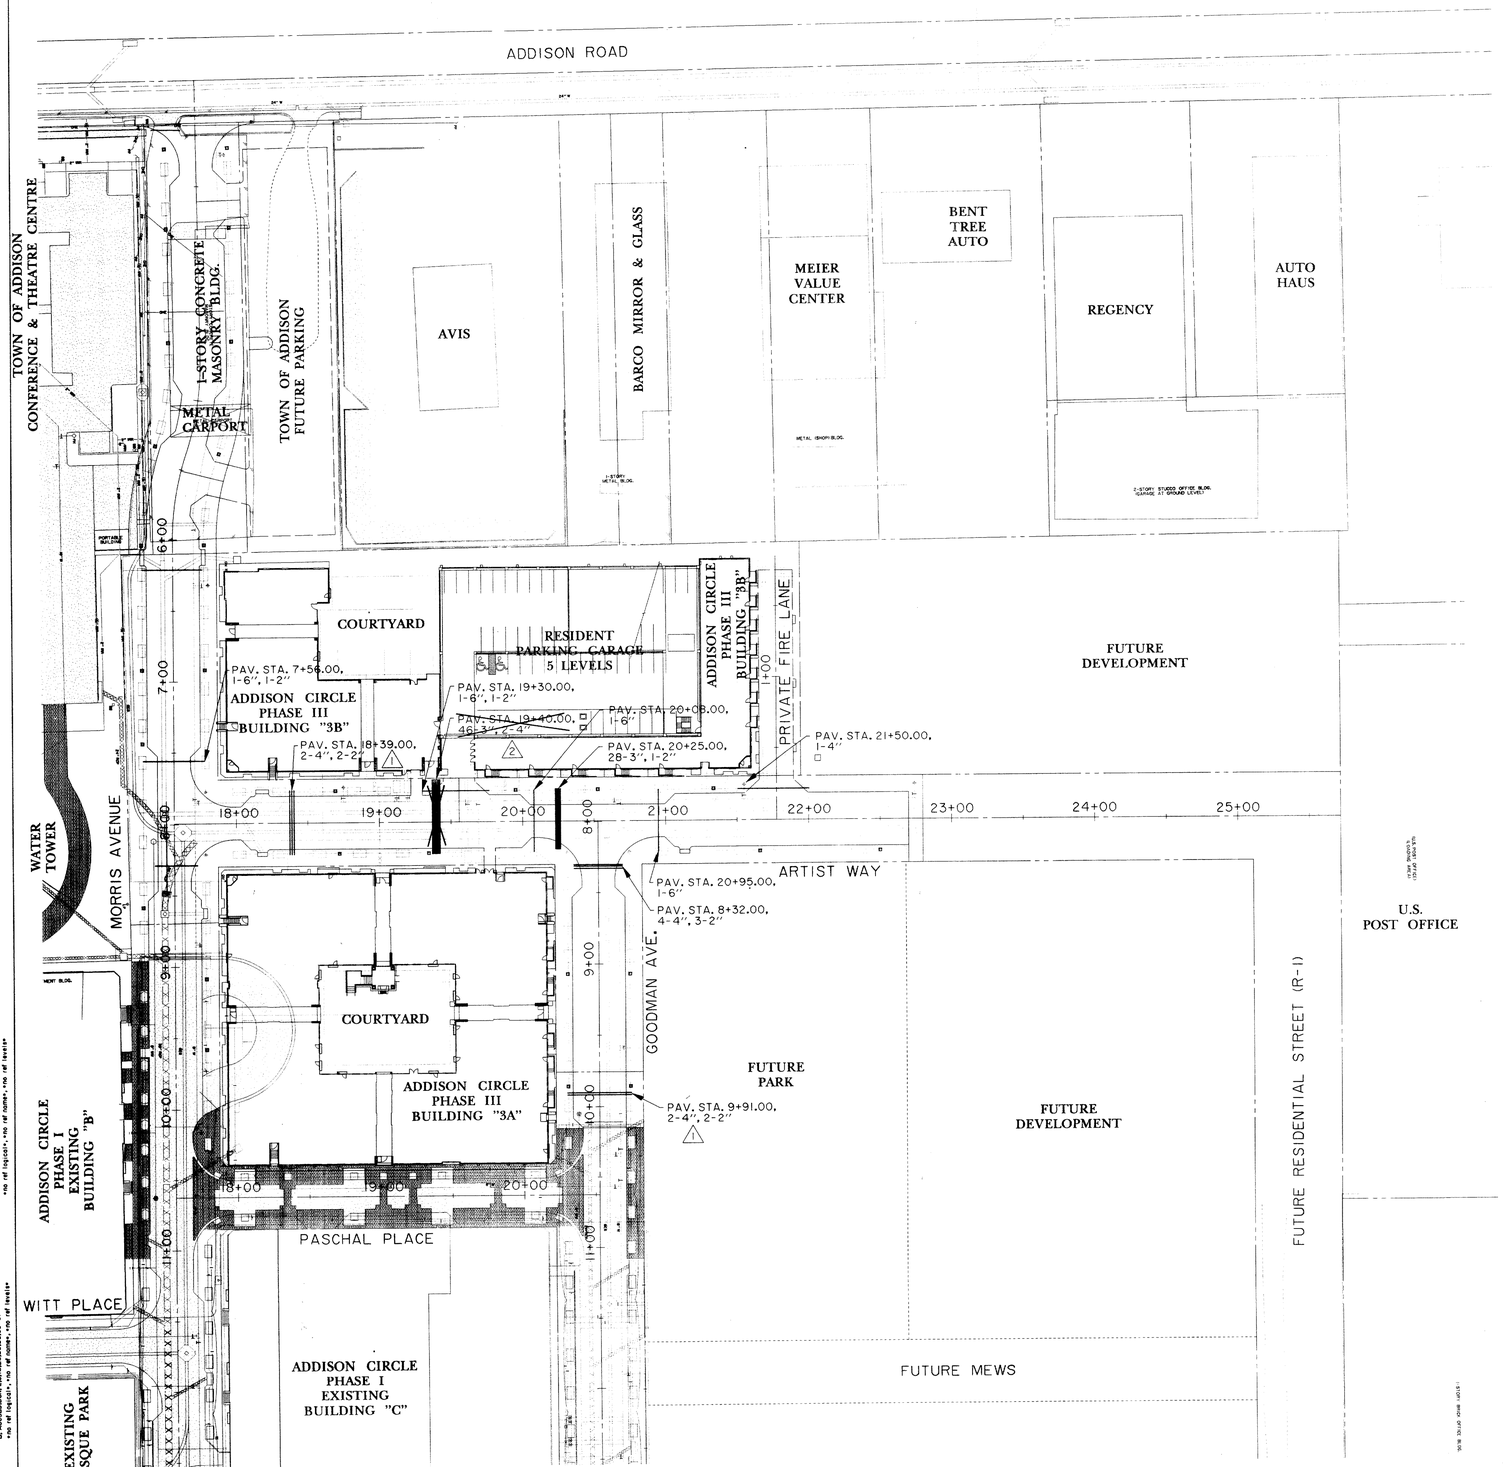


TYPICAL CONDUIT/SLEEVE EMBEDMENT
N.T.S.

# RECORD DRAWING

| STREET | STATION | SLEEVE SIZE AND USE |
|---|---|---|
| ARTIST WAY | 18+39.00 | 3-4" COMMUNICATION, 1-2" COMMUNICATION |
| ARTIST WAY | 19+30.00 | 1-6" IRRIGATION, 1-2" STREET LIGHT (UNDER DRIVE) |
| ~~ARTIST WAY~~ | ~~19+40.00~~ | ~~46-3" ELECTRICAL, 2-4" ELECTRICAL~~ |
| ARTIST WAY | 20+08.00 | 1-6" IRRIGATION |
| ARTIST WAY | 20+25.00 | 28-3" ELECTRICAL, 1-2" STREET LIGHT |
| ARTIST WAY | 20+95.00 | 1-6" IRRIGATION |
| ARTIST WAY | 21+50.00 | 1-4" IRRIGATION |
| GOODMAN AVE. | 8+32.00 | 4-4" COMMUNICATION, 2-2" COMMUNICATION, 1-2" STREET LIGHT |
| GOODMAN AVE. | 9+91.00 | 3-4" COMMUNICATION, 1-2" COMMUNICATION |
| MORRIS AVE. | 7+56.00 | 1-6" IRRIGATION |
| MORRIS AVE. | 7+56.00 | 1-2" STREET LIGHT |

BENCHMARKS:

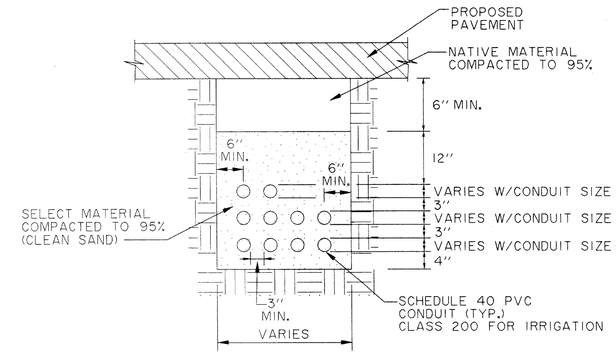BM#5
'□' CUT ON 8' INLET ON NORTH CURB LINE OF GOODMAN AVE. ±75' EAST OF PASCHAL PLACE.
ELEV. 629.98

BM#6
'□' CUT AT ℄ OF 8' INLET AT THE SOUTHWEST CORNER OF MORRIS AVE. AND WITT PLACE.
ELEV. 627.29

BM#7
'□' CUT AT WEST CORNER OF ADDISON THEATRE CENTRE PARKING LOT, SECOND ENTRANCE NORTH OF ADDISON RD.
ELEV. 637.66

THE SEAL APPEARING ON THIS DOCUMENT WAS AUTHORIZED BY DAVID E. MEYERS, P.E. 81512

STATE OF TEXAS
DAVID E. MEYERS
81512
REGISTERED
PROFESSIONAL ENGINEER
12/18/01

| DATE | DESCRIPTION | REF NO. |
|---|---|---|
| | | |
| | | |
| | | |
| | | |
| | | |
| | | |
| 11/23/99 | ITEMS DELETED FROM CONTRACT | 2 |
| 8/25/99 | SLEEVE REVISION TO MATCH REVISED PRIVATE COMMUNICATION | 1 |
| 6/23/99 | ISSUED FOR CONSTRUCTION | N/A |
| 5/17/99 | ISSUED FOR BID | N/A |

## SLEEVING PLAN

# ADDISON CIRCLE

## PHASE II-B PUBLIC INFRASTRUCTURE

## TOWN OF ADDISON, TEXAS


Hulitt - Zollars, Inc.
3131 Mckinney Ave., Suite 600, Dallas, TX 75204
Phone (214) 871-3311/Fax (214) 871-0757


| DESIGN | DRAWN | APPR. | SCALE | DATE | PROJECT NO. | NO. |
|---|---|---|---|---|---|---|
| HZI | HZI | DEM | 1"=50' | MAR. 99 | 01-1822-50 | P12 |

h:\proj\01182250\dgn\AUC3SV01.DGN


T: AUCSTGFOOON; 1-18,4,6,8,28,29,51-54,57,62
U: AUCSHADE.OON; 1-3,5,11-15,18,20,22-24,31,33,36,40-42,44,46-50,52
P: AUCSHADE.OON; 1-3,5,11-15,18,20,22-24,31,33,36,40-42,44,46-50,52
B: AUC3BD.OON; 25,13,25,50,56,59-61
PRF ROTATION=0.920000
FI:\BI\MILLER.TBL
h:\proj\01182250\dgn\AUC3SV01.DGN
Mon Jan 18 17:05:54 2000
I:\HZDALLAS2\DISK01\FILOTT\NG-405\MAUC3SV01.PRF
Hulitt-Zollars, Inc.